
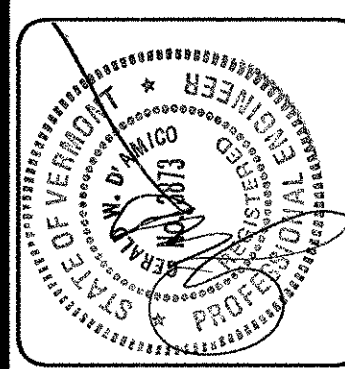


PARALLEL TAXIWAY "F" WEST PROFILE  
STA. 400+00 TO 414+00

**NOTE:**

TAXIWAY "G" WAS UNDER CONSTRUCTION BY THE AGENCY OF TRANSPORTATION IN THE FALL OF 2002. THE CENTERLINE ELEVATION OF TAXIWAY "G" STA. 312+40 IS BASED ON THE DESIGN GRADE FROM PLANS BY McFARLAND- JOHNSON, INC. CONTRACTOR TO VERIFY THE AS-BUILT ELEVATION OF THIS POINT PRIOR TO CONSTRUCTION. VARIATION FROM THE DESIGN GRADE MAY REQUIRE A MINOR CHANGE IN THE PROPOSED GRADES FROM TAXIWAY "F" (WEST).

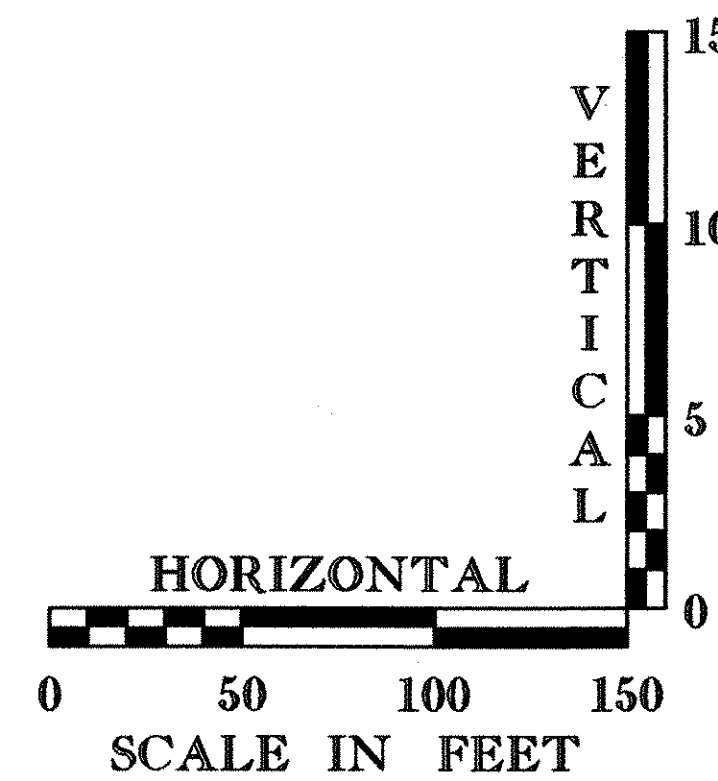

REV.	DATE	DESCRIPTION

Job No. F200002046.00  
File No F20204600E0

**RUTLAND STATE AIRPORT**  
CLARENDON, VERMONT

**TAXIWAY IMPROVEMENTS**  
PROFILES

**URS**  
1 NORTHWAY LN.  
LATHAM, NEW YORK

Designed by: G.W.D.  
Drawn by: M.H.  
Checked by: M.K.C.  
Approved by: G.W.D.

Scale: AS SHOWN  
Date: FEB., 2003  
Sheet 10 OF 40

Sheet No  
**10**

**PROJECT "A"**  
**A.I.P. 3-50-0015-17**