

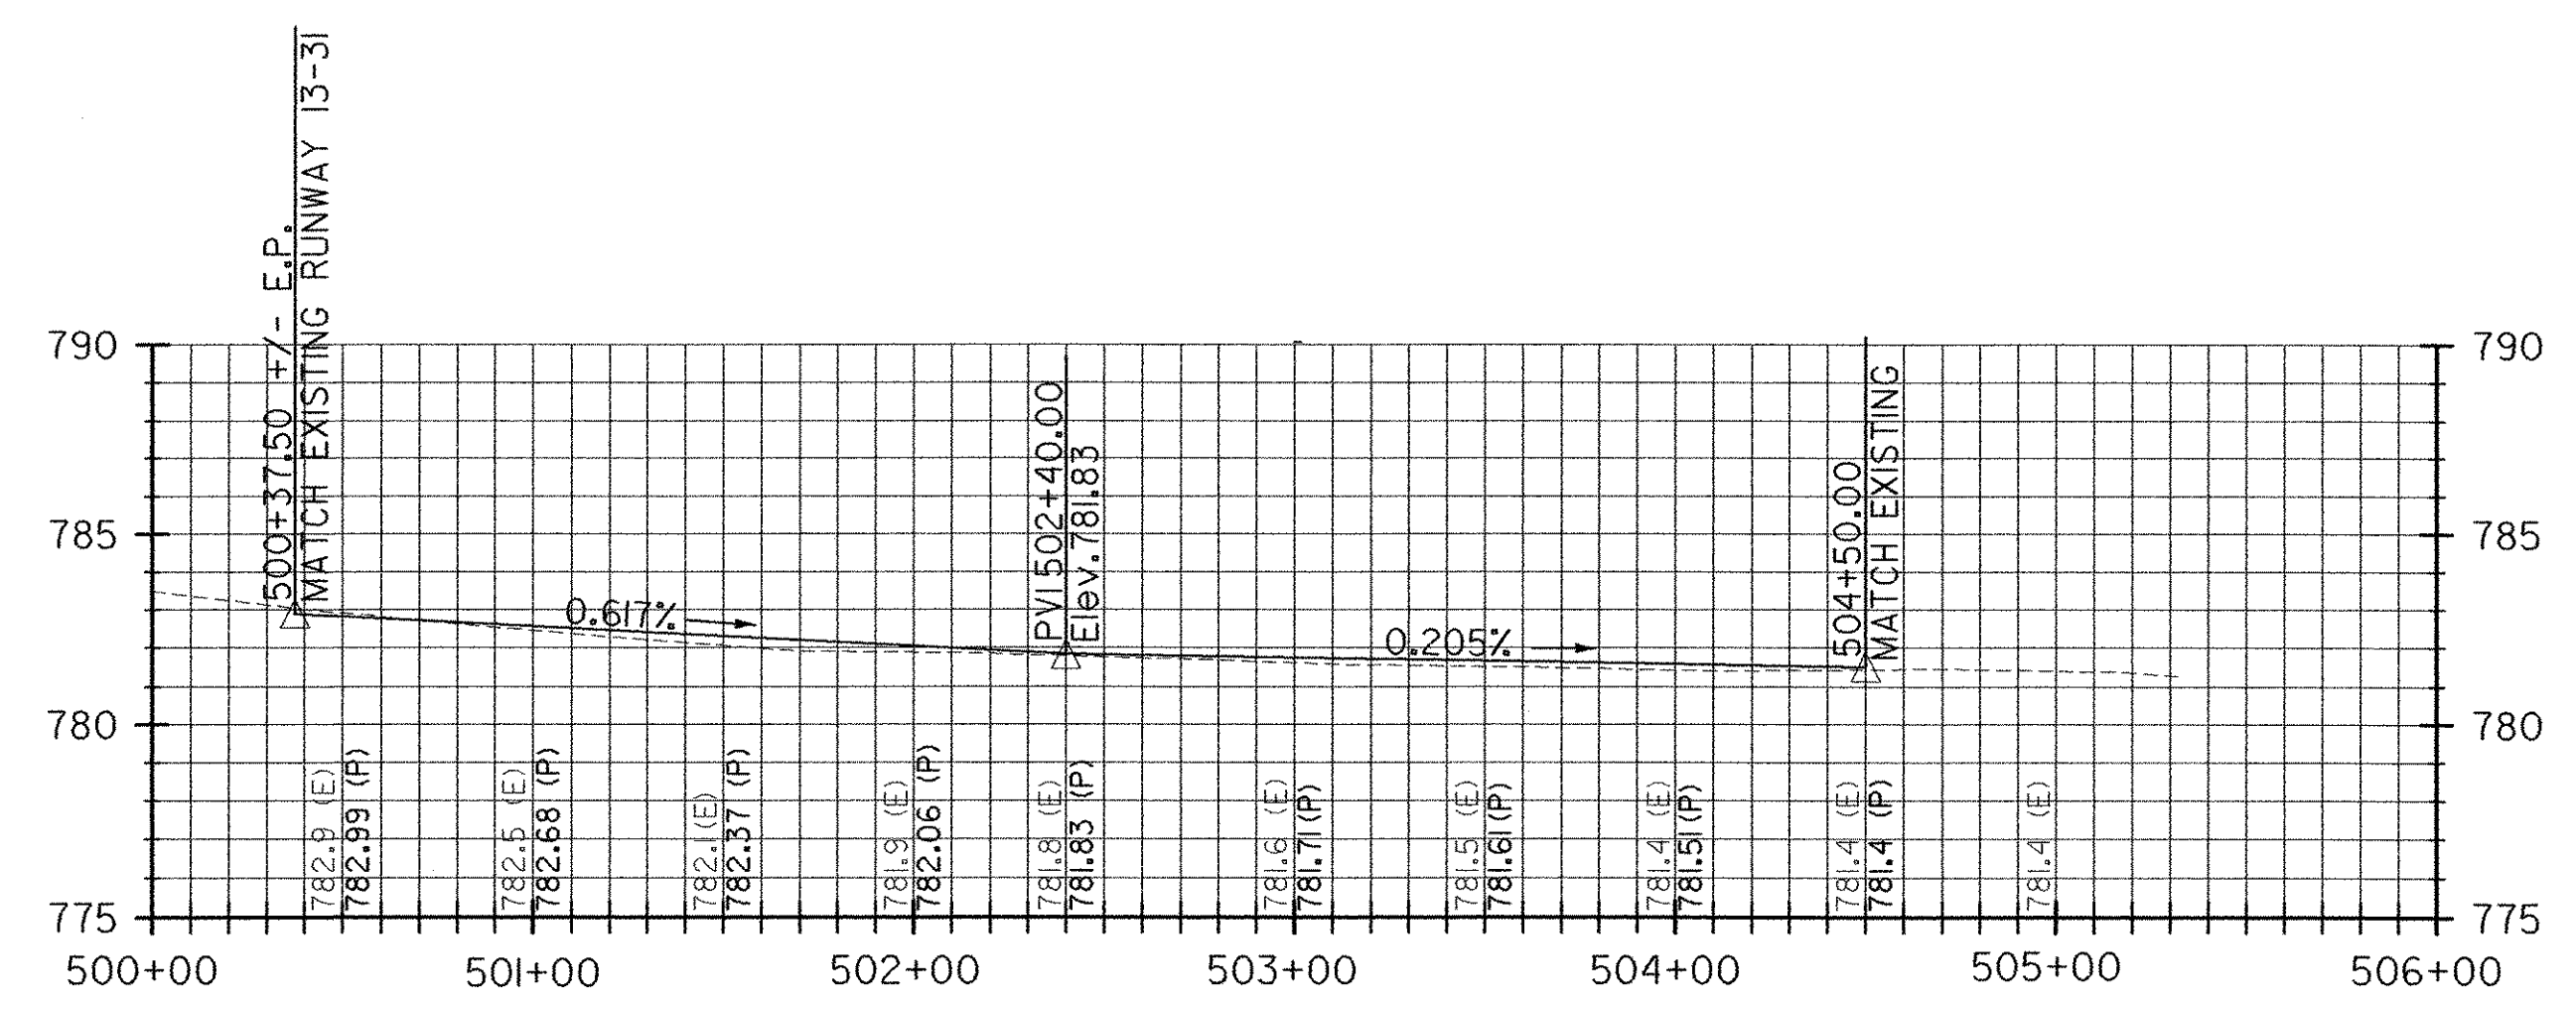


PARALLEL TAXIWAY "F" EAST PROFILE
STA. 414+00 TO 422+36.5

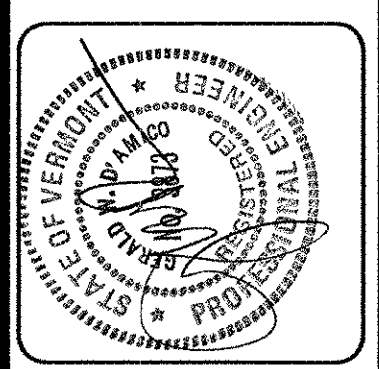

TAXIWAY "A" PROFILE
STA. 500+37.50 TO 505+00

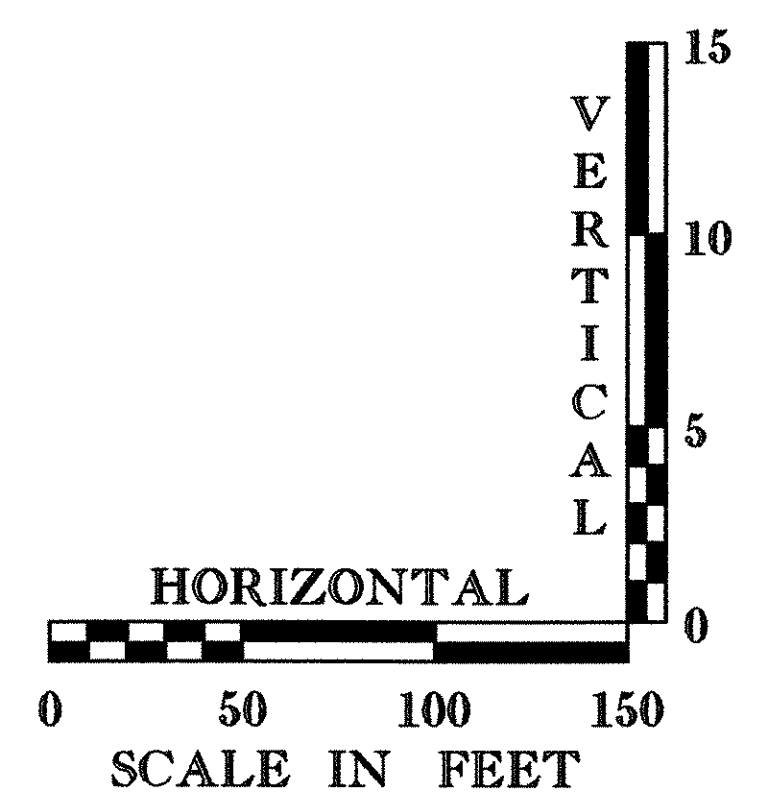

REV.	DATE	DESCRIPTION

Job No. F20002046.00 File No. F2020460IDEI

RUTLAND STATE AIRPORT
CLARENDON, VERMONT

TAXIWAY IMPROVEMENTS
PROFILES

URS
1 NORTHWAY LN.
LATHAM, NEW YORK

Designed by: G.M.D.
Drawn by: M.M.
Checked by: M.C.C.
Approved by: G.W.D.

Scale: AS SHOWN
Date: FEB., 2003
Sheet II OF 40

Sheet No
11

PROJECT "B"
A.I.P. 3-50-0015-17

F:\Civil\Sheet\012002\F2020460idei.dgn