

REV.	DATE	DESCRIPTION

RUTLAND STATE AIRPORT
CLARENDON, VERMONT


TAXIWAY IMPROVEMENTS
PAVING & GEOMETRIC LAYOUT

URS
1 NORTHWAY LN.
LATHAM, NEW YORK

Designed by: G.W.D.
Drawn by: M.C.M.
Checked by: M.A.C.
Approved by: G.W.D.

Scale: 1"=50'
Date: FEB., 2003
Sheet 12 OF 40

Sheet No. **12**

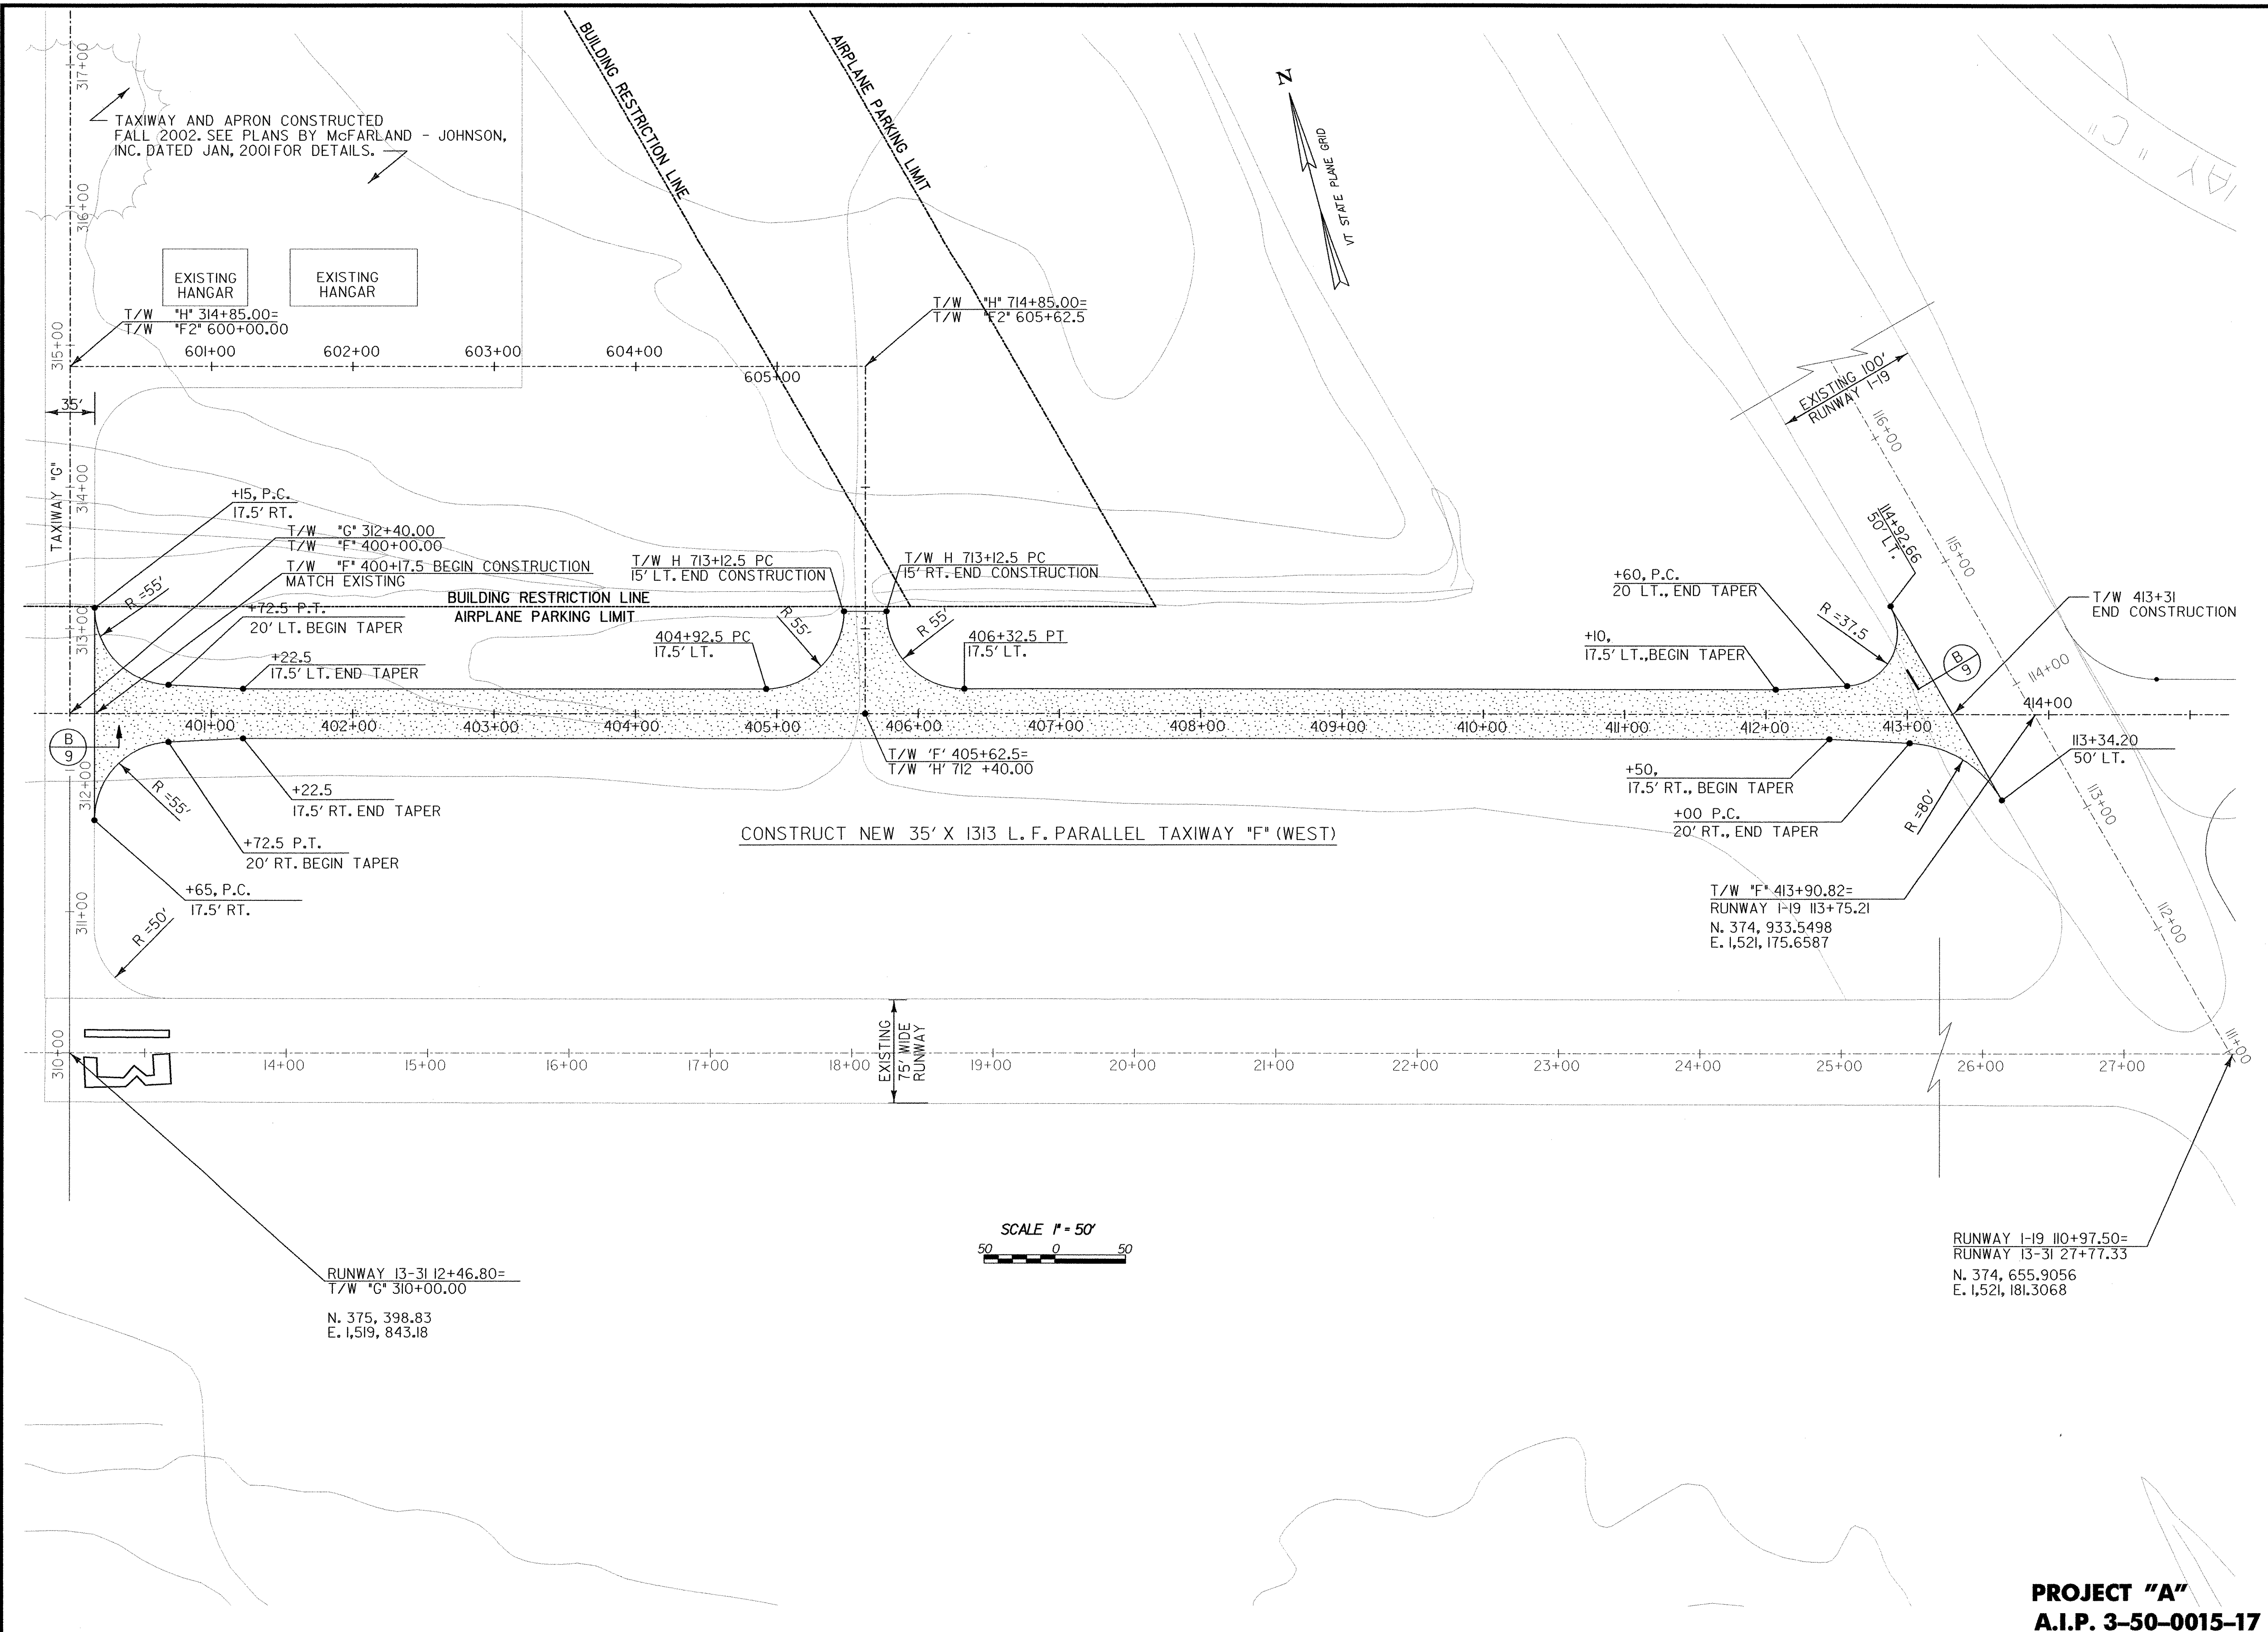

P:\CIVIL\Sheet\0012002\F20020460002.dgn

PROJECT "A"
A.I.P. 3-50-0015-17