

REV.	DATE	DESCRIPTION

Job No. F200002046.00 File No. F2020-1600E3

RUTLAND STATE AIRPORT
CLARENDON, VERMONT


TAXIWAY IMPROVEMENTS
PAVING & GEOMETRIC LAYOUT

URS
1 NORTHWAY LN.
LATHAM, NEW YORK

Designed by: G.M.D.
Drawn by: M.C.M.
Checked by: M.K.C.
Approved by: G.M.D.

Scale: 1"=50'
Date: FEB., 2003
Sheet 13 OF 40

Sheet No. **13**

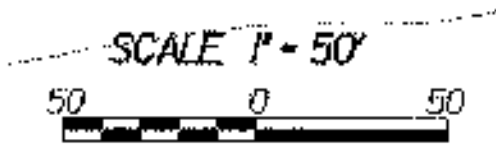

MI

PROJECT "B"
A.I.P. 3-50-0015-17