



REVISION	DATE	DESCRIPTION

Job No. F200002046.00
File No. F20020400DEIR


RUTLAND STATE AIRPORT
CLARENDON, VERMONT

TAXIWAY IMPROVEMENTS
MARKING PLAN-TAXIWAY "F" WEST


URS
1 NORTHWAY LN.
LATHAM, NEW YORK

Designed by: G.H.D.
Drawn by: M.C.M.
Checked by: M.A.C.
Approved by: G.H.D.

Scale: 1"=50'
Date: FEB., 2003
Sheet 19 OF 40
Sheet No. **19**

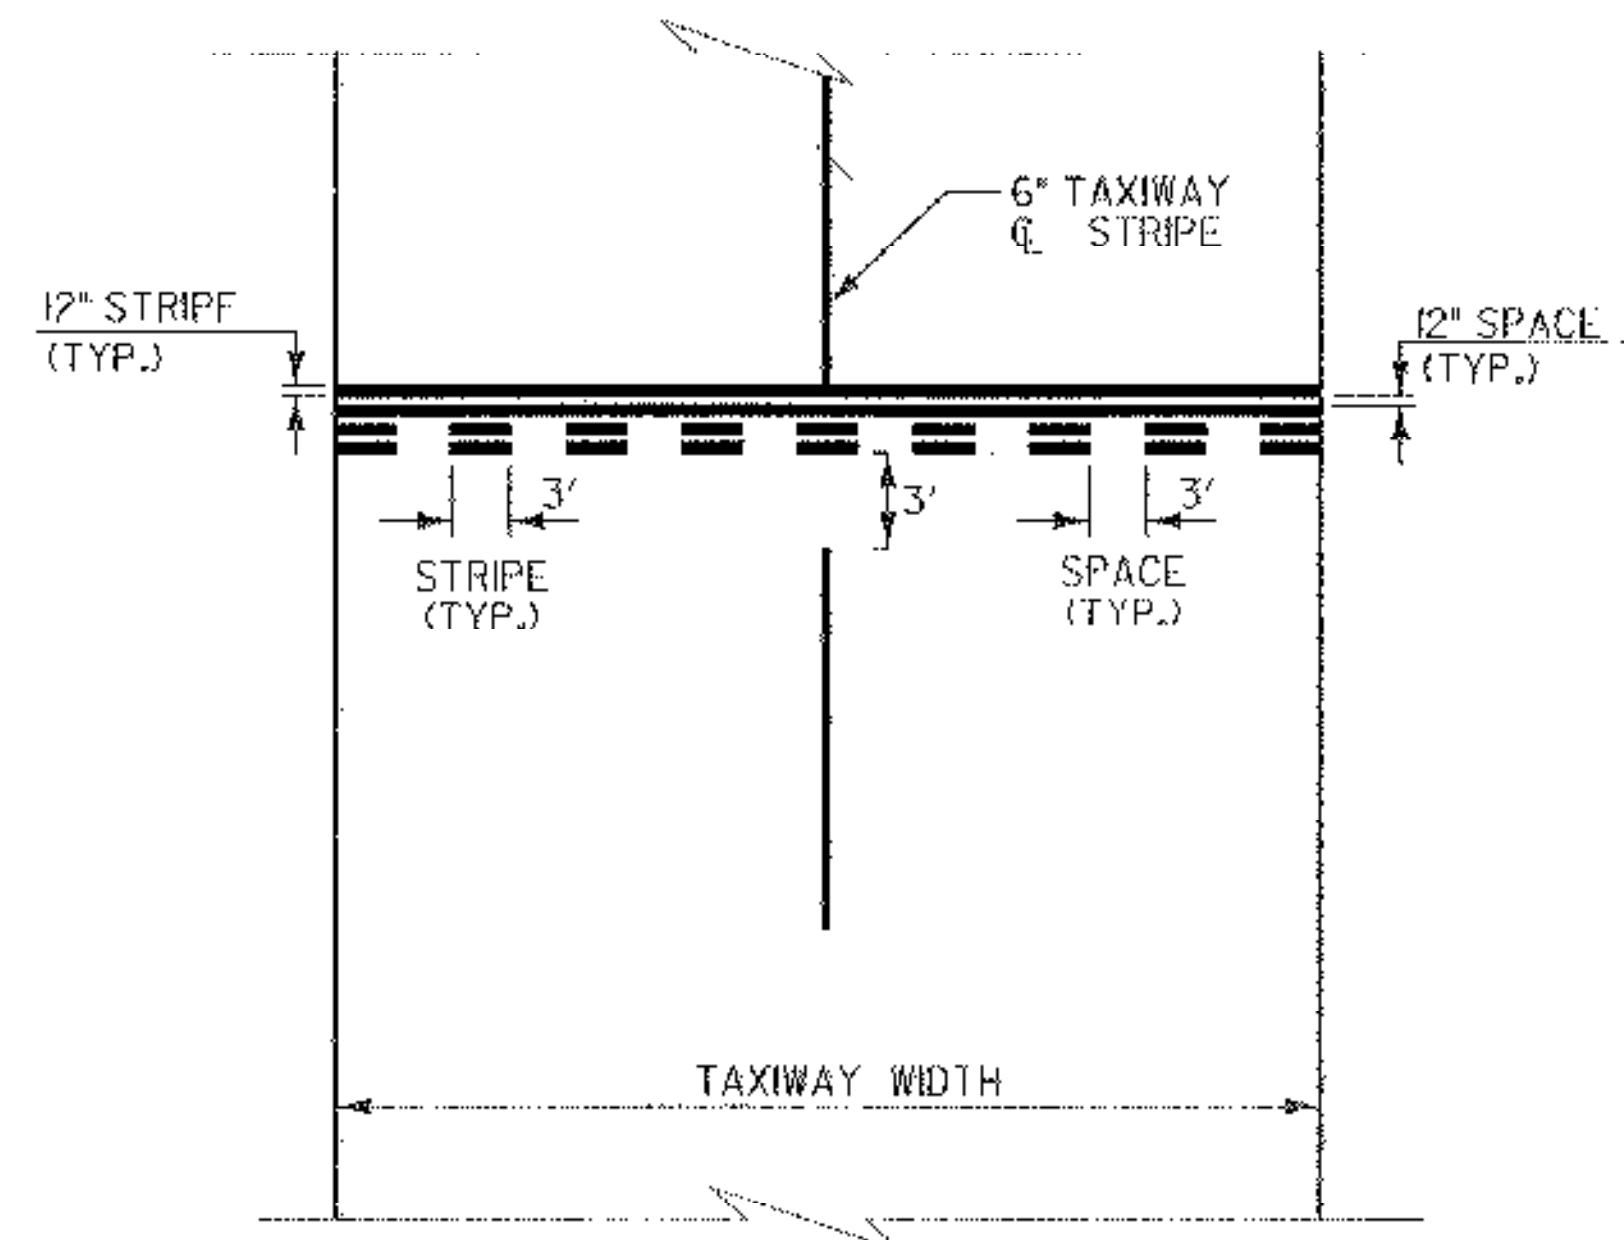

(A) RUNWAY HOLD LINE STRIPE (TYP.)

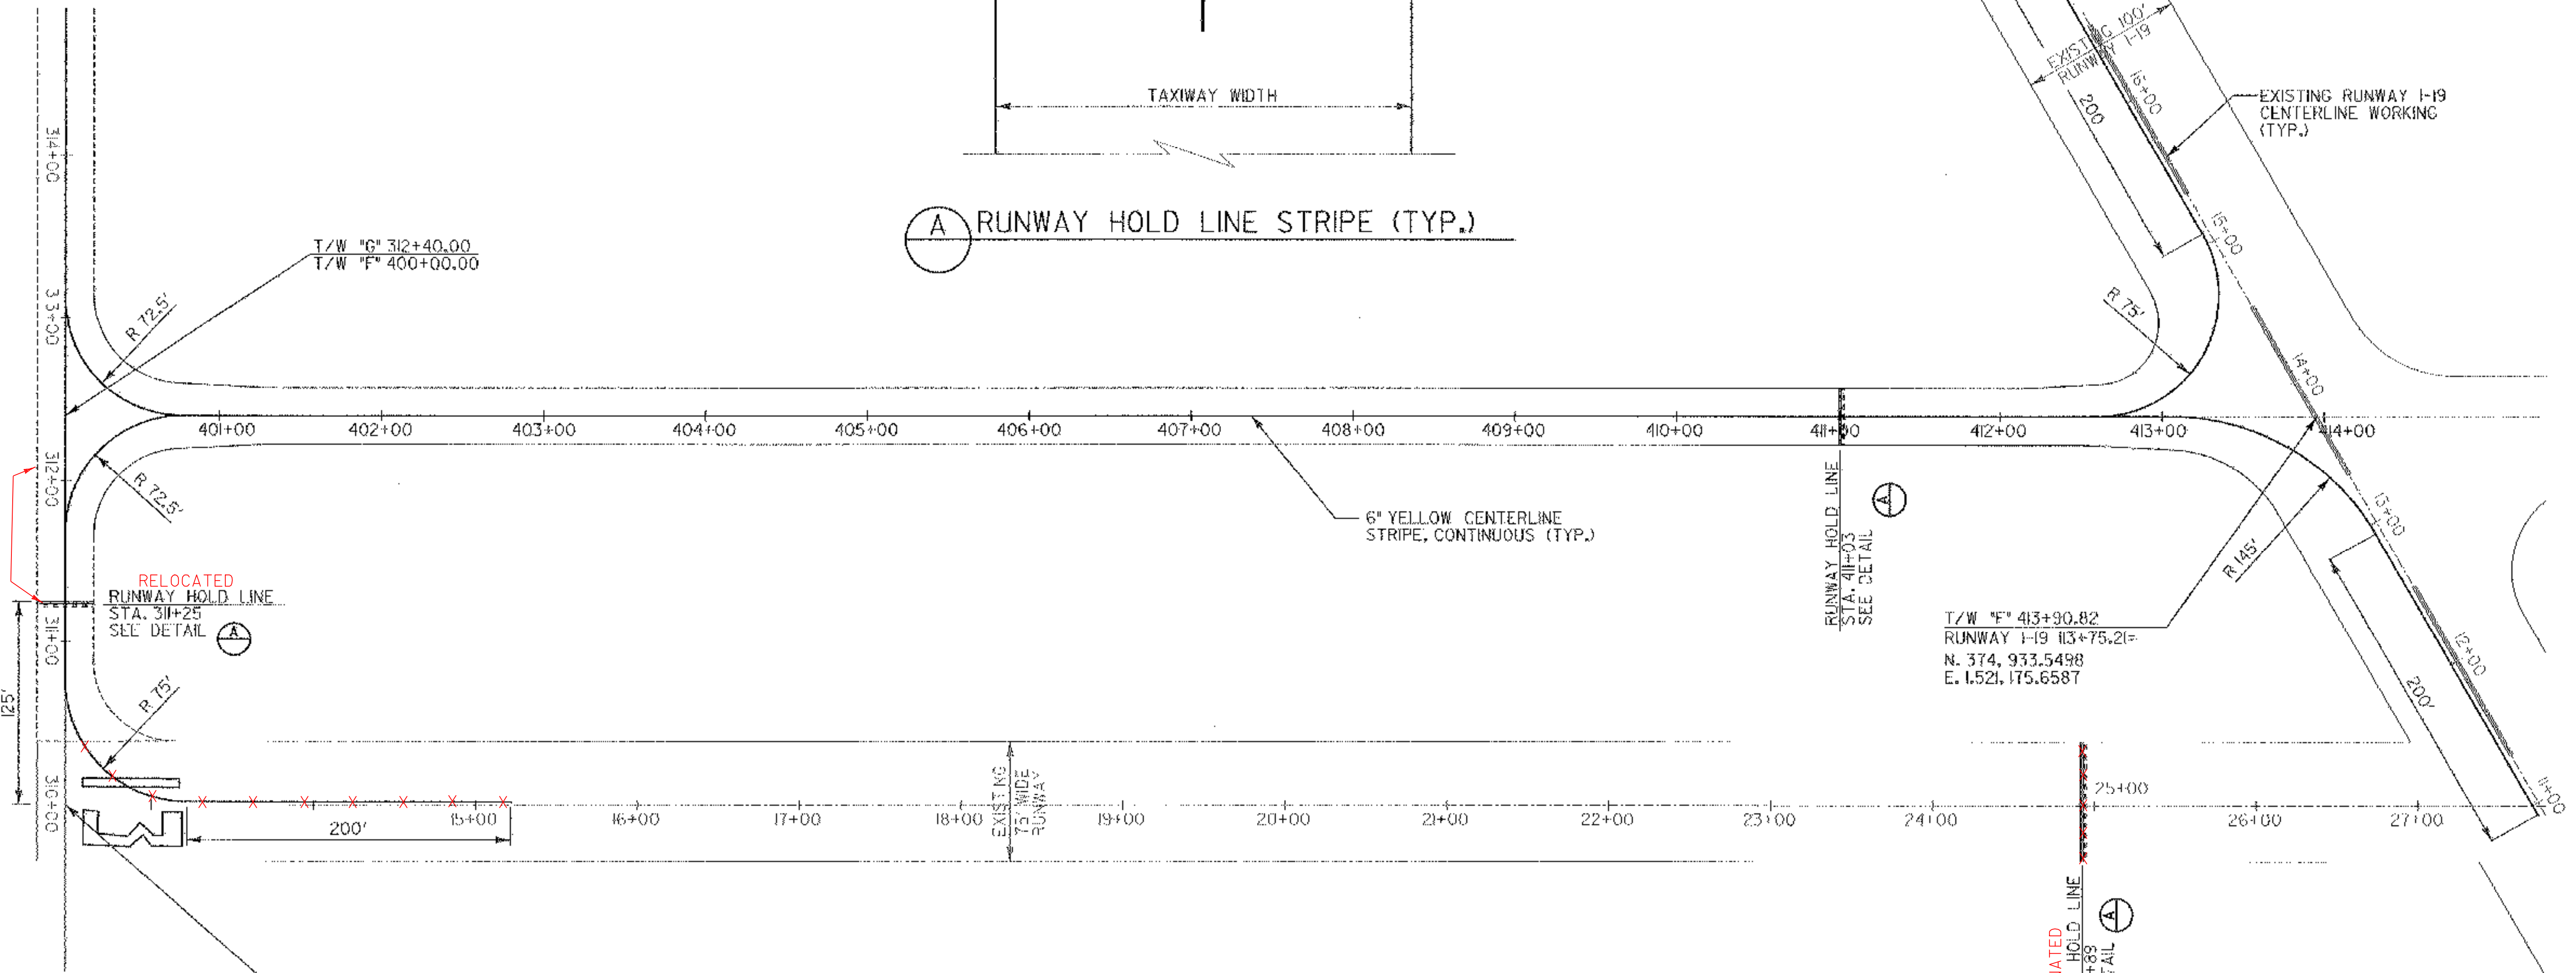

T/W "G" 312+40.00
T/W "F" 400+00.00

RELOCATED
RUNWAY HOLD LINE
STA. 311+25
SEE DETAIL (A)

6" YELLOW CENTERLINE
STRIPE, CONTINUOUS (TYP.)

RUNWAY HOLD LINE
STA. 411+03
SEE DETAIL (A)

T/W "F" 413+90.82
RUNWAY I-19 113+75.21=
N. 374, 933.5498
E. 1,521, 175.6587

ELIMINATED
RUNWAY HOLD LINE
STA. 24+89
SEE DETAIL (A)

RUNWAY 13-31 12+46.80=
T/W 310+00.00
N. 375, 398.83
E. 1,519, 843.18

- NOTES**
- REFER TO VT STANDARD DRAWING, AP-11, TAXIWAY MARKING DETAILS FOR ADDITIONAL INFORMATION
 - TAXIWAY MARKINGS TO CONFORM TO A.C. 150/5340-1H STANDARDS FOR AIRPORT MARKING
 - ALL TAXIWAY MARKINGS TO BE YELLOW REFLECTIVE USING GLASS BEADS.
 - CONTRACTOR TO MARK ALL RUNWAY HOLD LINES ON AIRPORT TO NEW DETAIL A/18 AS DIRECTED BY THE ENGINEER, INCLUDING HOLD LINES ON RUNWAYS I-19 AND 13-31, TAXIWAY "C", "D", AND "E". EXISTING MARKINGS NOT CONFORMING TO DETAIL ARE TO BE REMOVED, ITEM. 646.82

