


PROJECT "A"
A.I.P. 3-50-0015-17

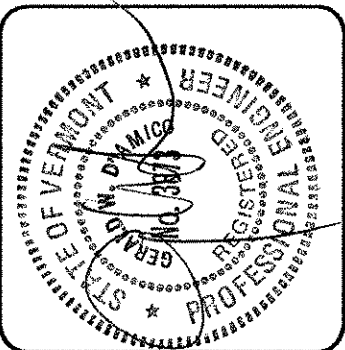

REV.	DATE	DESCRIPTION

Job No. F200002046.00
File No. F2020460d31

RUTLAND STATE AIRPORT
CLARENDON, VERMONT

CROSS SECTIONS
TAXIWAY "F"

URS
1 NORTHWAY LN.
LATHAM, NEW YORK

Designed by G.W.D.
Drawn by M.C.M.
Checked by M.K.C.
Approved by G.W.D.

Scale AS SHOWN

Date: FEB, 2003

Sheet 31 OF 40

Sheet No

31

P:\CIVIL\Sheet\0012002\F2020460d31.dgn