


PROJECT "B"
A.I.P. 3-50-0015-17

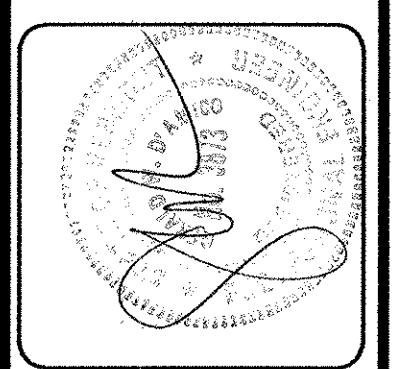

REV.	DATE	DESCRIPTION

Job No. F20002046.00
File No. F20204601d34

RUTLAND STATE AIRPORT
CLARENDON, VERMONT

CROSS SECTIONS
TAXIWAY "P"

URS
1 NORTHWAY LN.
LATHAM, NEW YORK

Designed by: G.W.D.	Drawn by: M.C.M.	Checked by: M.A.C.	Approved by: G.W.D.
Scale: AS SHOWN			
Date: FEB., 2003			
Sheet 34 OF 40			
Sheet No 34			

F:\CIVIL\Sheet\012002\F20204601d34.dgn