


REV.	DATE	DESCRIPTION

Job No. F200002046.00  
File No. F20204600DE39








**RUTLAND STATE AIRPORT**  
CLARENDON, VERMONT

**TAXIWAY IMPROVEMENTS**  
**WASTE AREA CROSS SECTIONS**

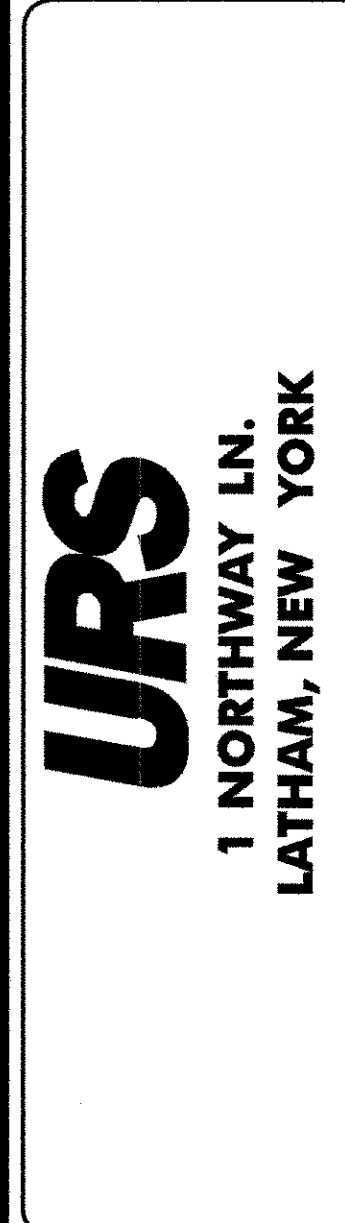

Designed by: G.W.D.  
Drawn by: M.C.M.  
Checked by: M.K.C.  
Approved by: G.W.D.

Scale: AS SHOWN  
Date: FEB., 2003  
Sheet 39 OF 40  
Sheet No. **39**

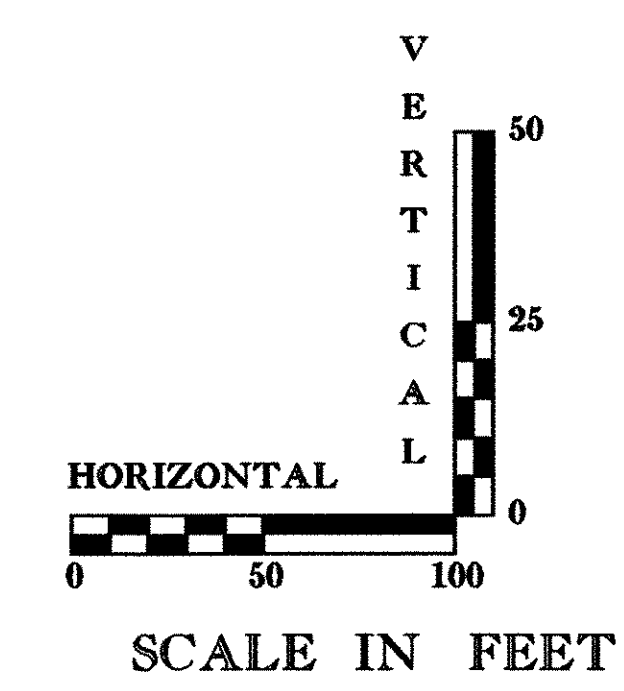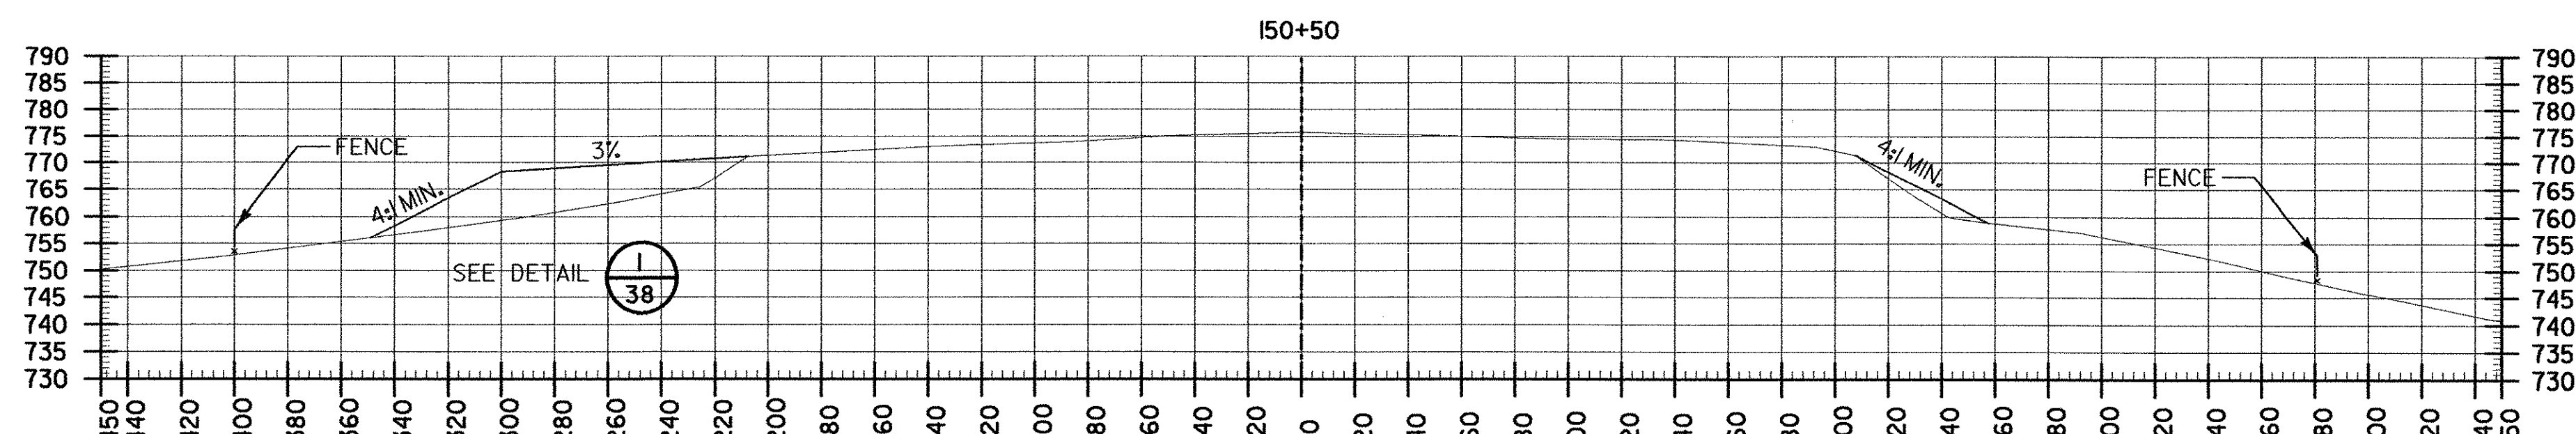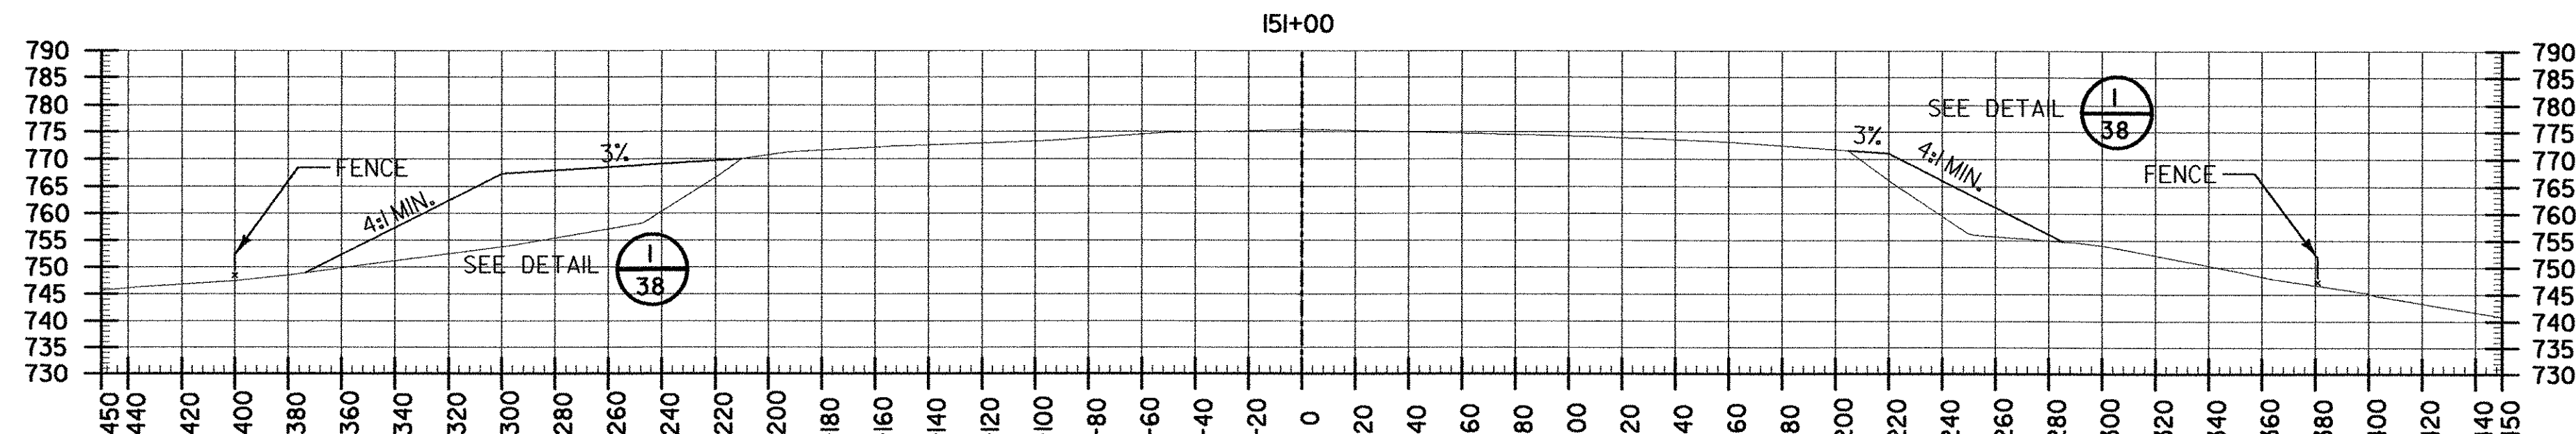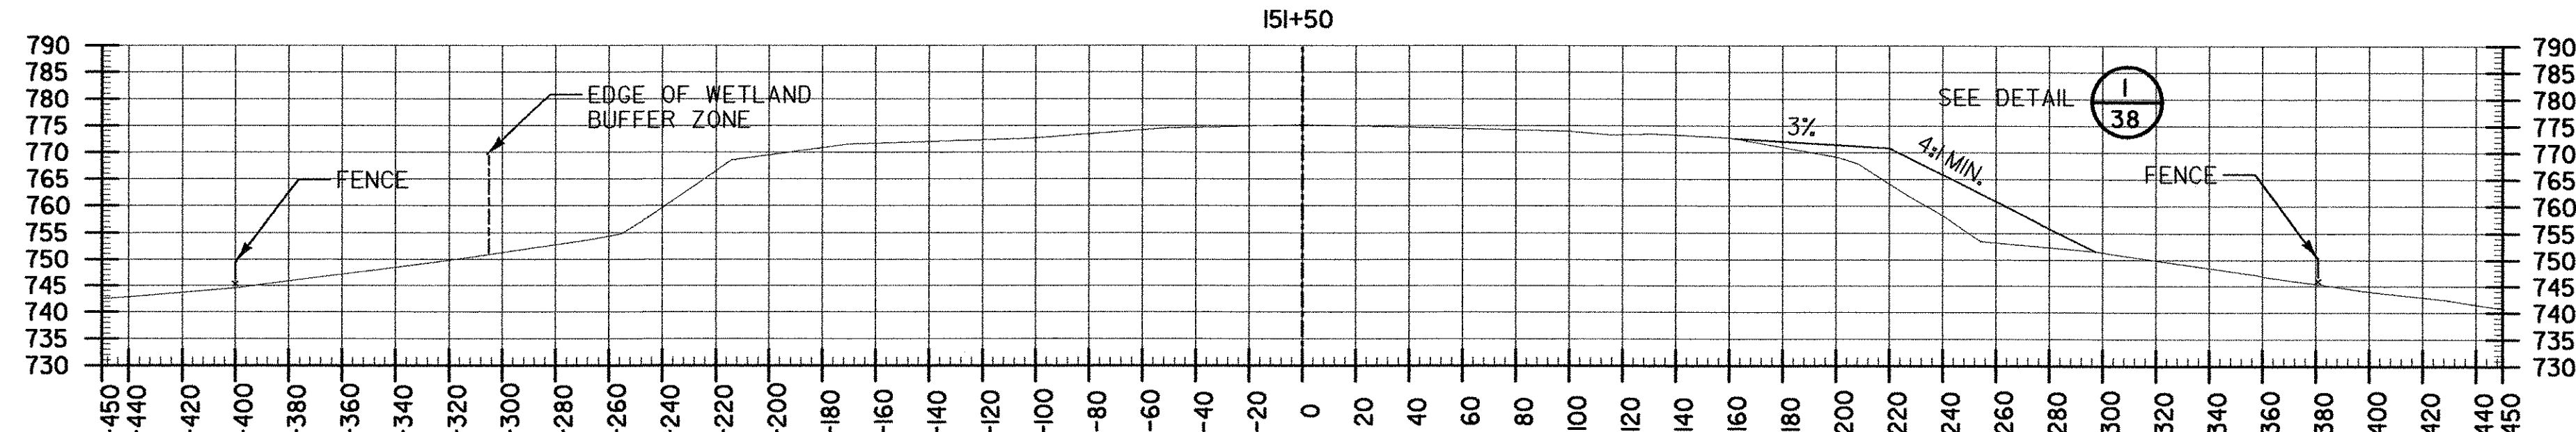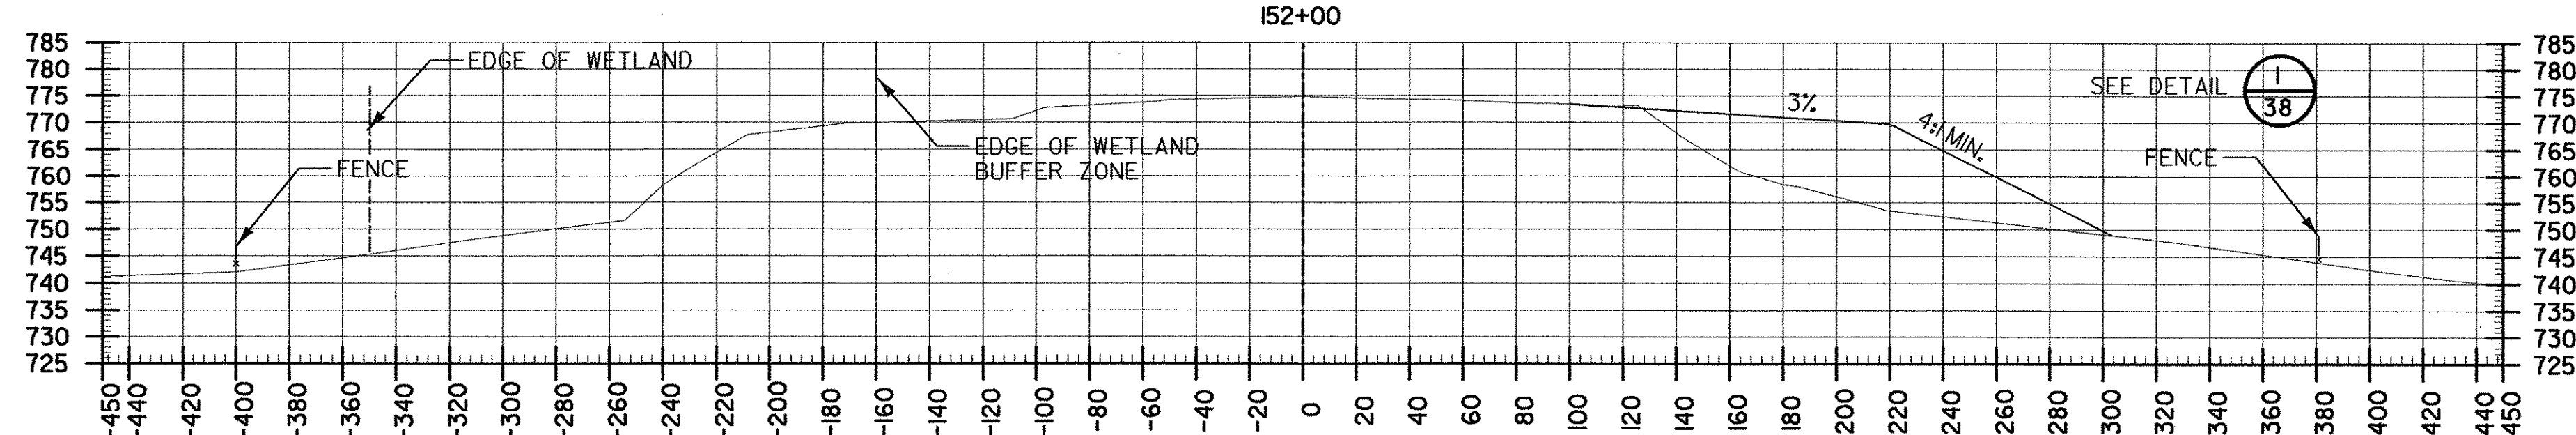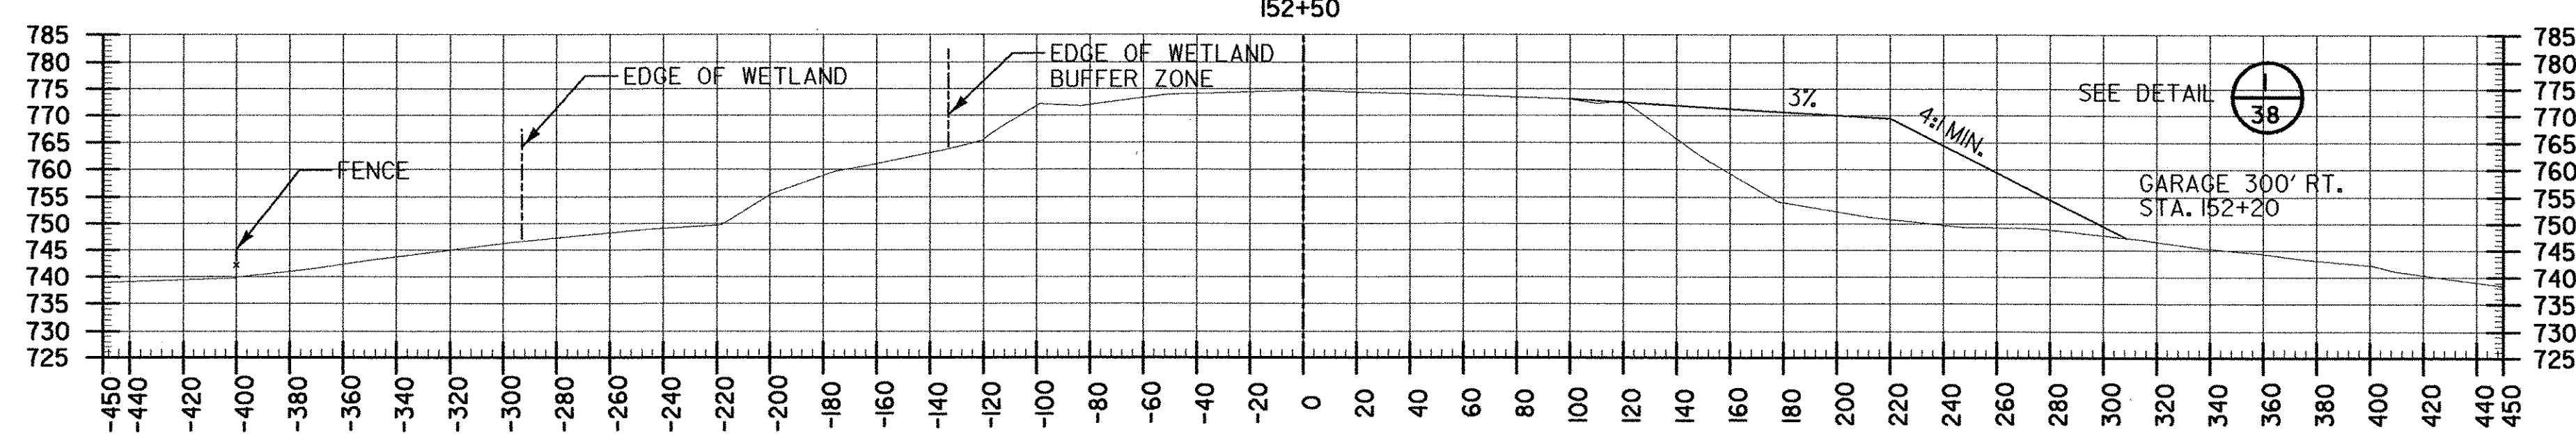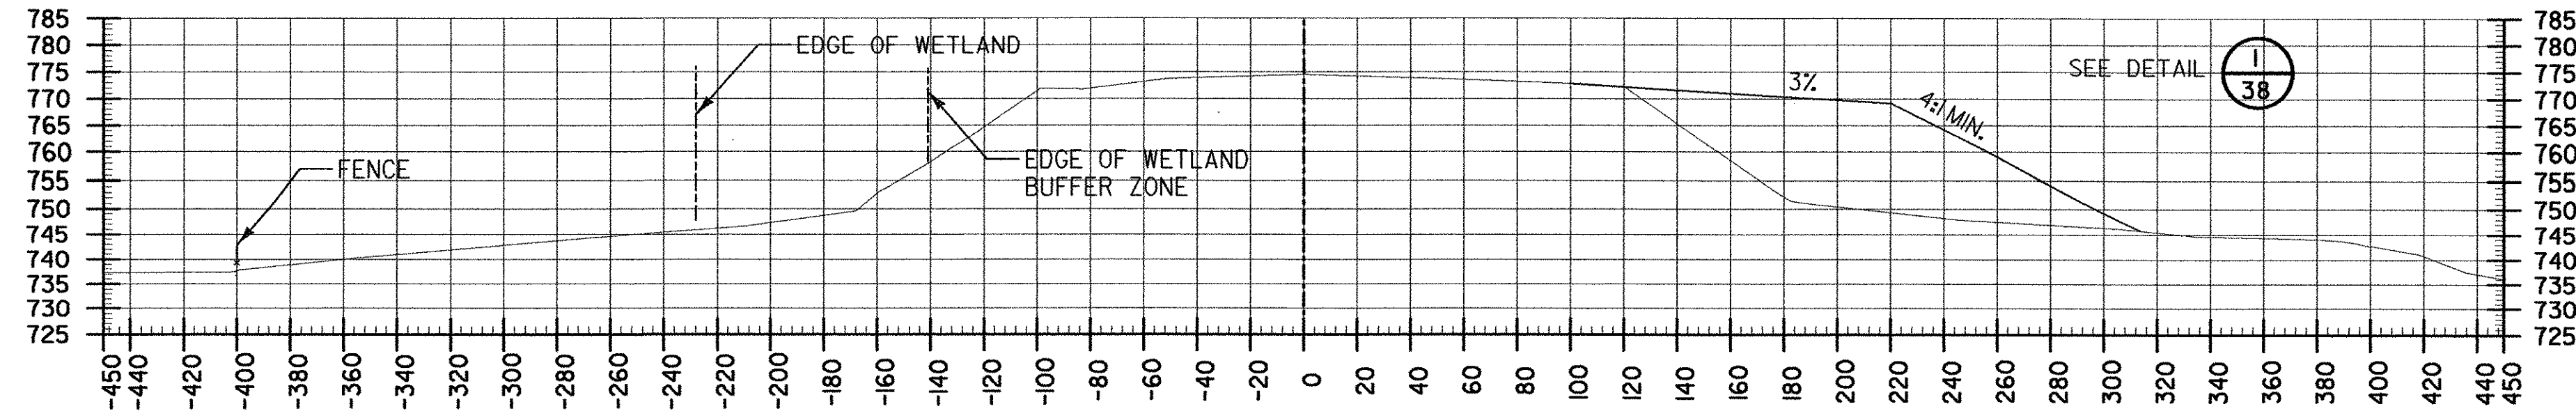

P:\CIVIL\Sheet\10072002\F20004600de39.dgn