


- NOTES:
1. SEE SHEET NO. 9 FOR SLOPES AND PIPE INVERTS.
 2. SEE SHEET NO. 10 FOR CULVERT AND CATCH BASIN DETAILS.

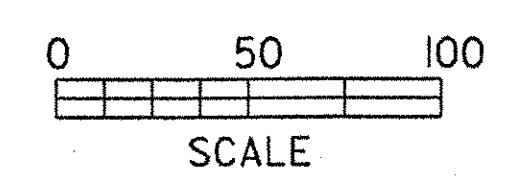

PROJECT NAME:	RUTLAND AIRPORT APRON
PROJECT NUMBER:	15639.00
FILE NAME:	Z15639WRK.DGN
PROJECT LEADER:	E. NASSAR
DESIGNED BY:	R. PERKINS
SITE PLAN	
PLOT DATE:	02-OCT-2000
DRAWN BY:	R. PERKINS
CHECKED BY:	E. NASSAR
SHEET 7	OF 12 042