



Volume Cut : 18.89  
Volume Fill : 165.85

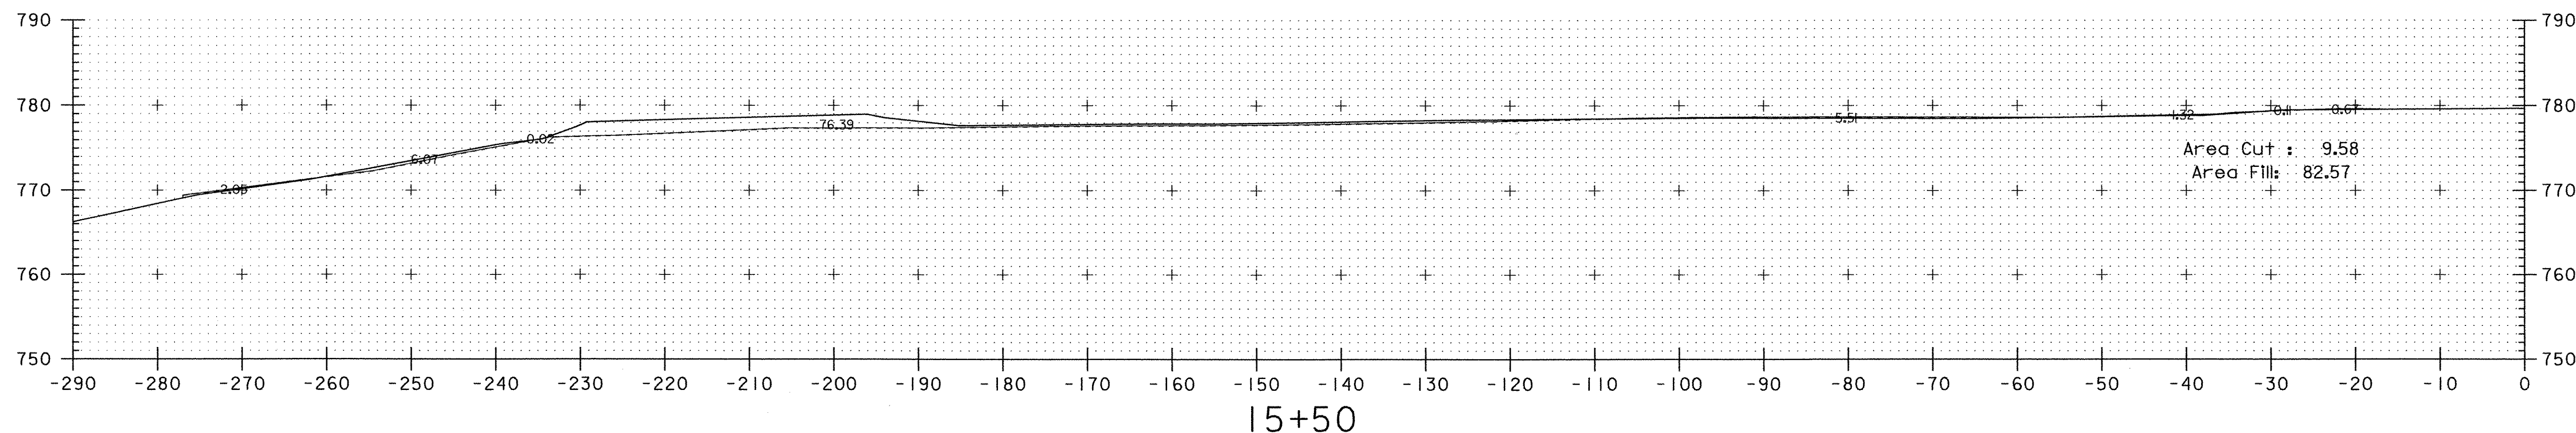

Volume Cut : 34.65  
Volume Fill : 82.03

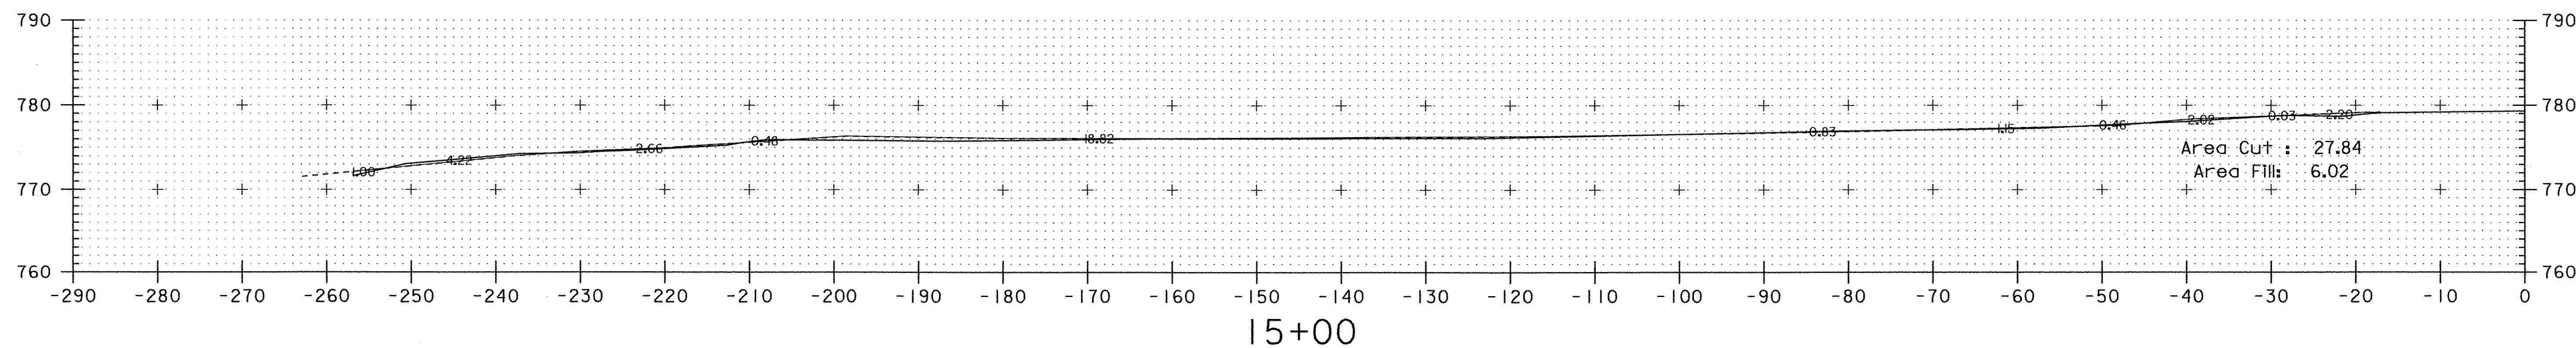

Volume Cut : 0.00  
Volume Fill : 0.00

PROJECT NAME:	Clarendon	PLOT DATE:	19-NOV-2003
PROJECT NUMBER:	AIR 04-3154	DRAWN BY:	R. Bullock
FILE NAME:	00h98/survey/work.dgn	CHECKED BY:	
PROJECT LEADER:		DESIGNED BY:	
Waste Area		SHEET 1	OF 3 049