


17+00
 Volume Cut : 37.70
 Volume Fill: 269.99

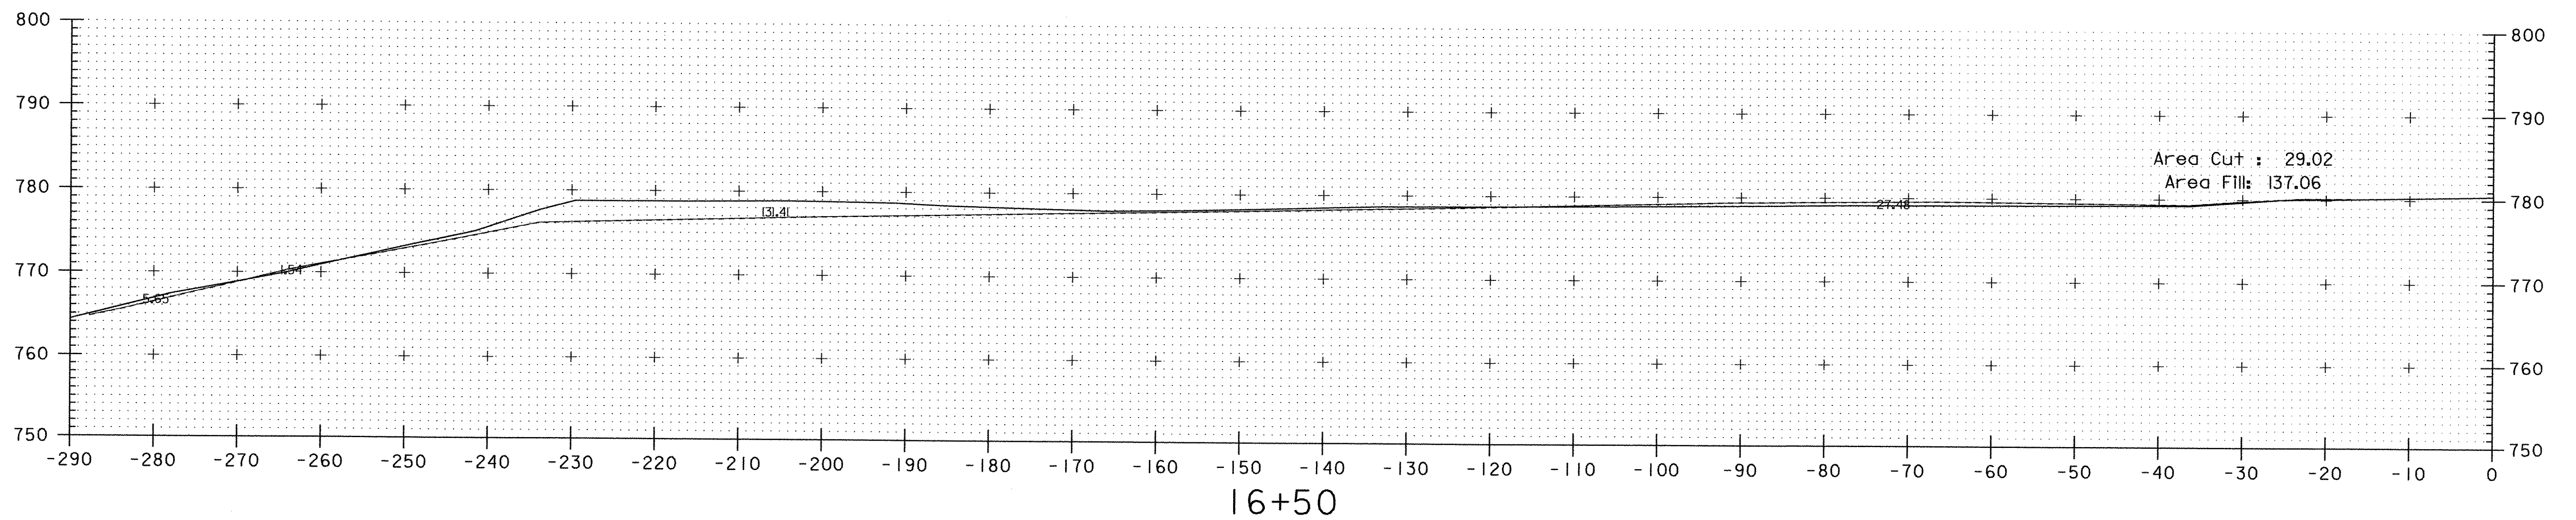

16+50
 Volume Cut : 36.88
 Volume Fill: 216.30

PROJECT NAME: Clarendon	
PROJECT NUMBER: AIR 04-3154	
FILE NAME: 00h98/survey/work.dgn	PLOT DATE: 19-NOV-2003
PROJECT LEADER:	DRAWN BY: R. Bullock
DESIGNED BY:	CHECKED BY:
Waste Area	SHEET 2 OF 3 050