


Volume Cut : 7.31
Volume Fill: 755.15

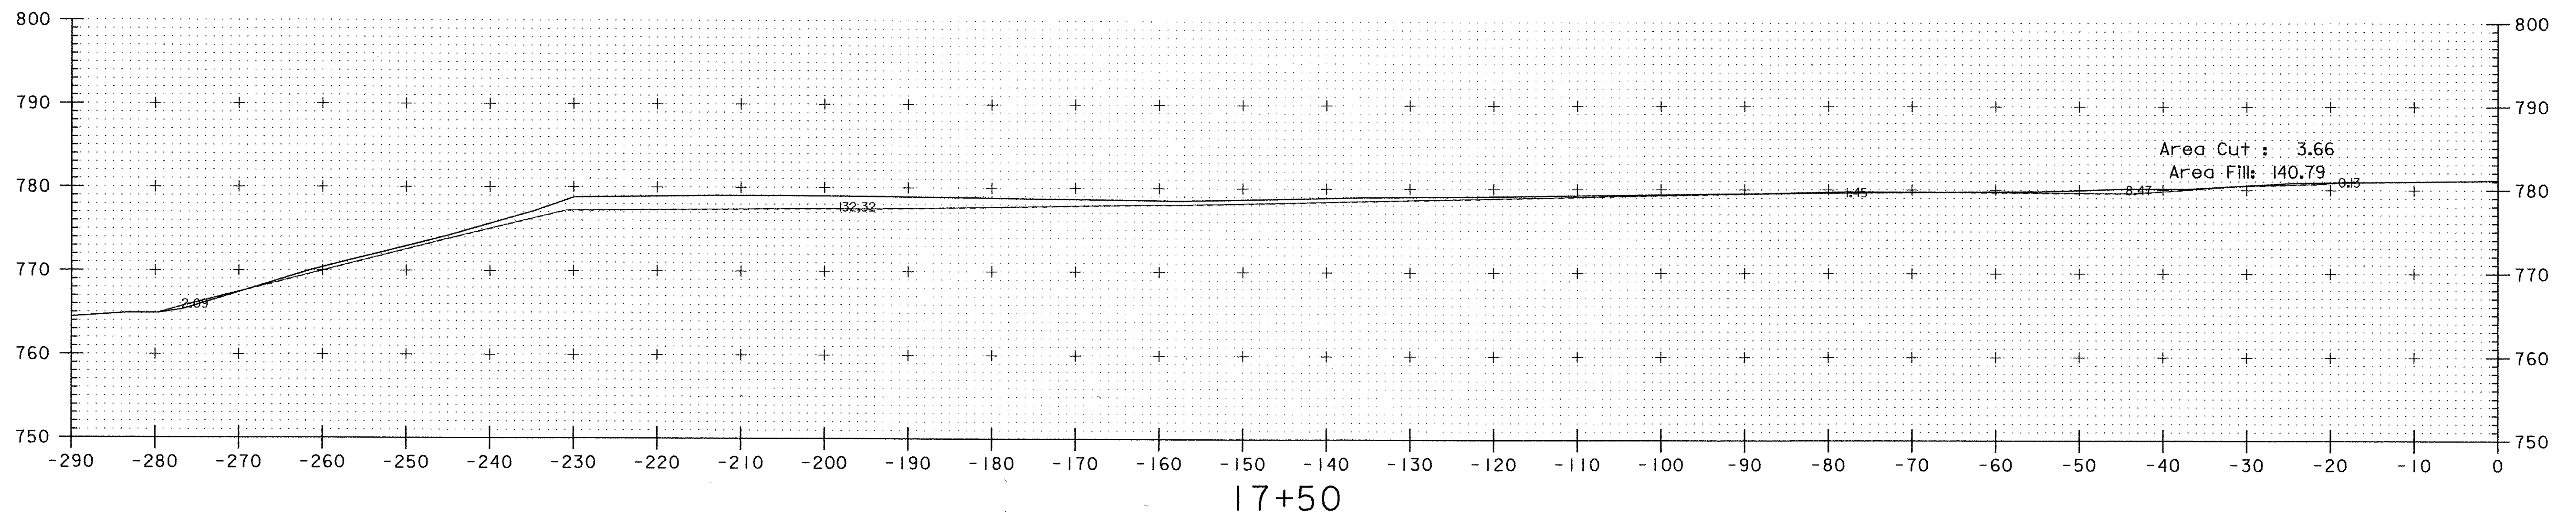

Volume Cut : 14.22
Volume Fill: 273.45

PROJECT NAME:	Clarendon	PLOT DATE:	19-NOV-2003
PROJECT NUMBER:	AIR 04-3154	DRAWN BY:	R. Bullock
FILE NAME:	00h98/survey/work.dgn	CHECKED BY:	
PROJECT LEADER:		DESIGNED BY:	
DESIGNED BY:		Waste Area	
		SHEET 3	OF 3 051