




Segmented Circle

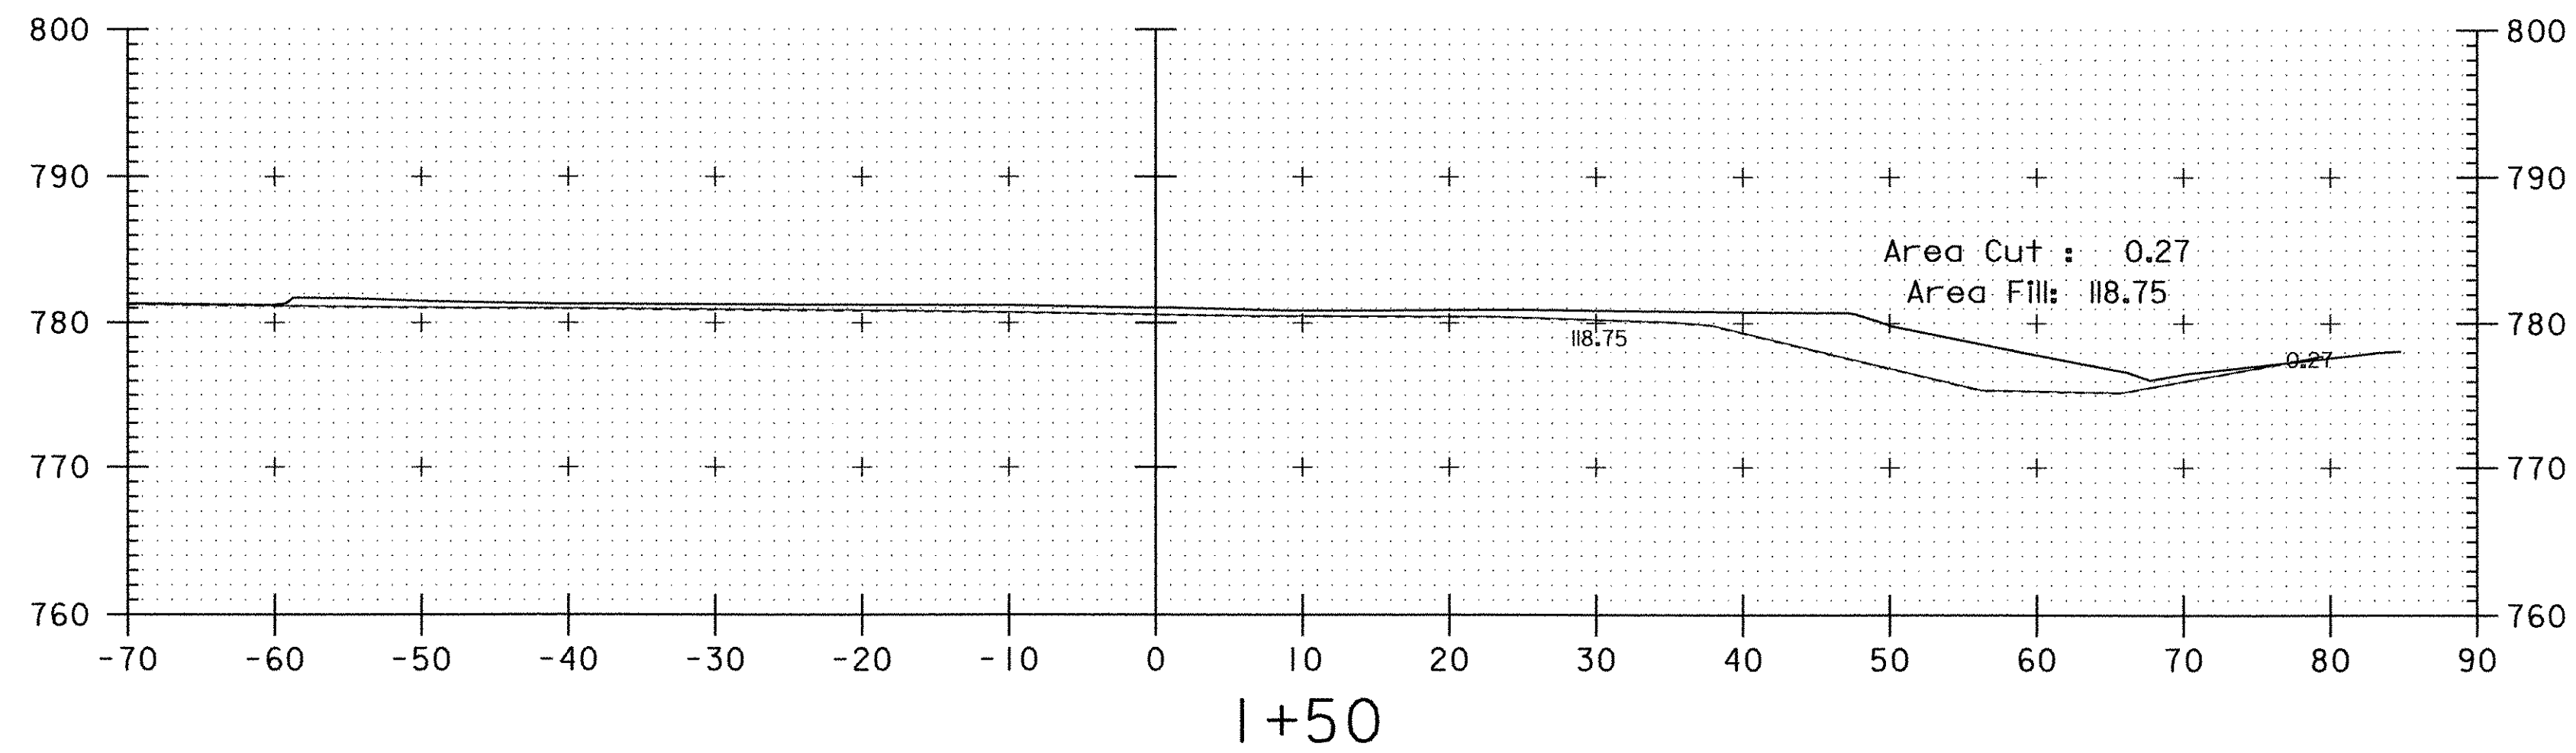

Volume Cut : 0.20  
Volume Fill: 72.52

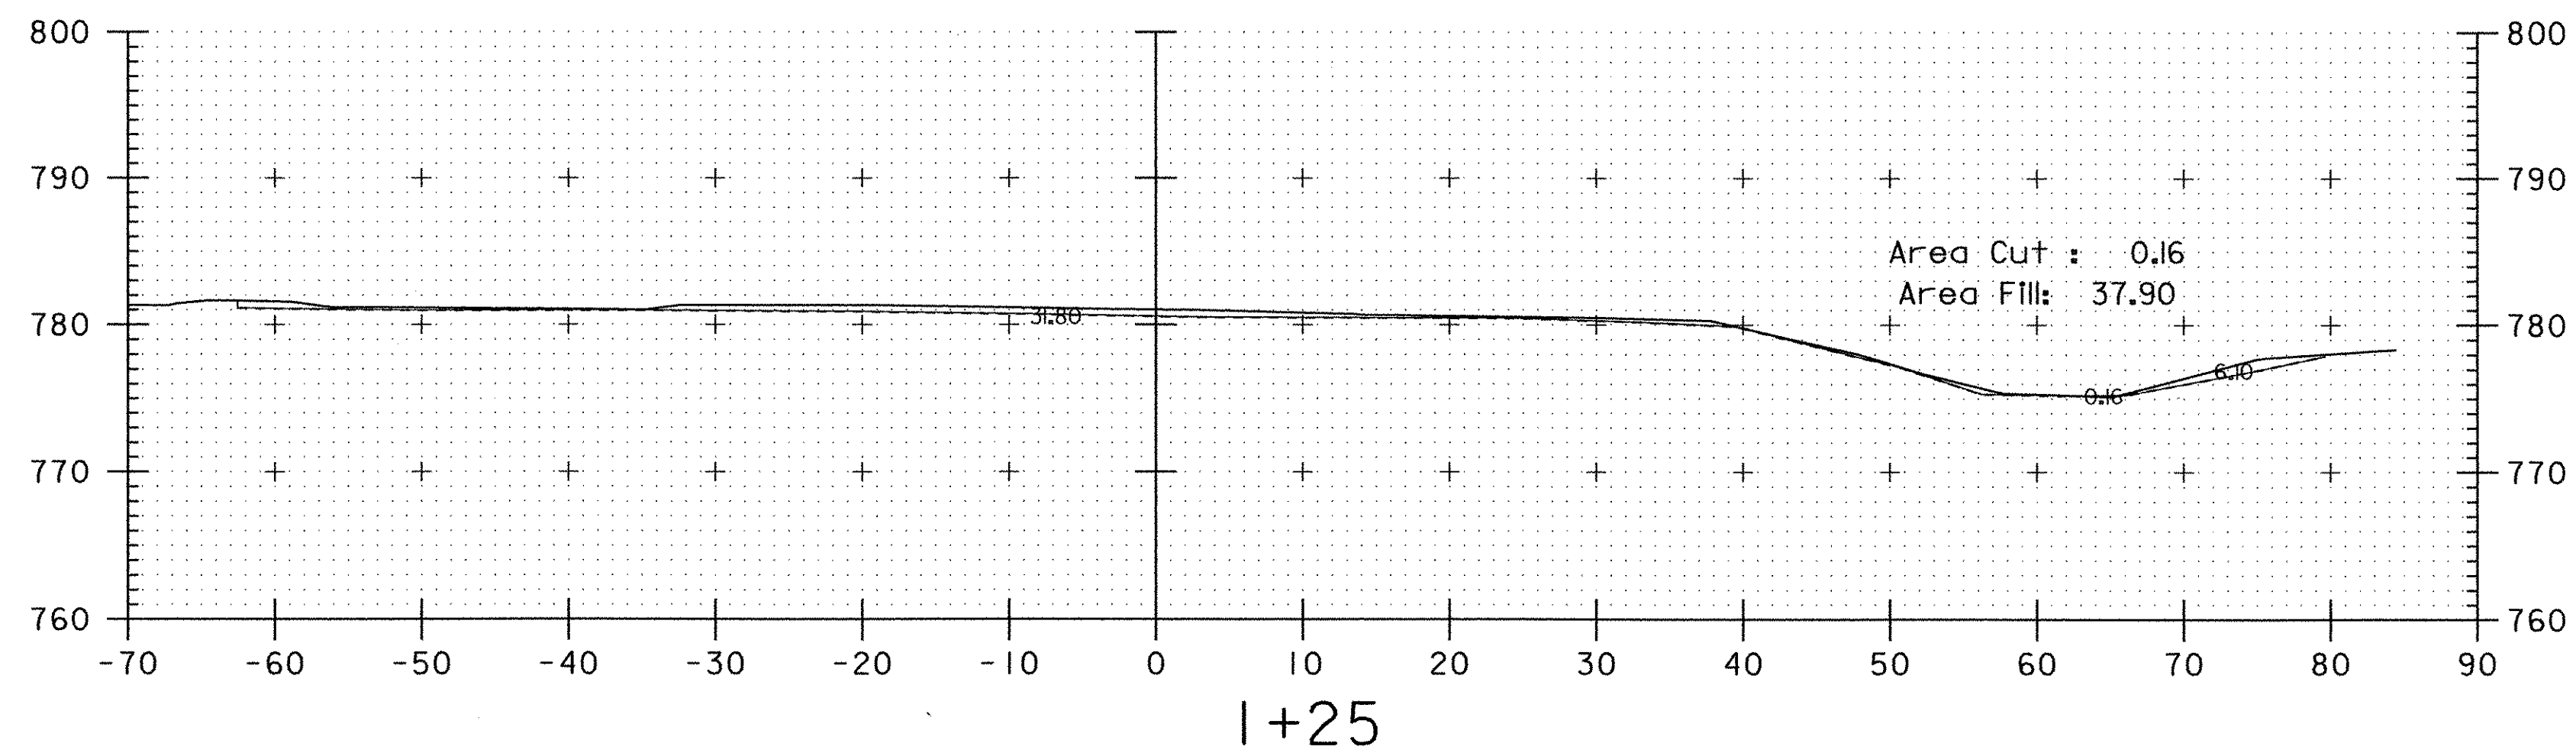

Volume Cut : 2.94  
Volume Fill: 20.66

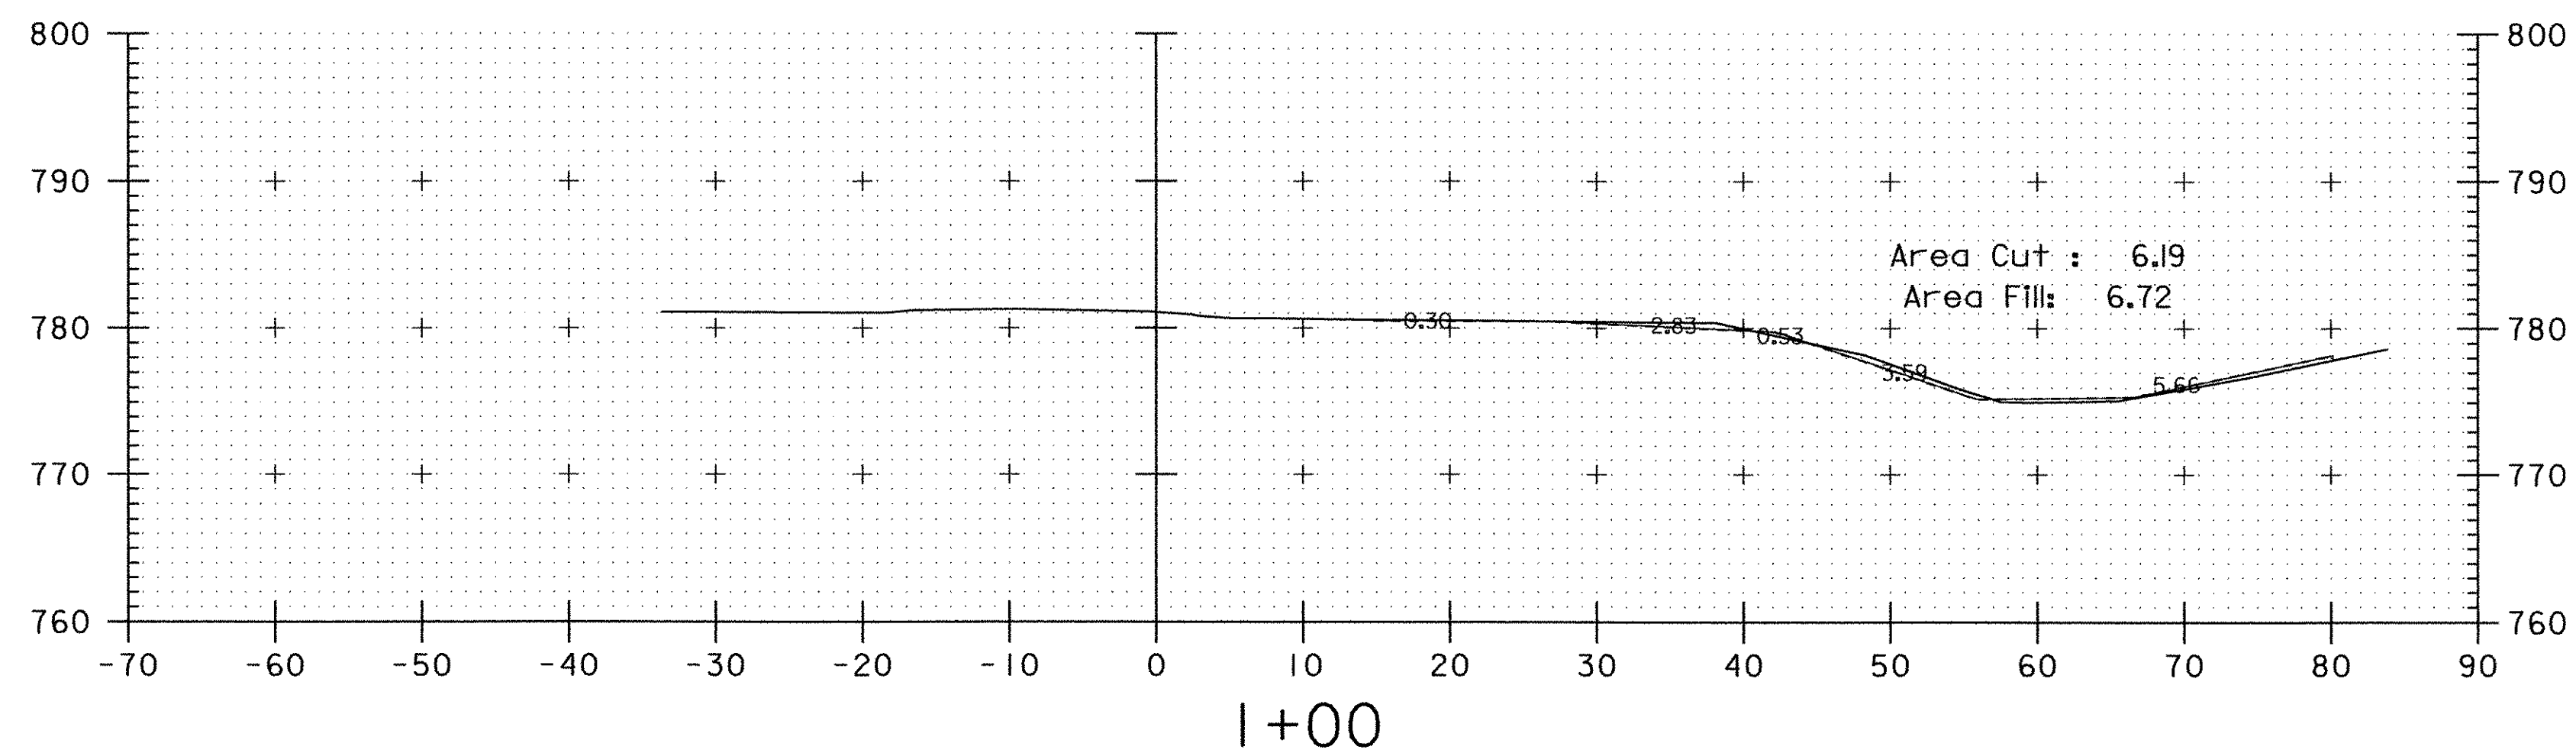

Volume Cut : 0.00  
Volume Fill: 0.00

PROJECT NAME: Clarendon	PLOT DATE: 19-NOV-2003
PROJECT NUMBER: AIR 04-3154	DRAWN BY: R. Bullock
FILE NAME: 00h98/survey/work.dgn	DESIGNED BY:
PROJECT LEADER:	CHECKED BY:
CIRCLE SEGMENT	SHEET 1 OF 2 052