



Segmented Circle


1998 AIR 2 2521

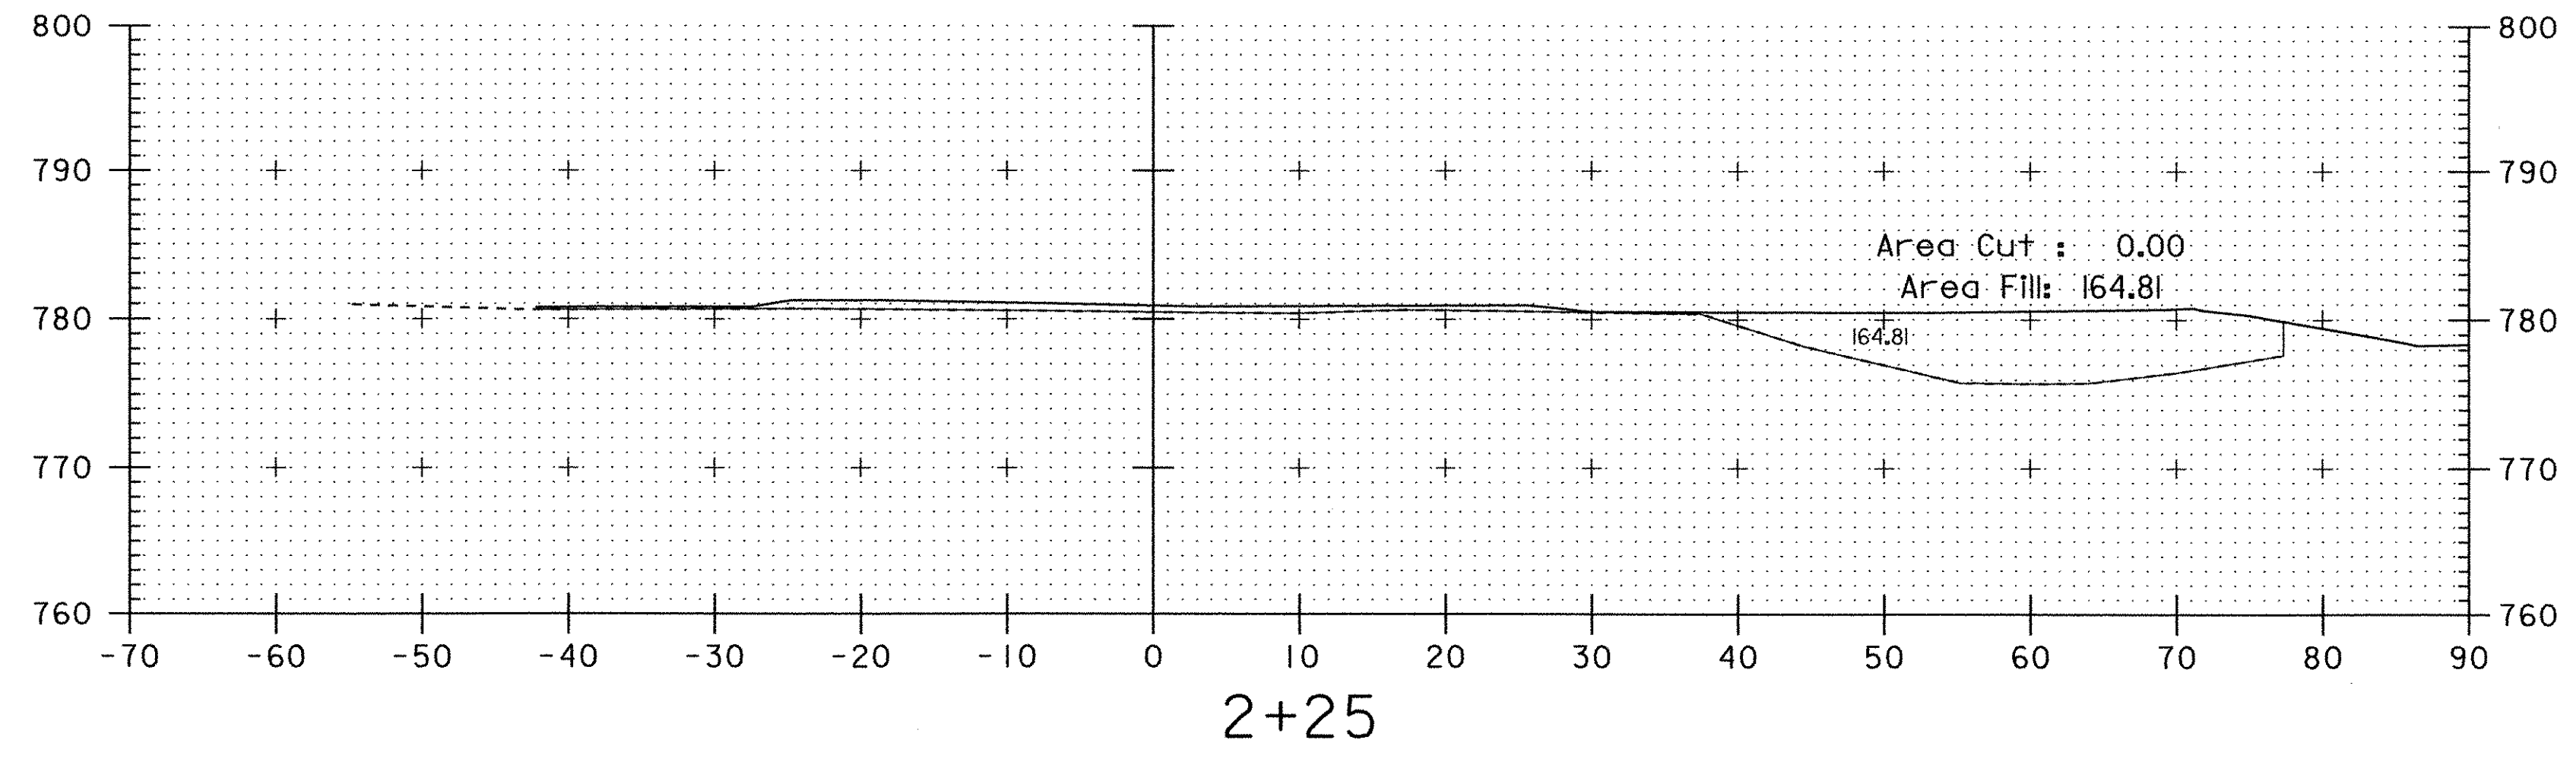

Volume Cut : 0.01
Volume Fill: 169.48

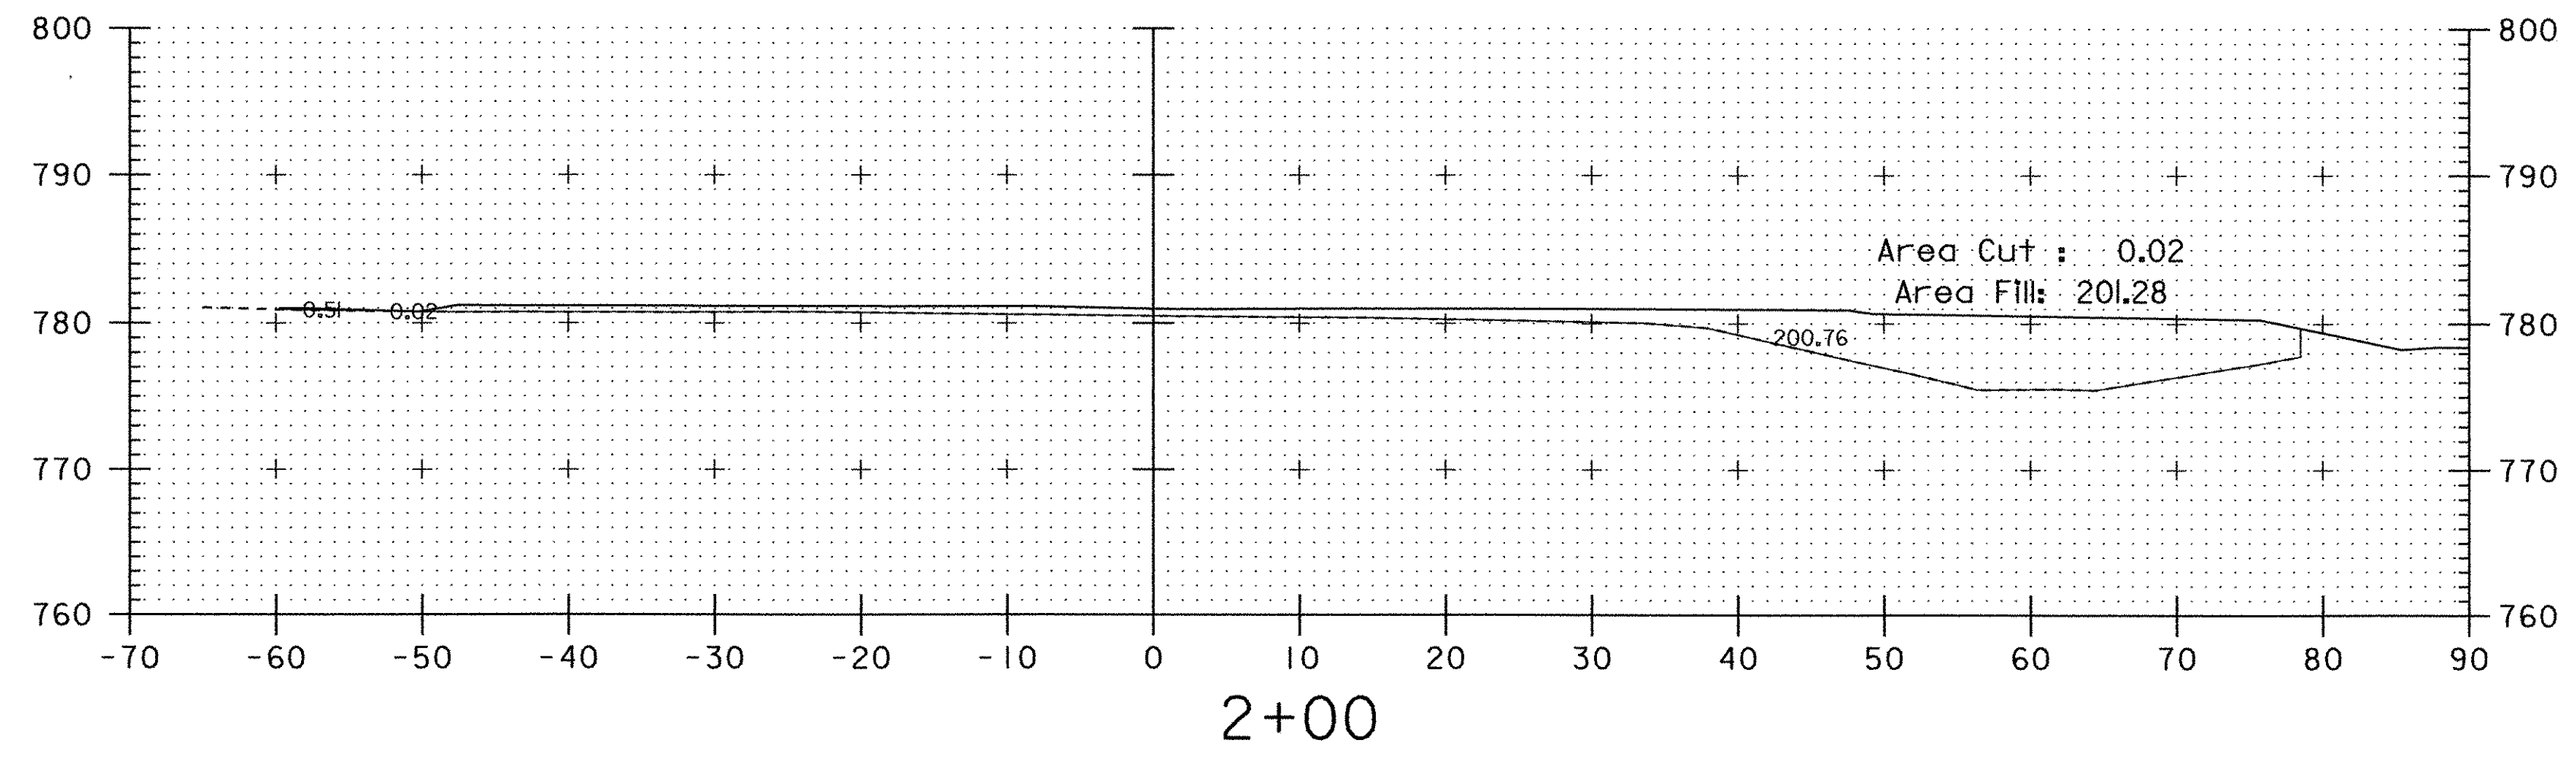

Volume Cut : 0.05
Volume Fill: 178.09

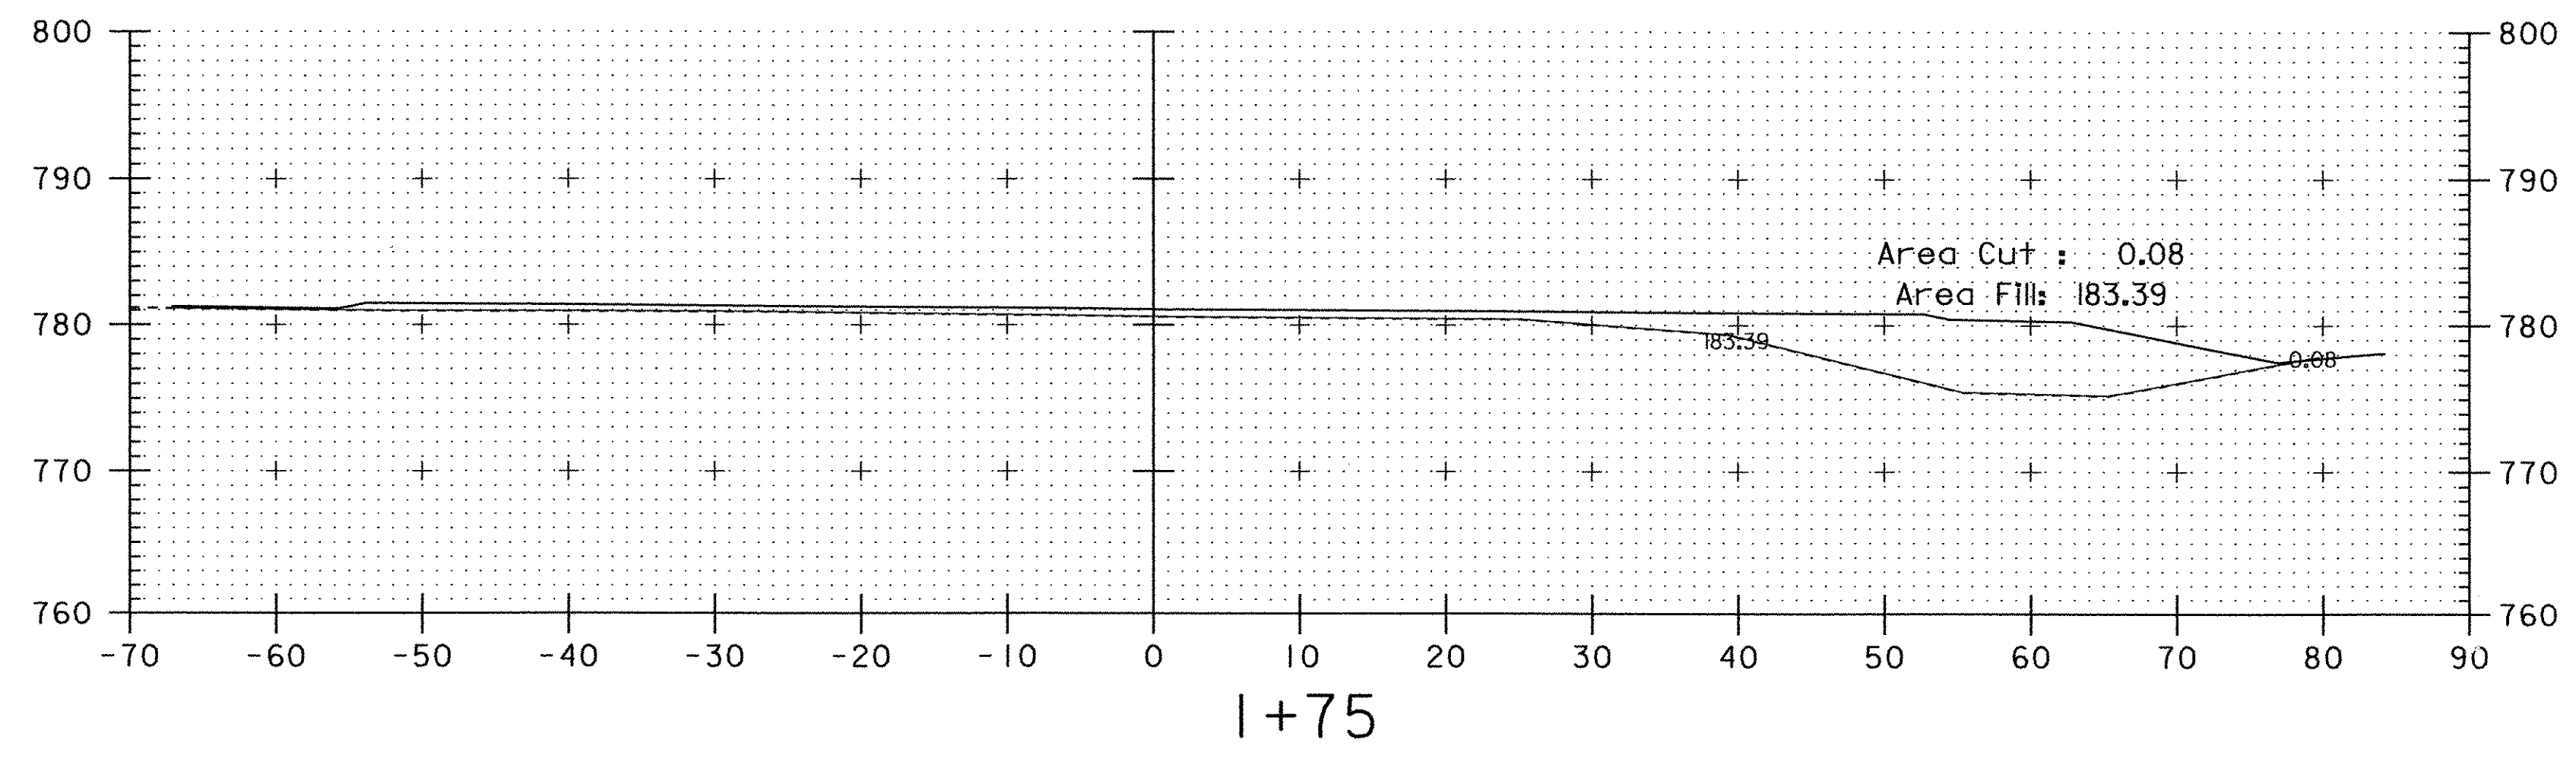

Volume Cut : 0.16
Volume Fill: 139.88

PROJECT NAME: Clarendon	PLOT DATE: 19-NOV-2003
PROJECT NUMBER: AIR 04-3154	DRAWN BY: R. Bullock
FILE NAME: 00h198/survey/work.dgn	CHECKED BY:
PROJECT LEADER:	SHEET 2 OF 2 053
DESIGNED BY:	
Circle Segment	

1998 AIR 2 2521