




STA 420+50 -COMMON EXCAVATION = 698.39 SQ.FT.

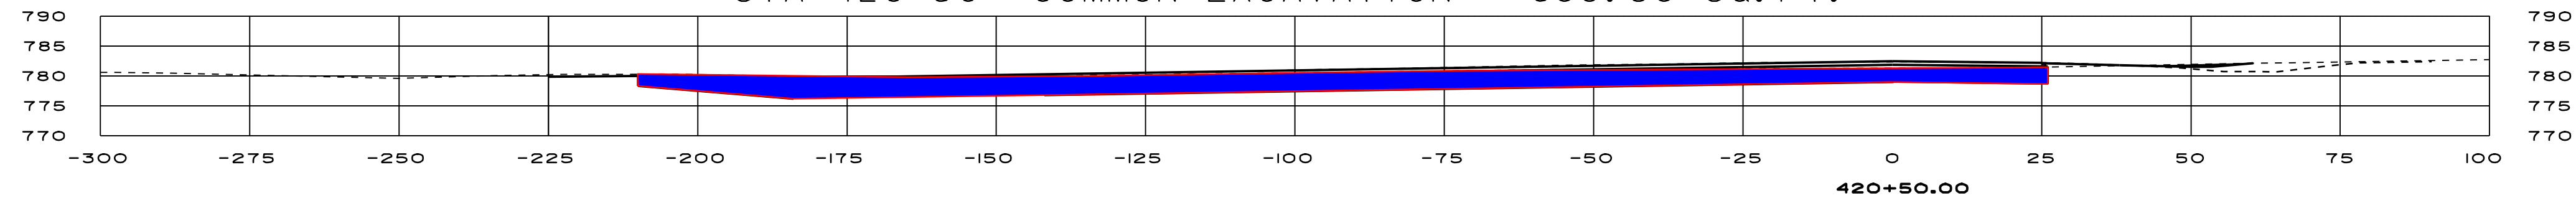

STA 420+00 -COMMON EXCAVATION = 631.76 SQ.FT.

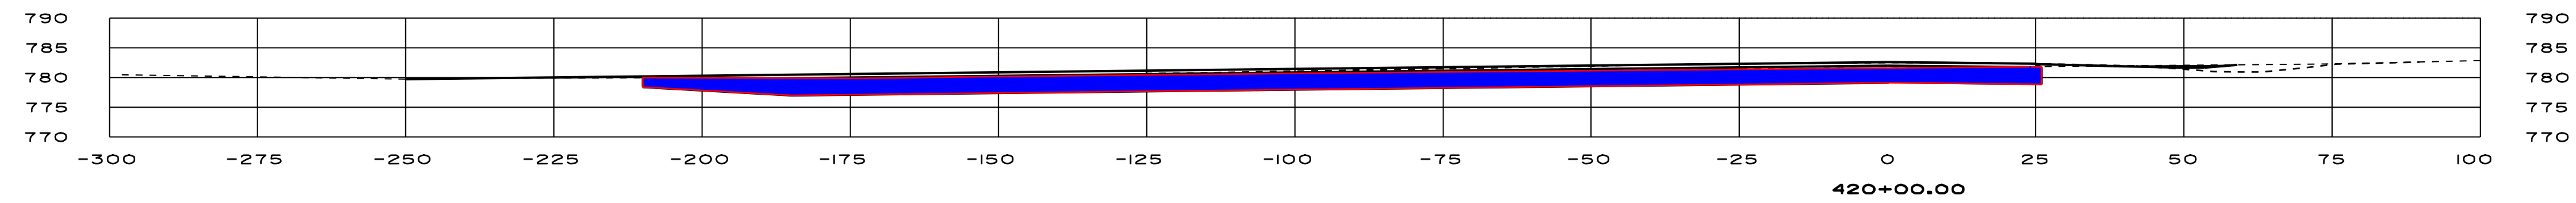


STA 419+60 -COMMON EXCAVATION = 613.08 SQ.FT. (AHEAD)

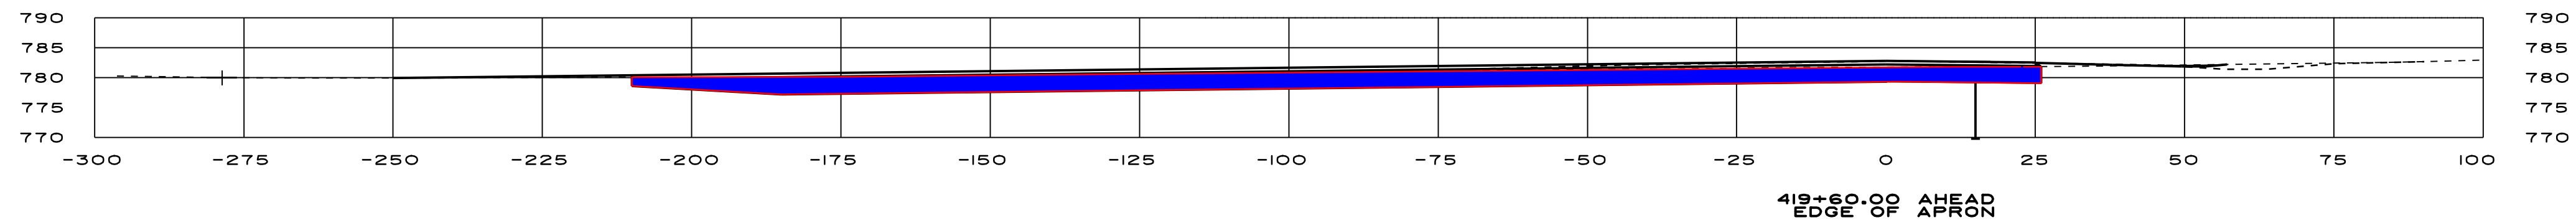

STA 419+60 -COMMON EXCAVATION = 253.20 SQ.FT. (BACK)

STA 419+00 -COMMON EXCAVATION = 131.14 SQ.FT.

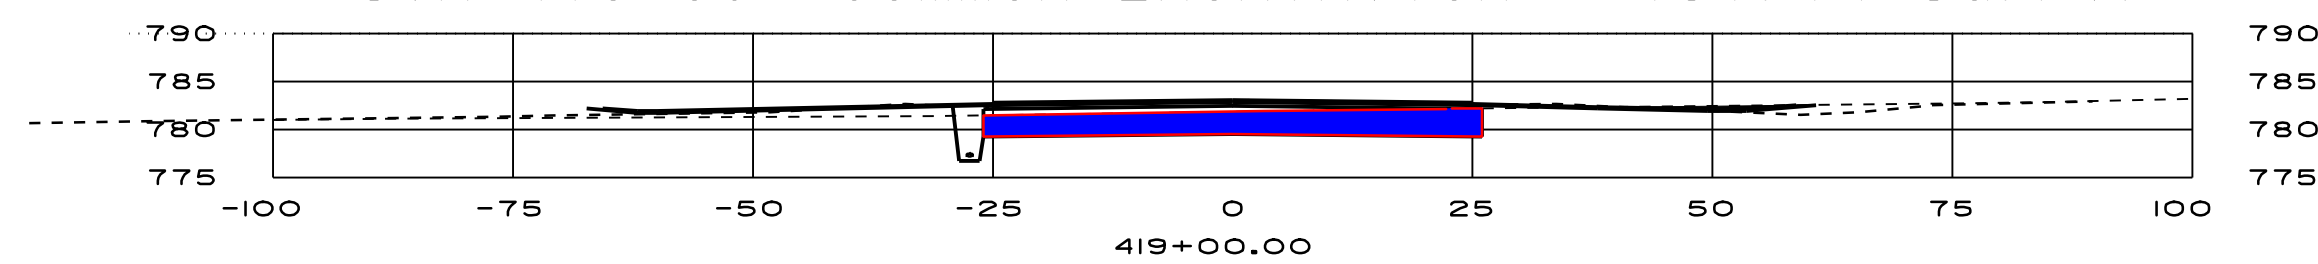

PROJECT:	CLARENDON	PROJECT NO. :	AIR 04-3154 C/I
DESIGN FILE NAME:			
IPARM FILE NAME:	S05	PLOT DATE:	27-JUL-2005
COMMON EXCAVATION			