




STA 422+36.5 -COMMON EXCAVATION = 476.01 SQ.FT.

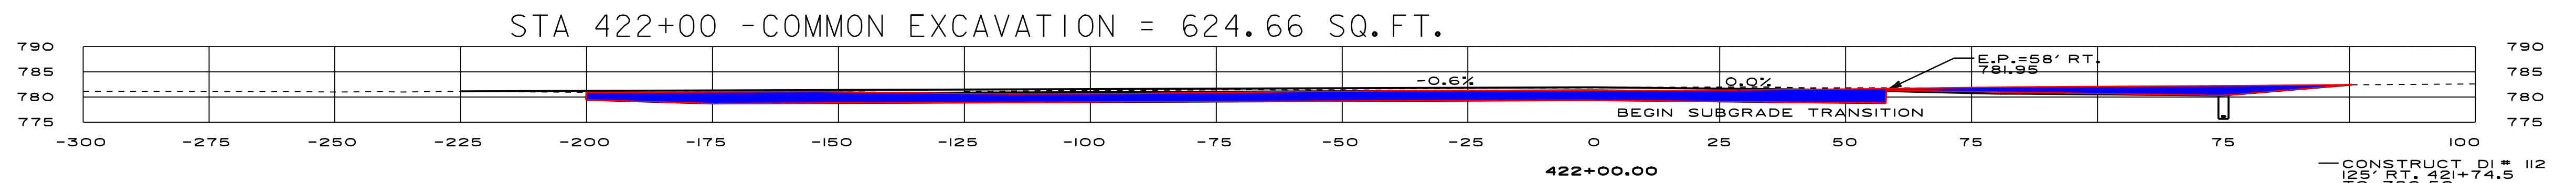

STA 422+00 -COMMON EXCAVATION = 624.66 SQ.FT.

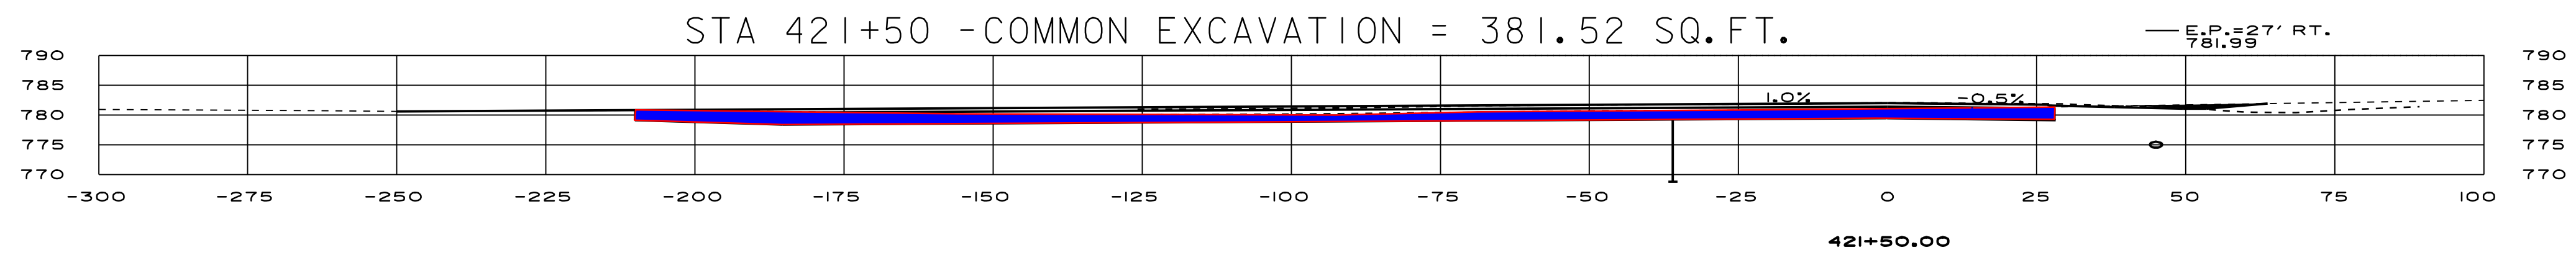

STA 421+50 -COMMON EXCAVATION = 381.52 SQ.FT.

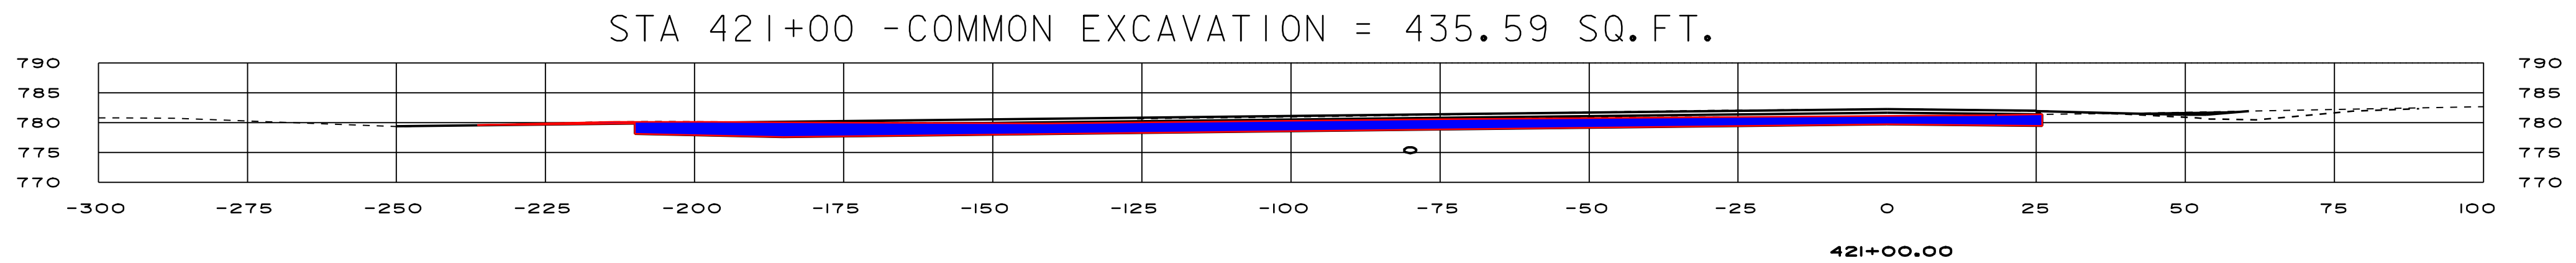

STA 421+00 -COMMON EXCAVATION = 435.59 SQ.FT.

PROJECT:	CLARENDON	PROJECT NO. :	AIR 04-3154 C/1
DESIGN FILE NAME:			
IPARM FILE NAME:	S 06	PLOT DATE:	27-JUL-2005
COMMON EXCAVATION			