


THIS DRAWING PRODUCED ON THE NEW ENGLAND REGION MICROSTATION SYSTEM





DEPARTMENT OF TRANSPORTATION

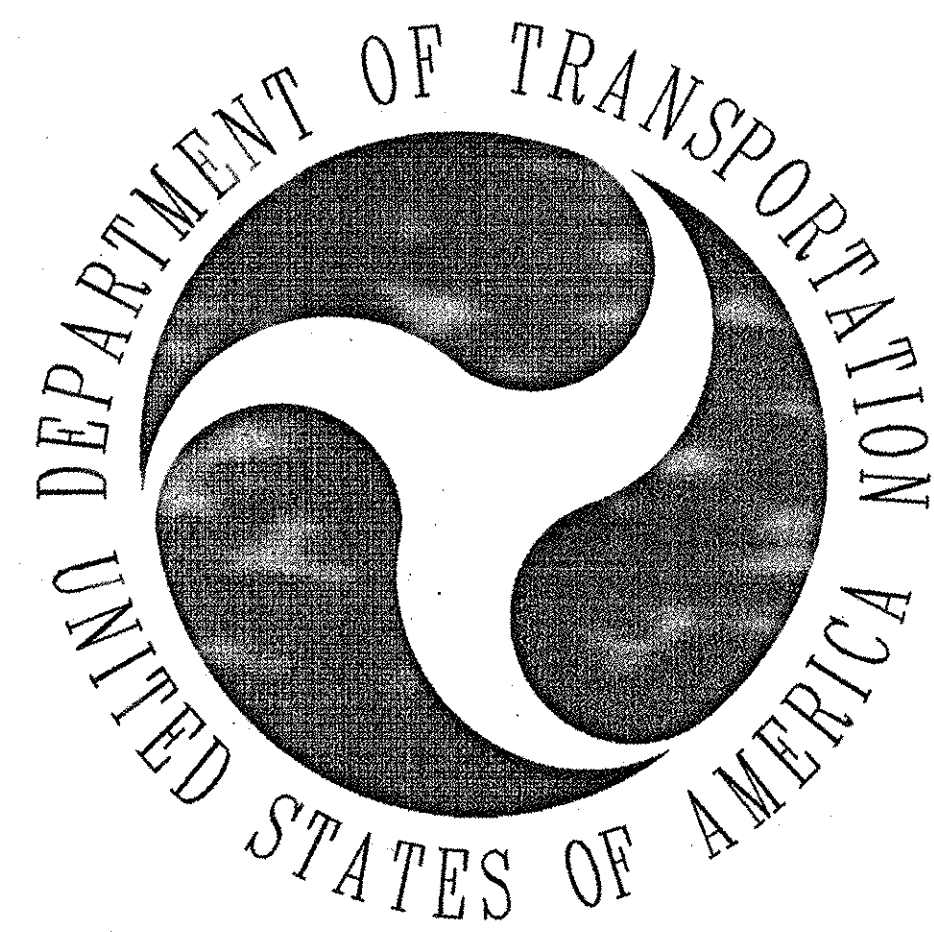


FEDERAL AVIATION ADMINISTRATION

# INSTALLATION OF FAN MARKER (FM) FACILITY SERVING RUNWAY 19 (GL) RUTLAND STATE AIRPORT RUTLAND, VT

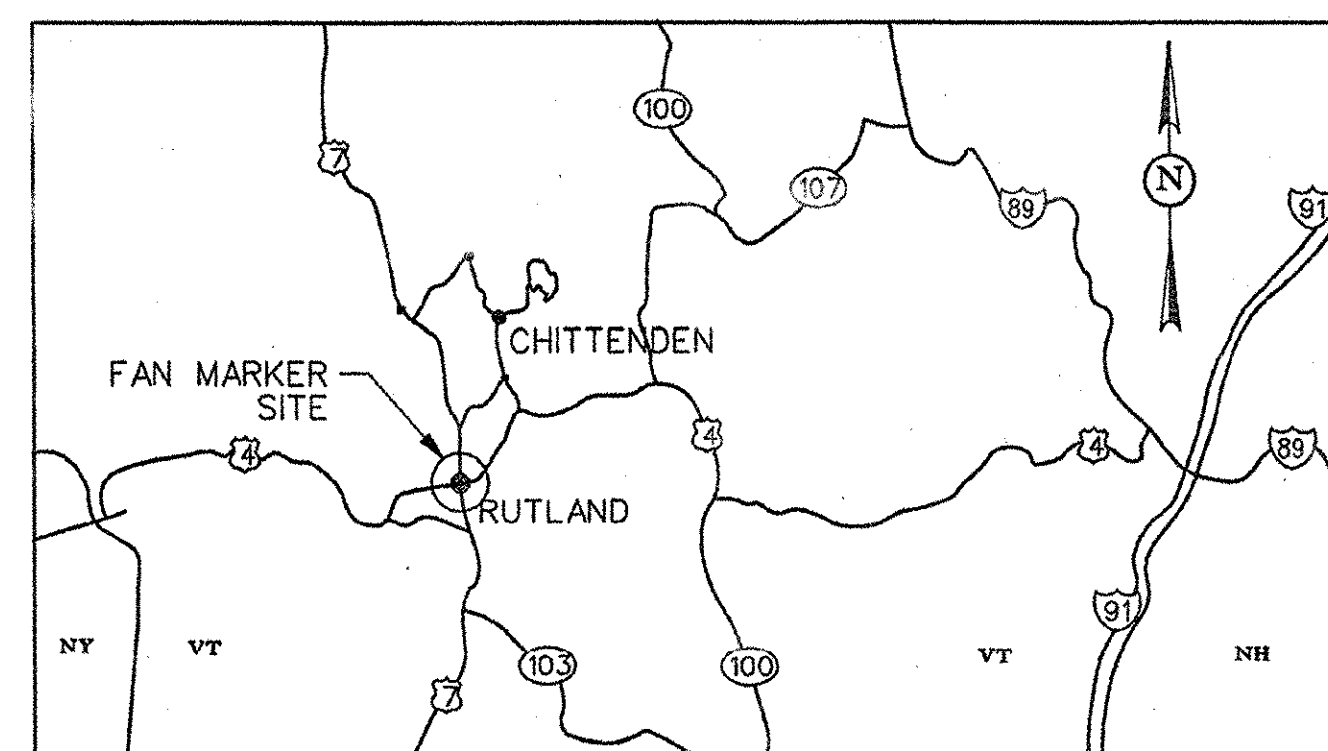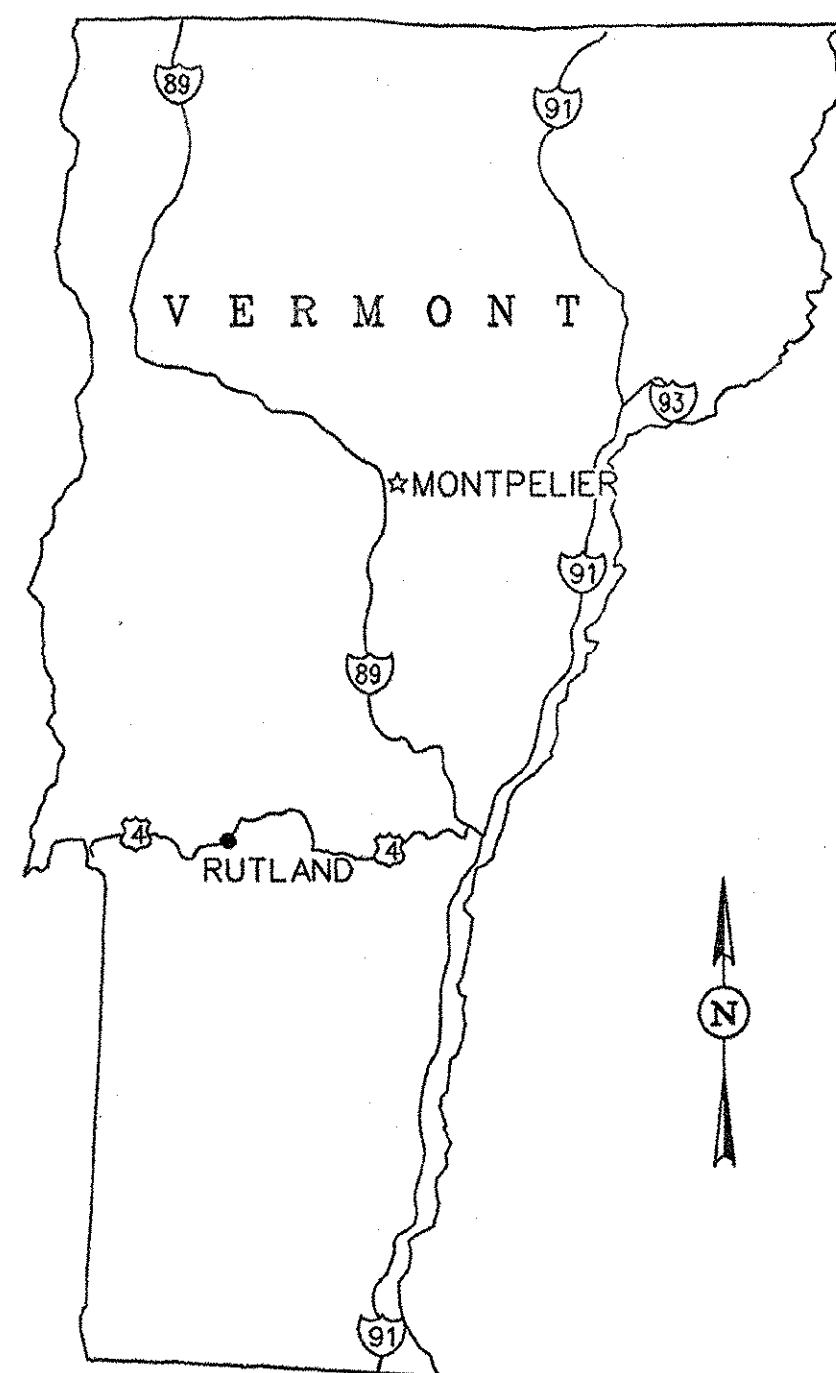

VICINITY PLAN  
NOT TO SCALE

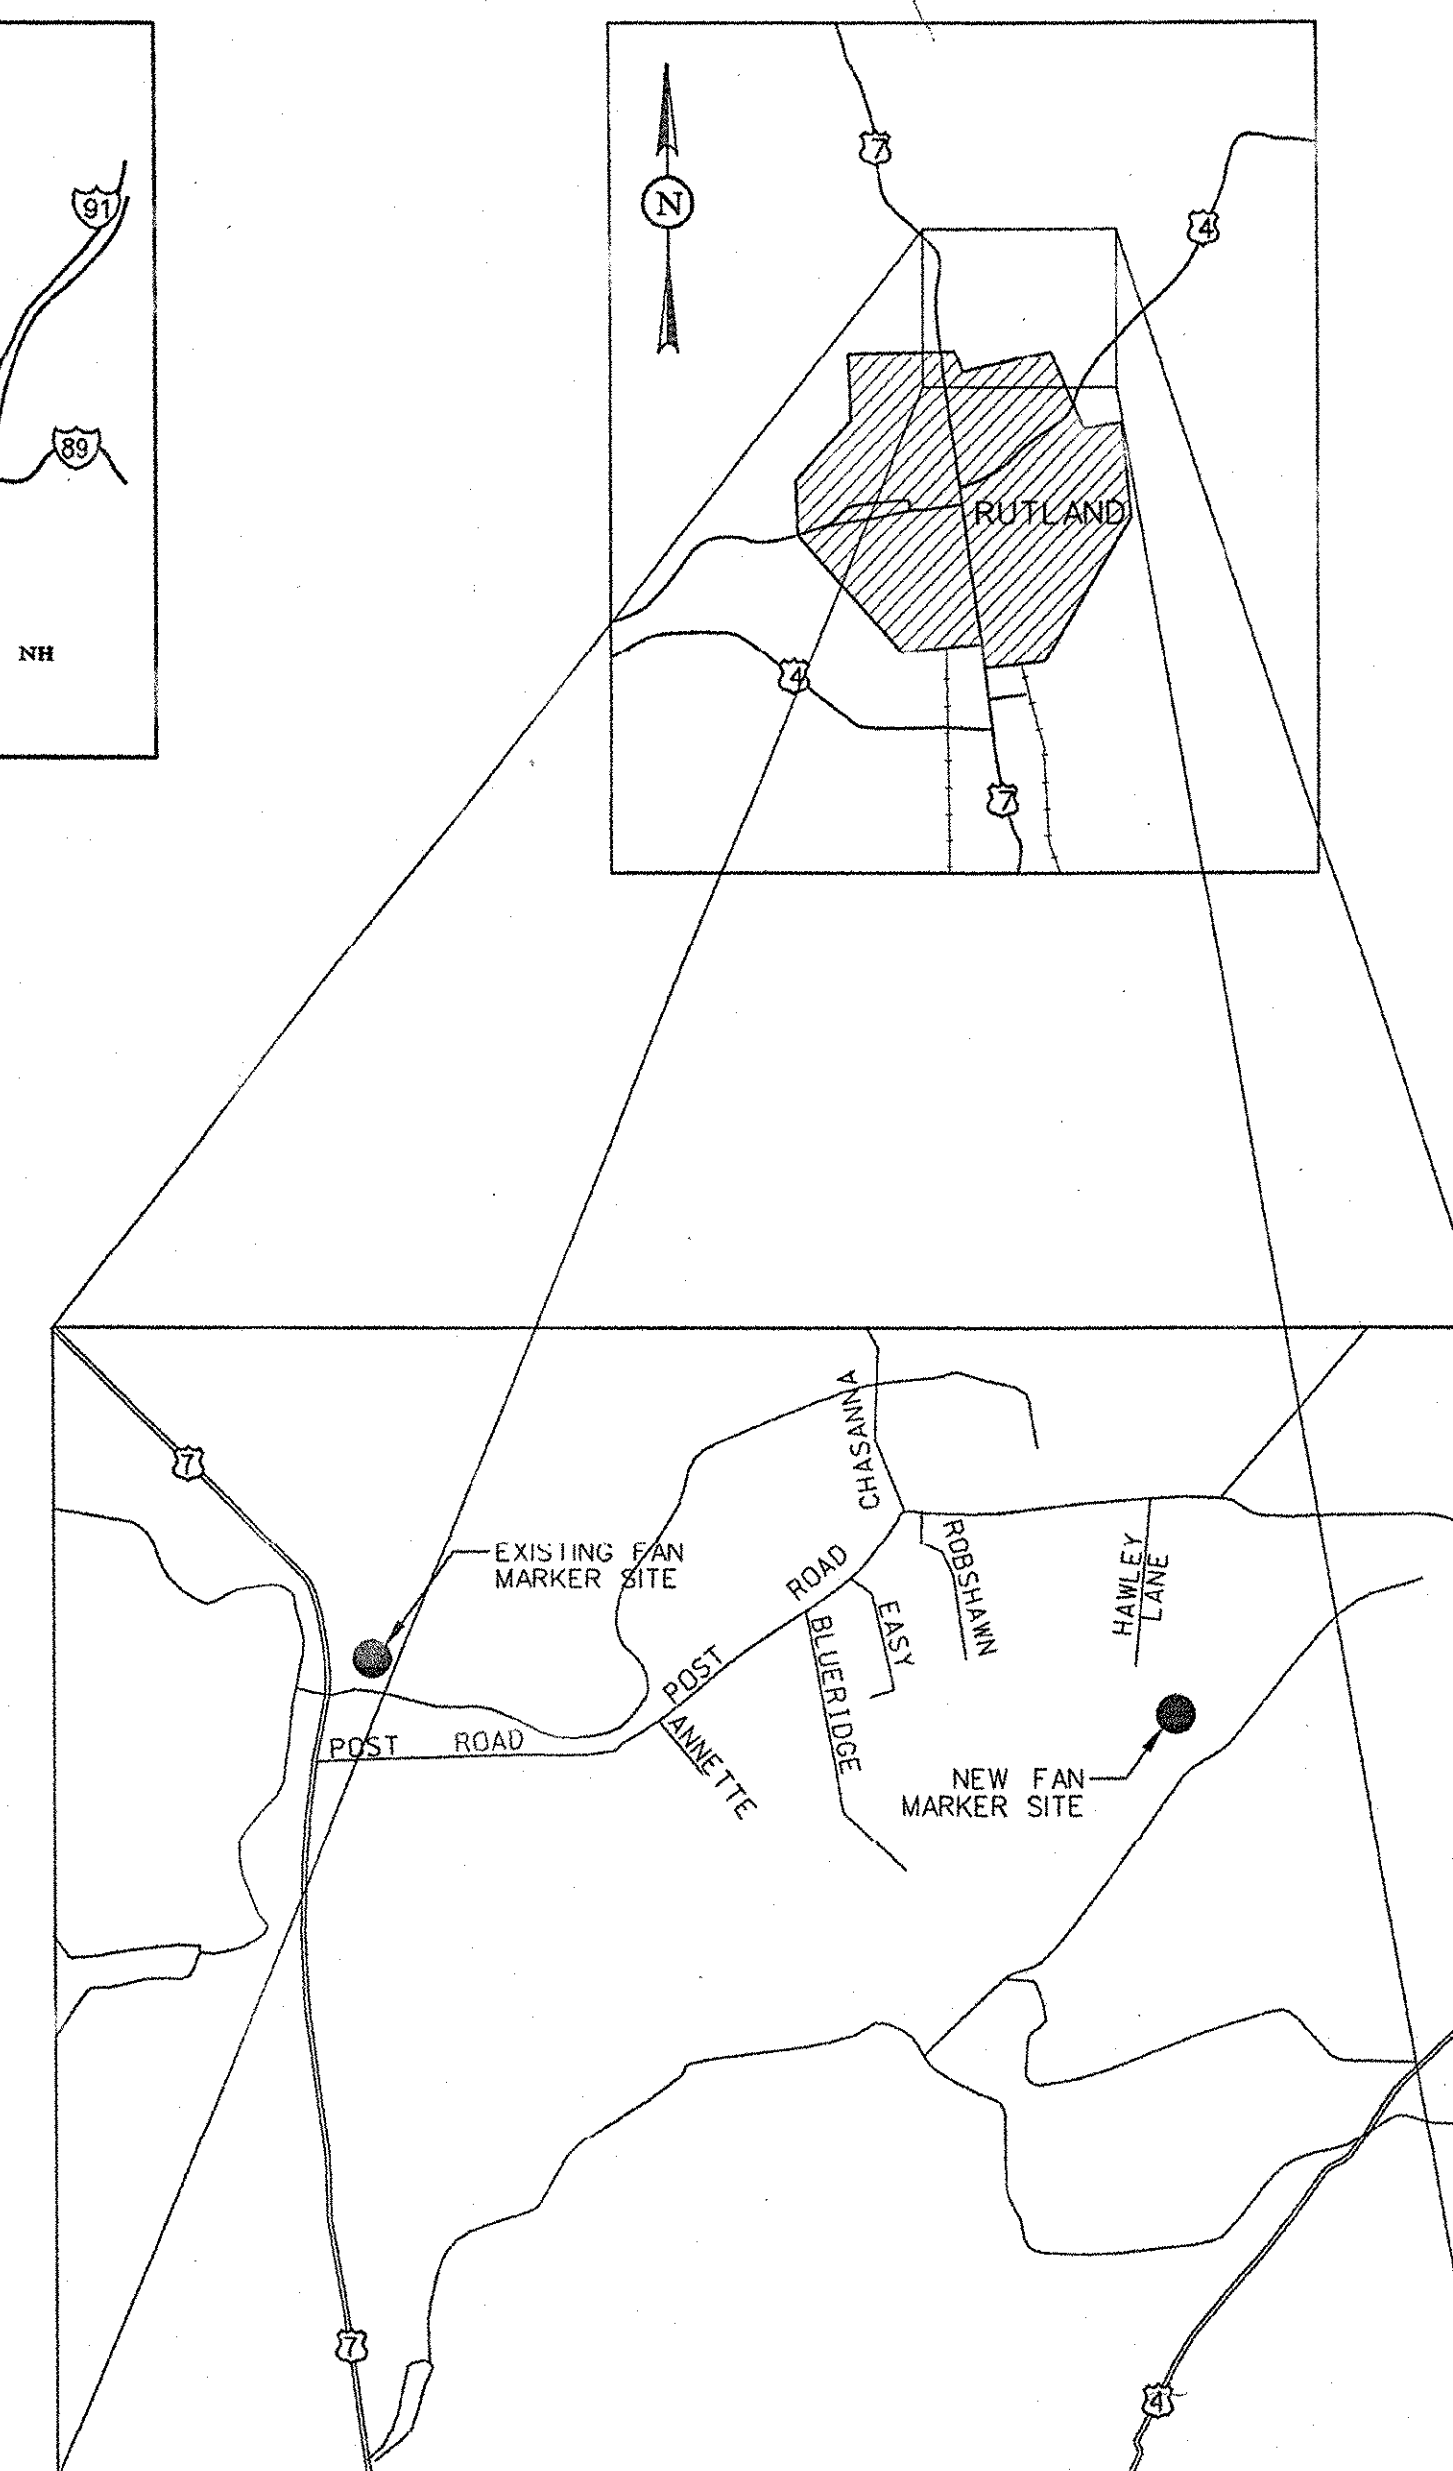

FAN MARKER LOCUS PLAN  
NOT TO SCALE

THIS DRAWING SUPERSEDES DRAWING  
NE-D-27464-000/C, REV 0, DATED 09/04/1998

REV	DATE	DESCRIPTION	JCN	REDLINE DATE	APVD
A	02/14/2002	PROPOSED/WR*6940/sls	3426	01/08/2002	

DEPARTMENT OF TRANSPORTATION  
FEDERAL AVIATION ADMINISTRATION  
BOSTON IMPLEMENTATION CENTER BURLINGTON, MA 01803  
RUNWAY 19 (GL) FAN MARKER (FM)

COVER SHEET

CHITTENDEN	RUTLAND STATE AIRPORT	VT
REVIEWED BY: <i>[Signature]</i>	SUBMITTED BY: <i>[Signature]</i>	APPROVED BY: <i>[Signature]</i>
DESIGNED: D. DAUDIER, ANI-180	ISSUED BY: P. KIRBY, ANI-180	DATE: 02/08/2002
DRAWN: sls	CHECKED: sls	JCN: 3426
NAS IMPLEMENTATION ANI-100		REV: A
NE-D-27464-G000		

02/14/2002 02:53:18 PM annulshd