





CONSTRUCTION PHASING
REFER TO THE CONSTRUCTION PHASING PLAN ON SHEET 9.

WALL IS ELIMINATED
SEE PAGE 18 / 27

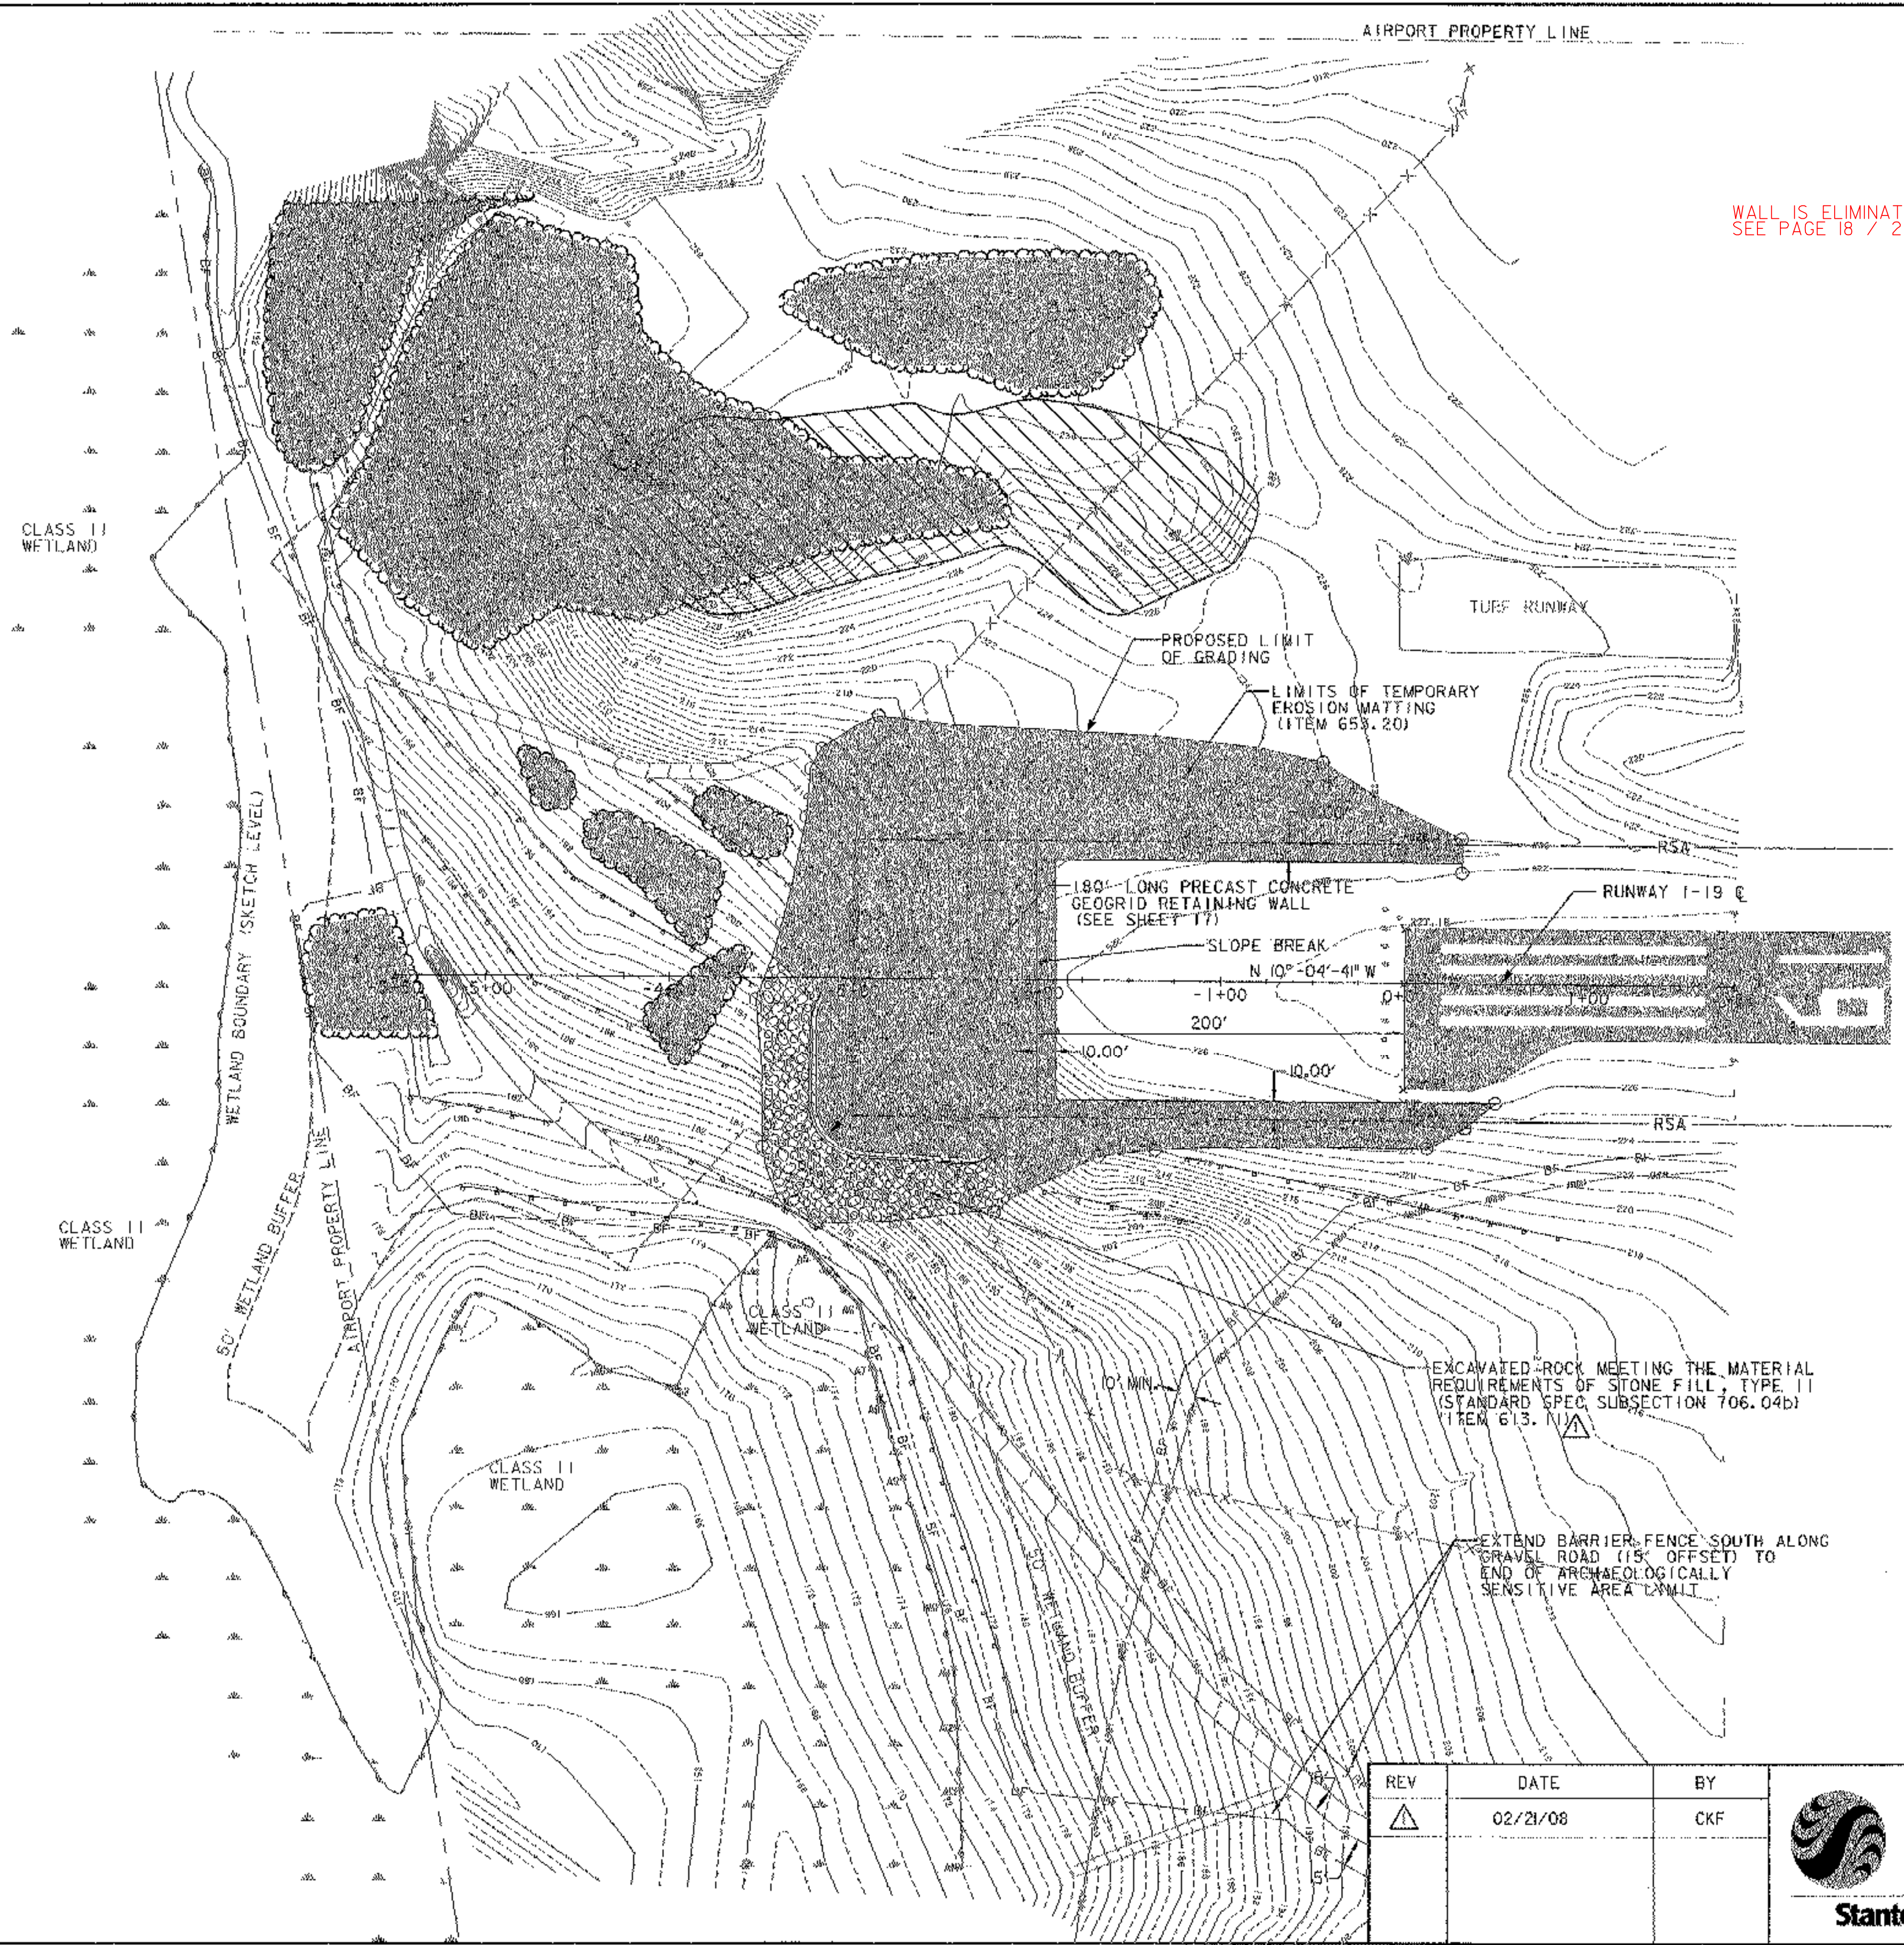

- LEGEND**
- GROUND PENETRATION AREA (ITEM 203.16 - SOLID ROCK EXCAVATION)
 - TREE PENETRATION AREAS (ITEM 201.10 - CLEARING AND GRUBBING, INCLUDING INDIVIDUAL TREES & STUMPS)
 - SILT FENCE (ITEM 649.51)
 - ARCHAEOLOGICALLY SENSITIVE AREA LIMIT
 - BARRIER FENCE (ITEM 653.50)
 - RUNWAY SAFETY AREA

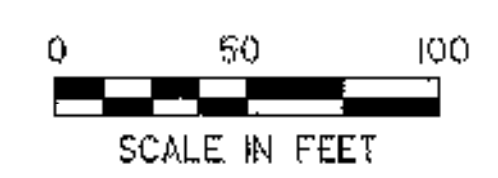

REV	DATE	BY
△	02/21/08	CKF



PROJECT NAME: HIGHGATE
PROJECT NUMBER: AIR 04-3183

FILE NAME: EROSION CONTROL PLAN.DGN PLOT DATE: 2/21/2008
PROJECT LEADER: M. CHURCHILL DRAWN BY: J. OAKMAN
DESIGNED BY: P. ENZIEN CHECKED BY: P. ENZIEN
EROSION PREV. & SED. CONTROL PLAN SHEET 10 OF 27