



THIS PAGE NO LONGER APPLICABLE

PLAN VIEW
SCALE IN FEET

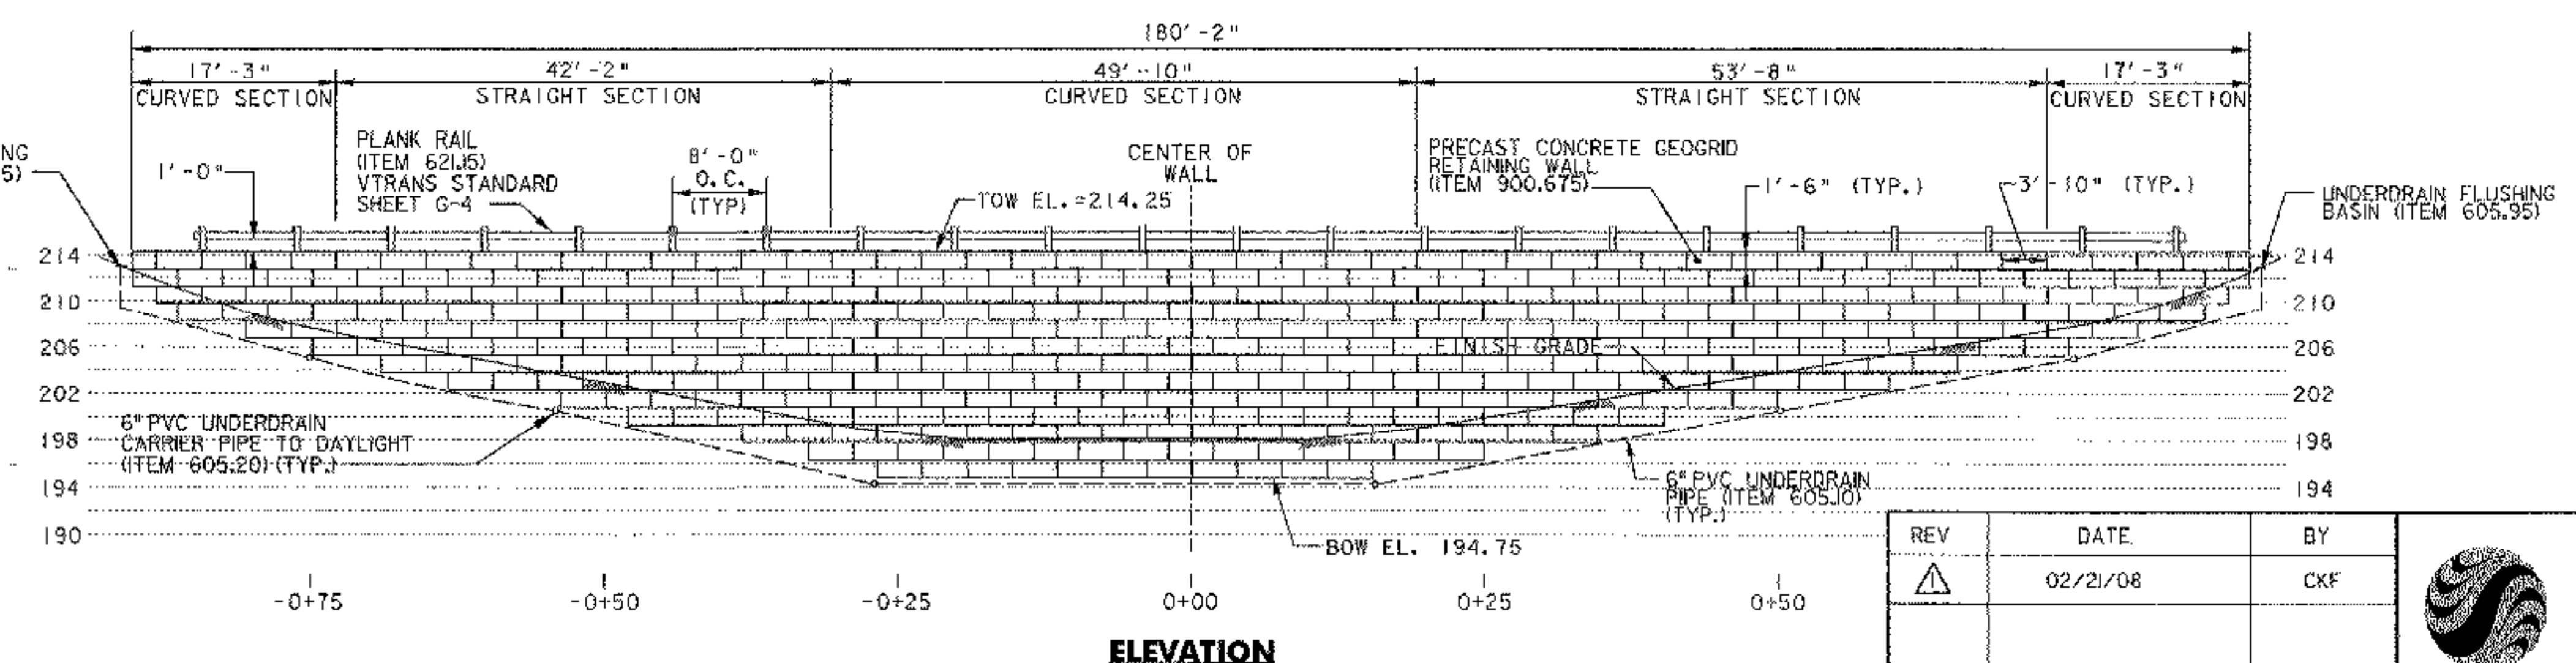

REV	DATE	BY
△	02/21/08	CKF

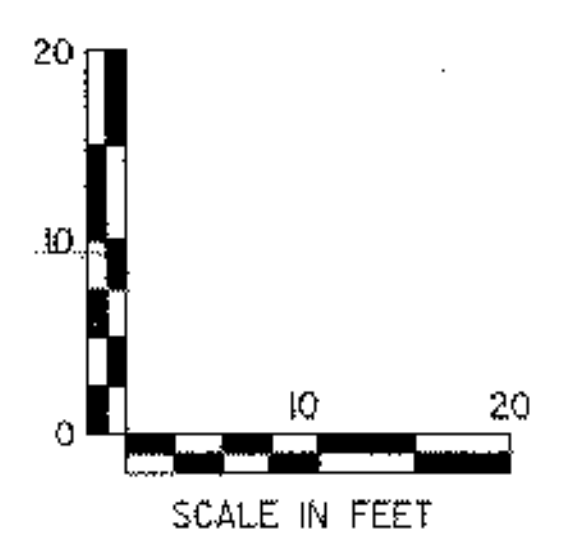

PROJECT NAME: HIGHGATE
PROJECT NUMBER: AIR 04-3183
FILE NAME: WALL PLAN.DGN
PROJECT LEADER: M. CHURCHILL
DESIGNED BY: P. ENZIEN
RETAINING WALL PLAN & ELEVATION SHEET 17 OF 27
PLOT DATE: 2/21/2008
DRAWN BY: J. OAKMAN
CHECKED BY: P. ENZIEN