

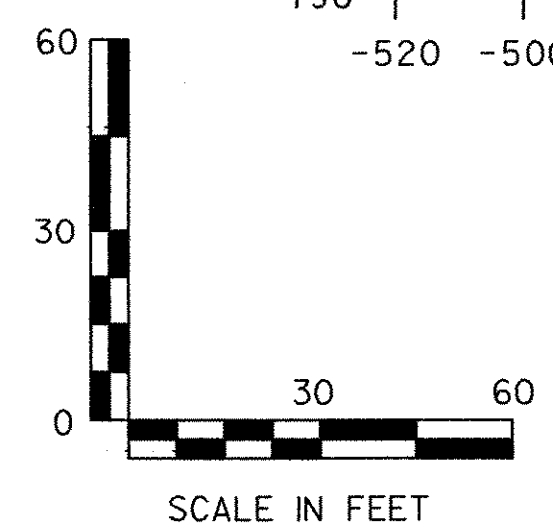
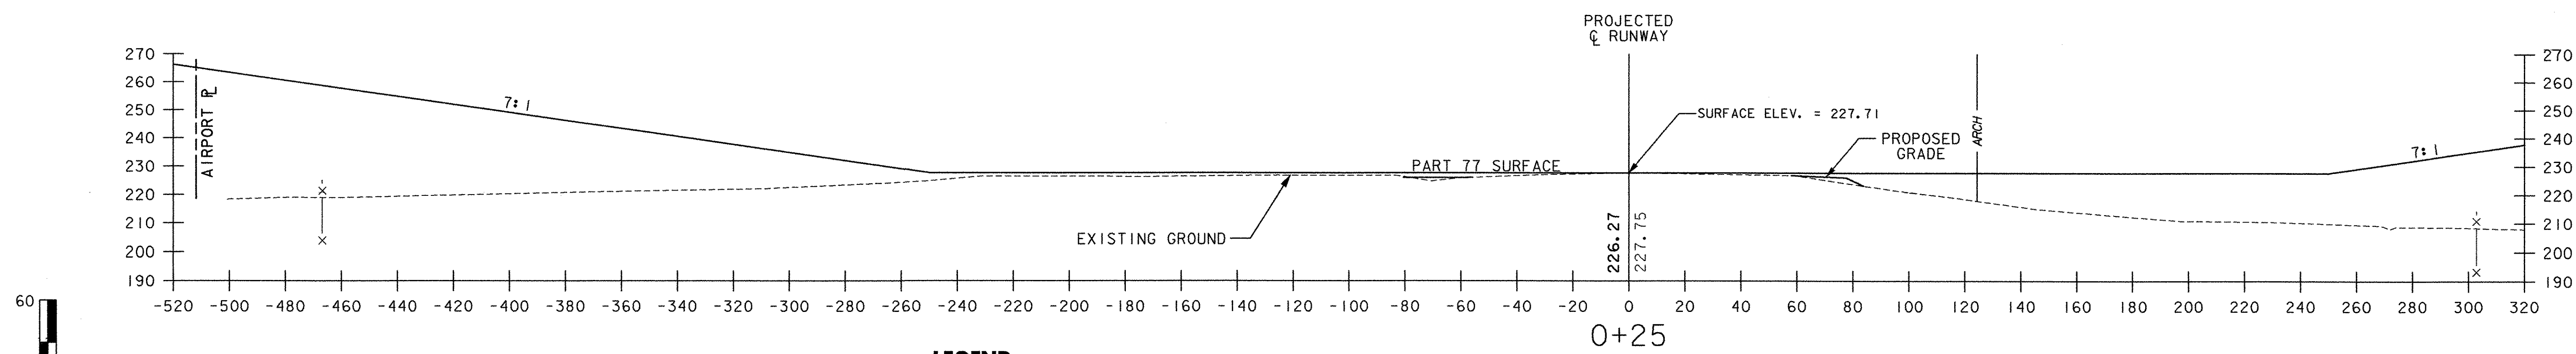
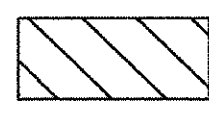
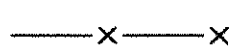


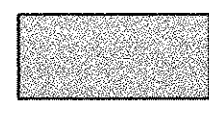


NOTED: REVISIONS
 1. 12/20/2007
 2. 12/20/2007
NOTED: REVISIONS
 1. 12/20/2007
 2. 12/20/2007
 3. 12/20/2007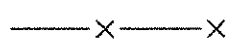
LEGEND

	GROUND PENETRATION AREA (SOLID ROCK EXCAVATION)		LOCATION OF PROPOSED 6' HIGH CHAIN LINK FENCE
	TREE PENETRATION AREAS (CLEARING AND GRUBBING)		EXISTING CHAIN LINK FENCE
	LIMIT OF CLEARING AND GRUBBING		CLASS II WETLAND BOUNDARY
			ARCHAEOLOGICALLY SENSITIVE AREA LIMIT



PROJECT NAME: HIGHGATE		PLOT DATE: 12/20/2007	
PROJECT NUMBER: AIR 04-3183		DRAWN BY: J. OAKMAN	
FILE NAME: CROSS SECTIONS.DGN	PROJECT LEADER: M. CHURCHILL	DESIGNED BY: P. ENZIEN	CHECKED BY: P. ENZIEN
CROSS SECTION SHEET 9		SHEET 27 OF 27	