


NOTE:
1. SEE SHEETS 10, 14 & 15 FOR LOCATIONS.

TYPICAL RUNWAY HOLDING POSITION MARKINGS
NOT TO SCALE


1
5

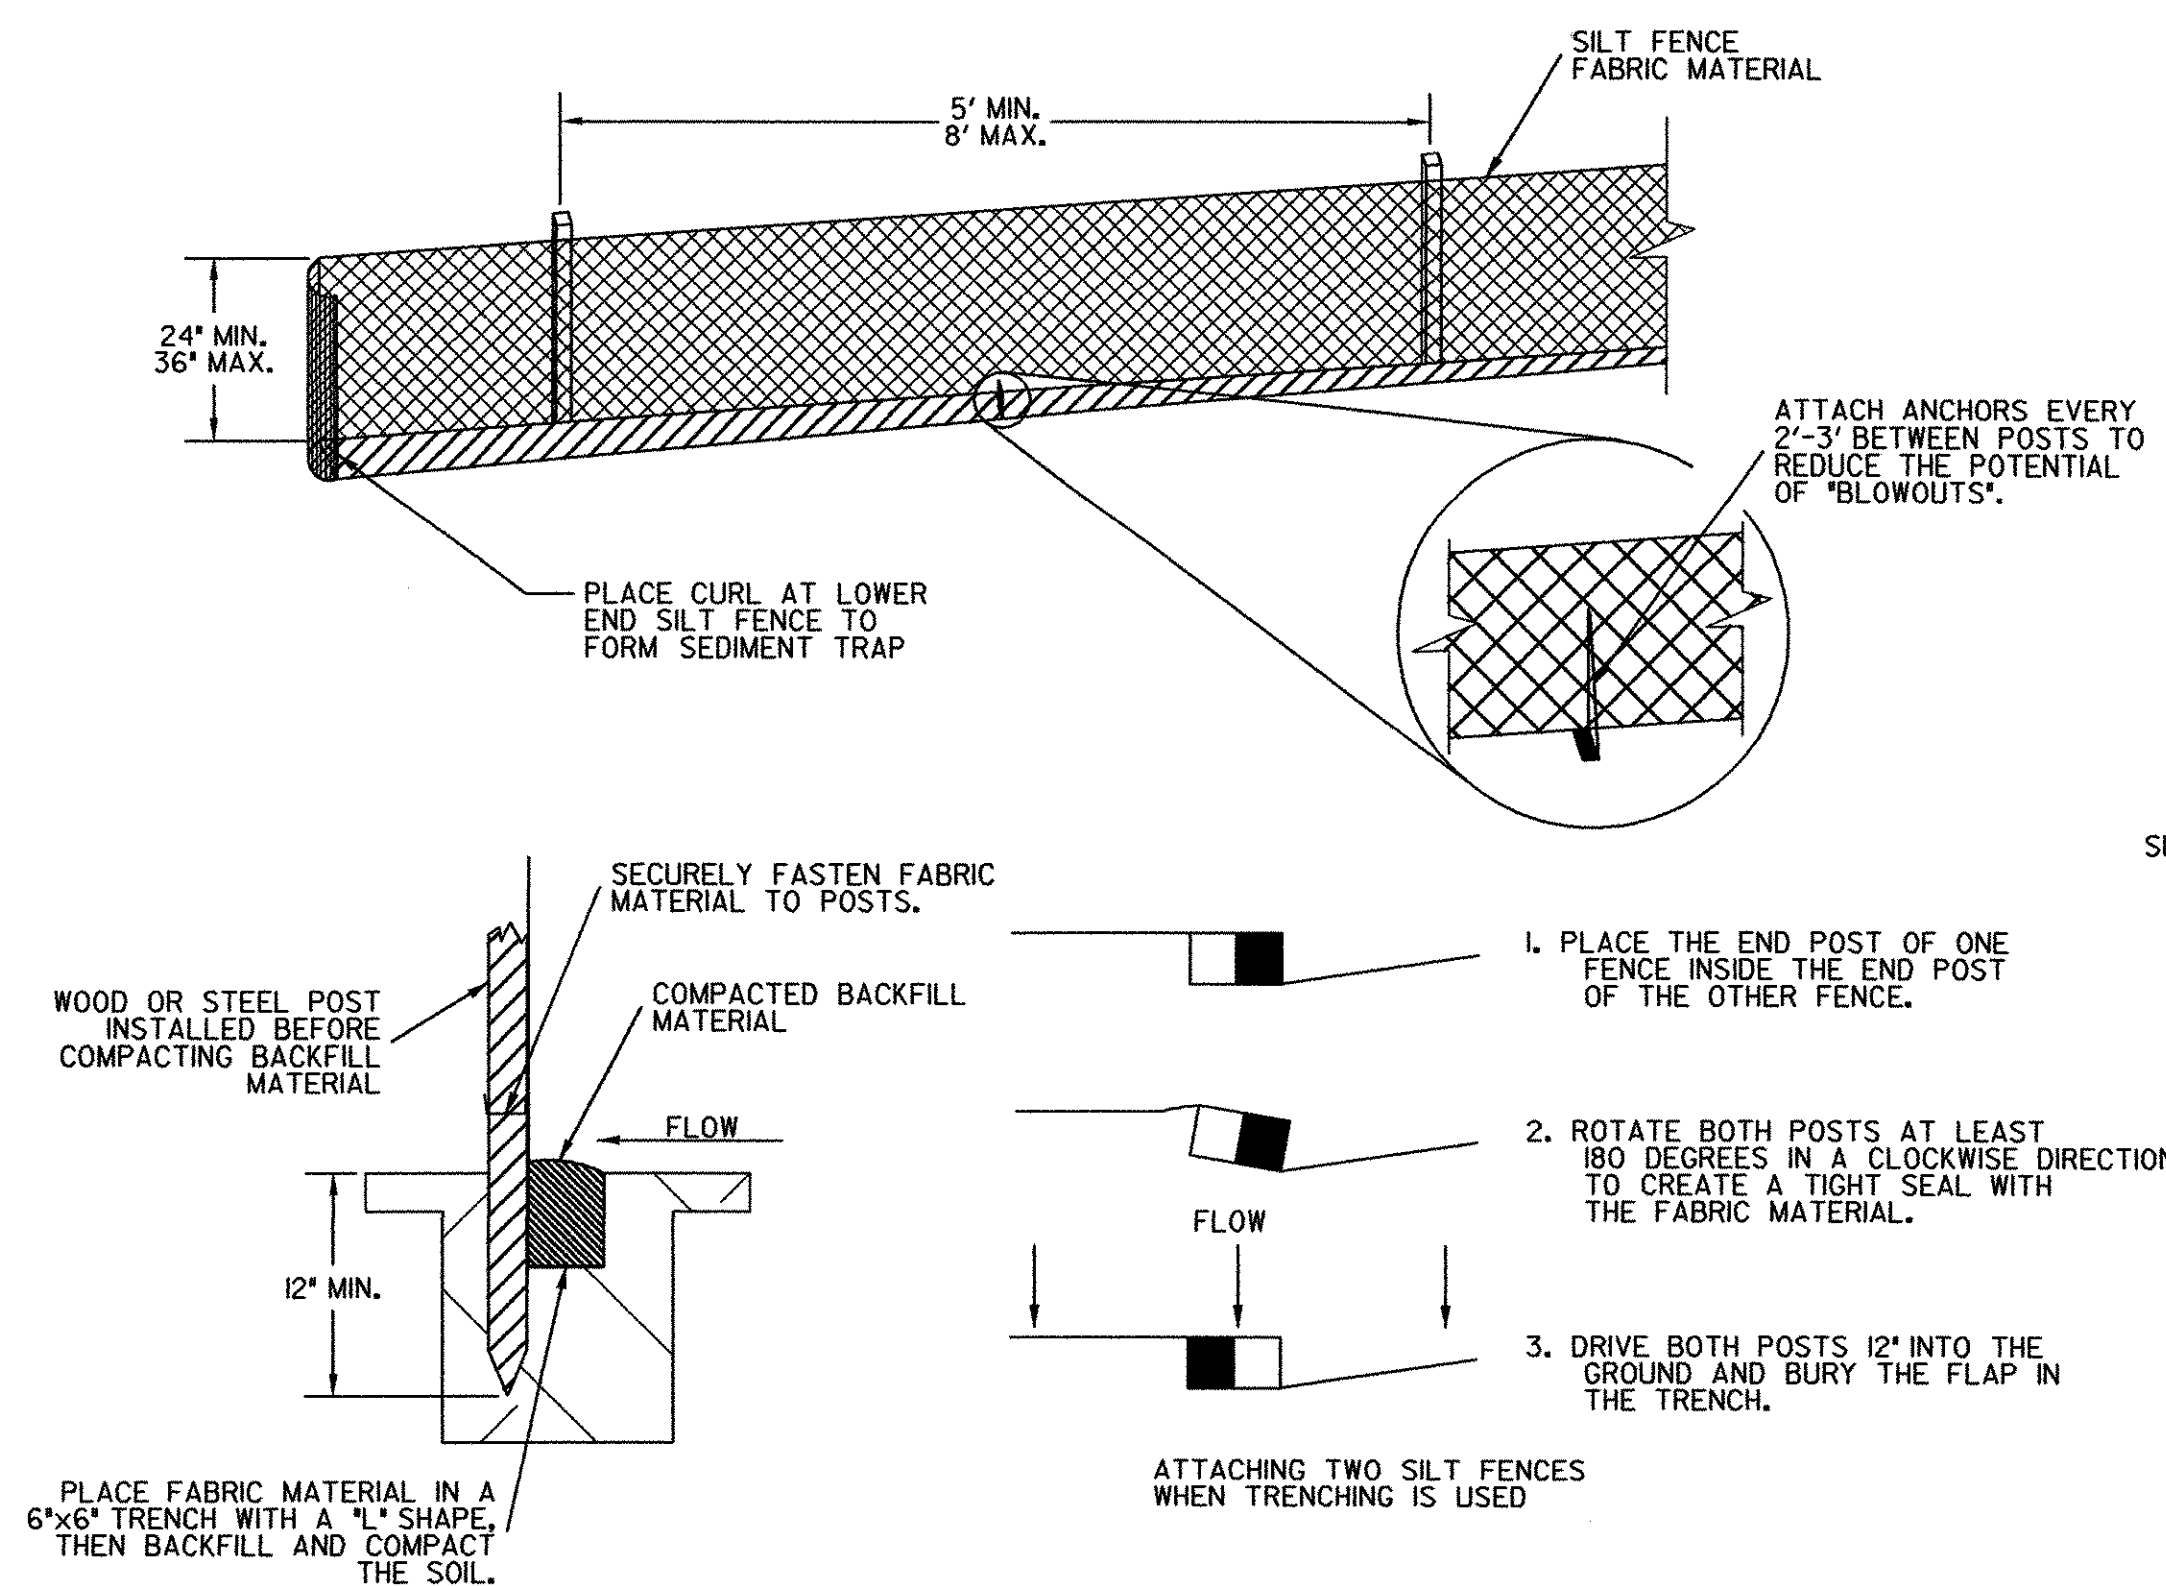

SILT FENCE

NOT TO SCALE


3
5

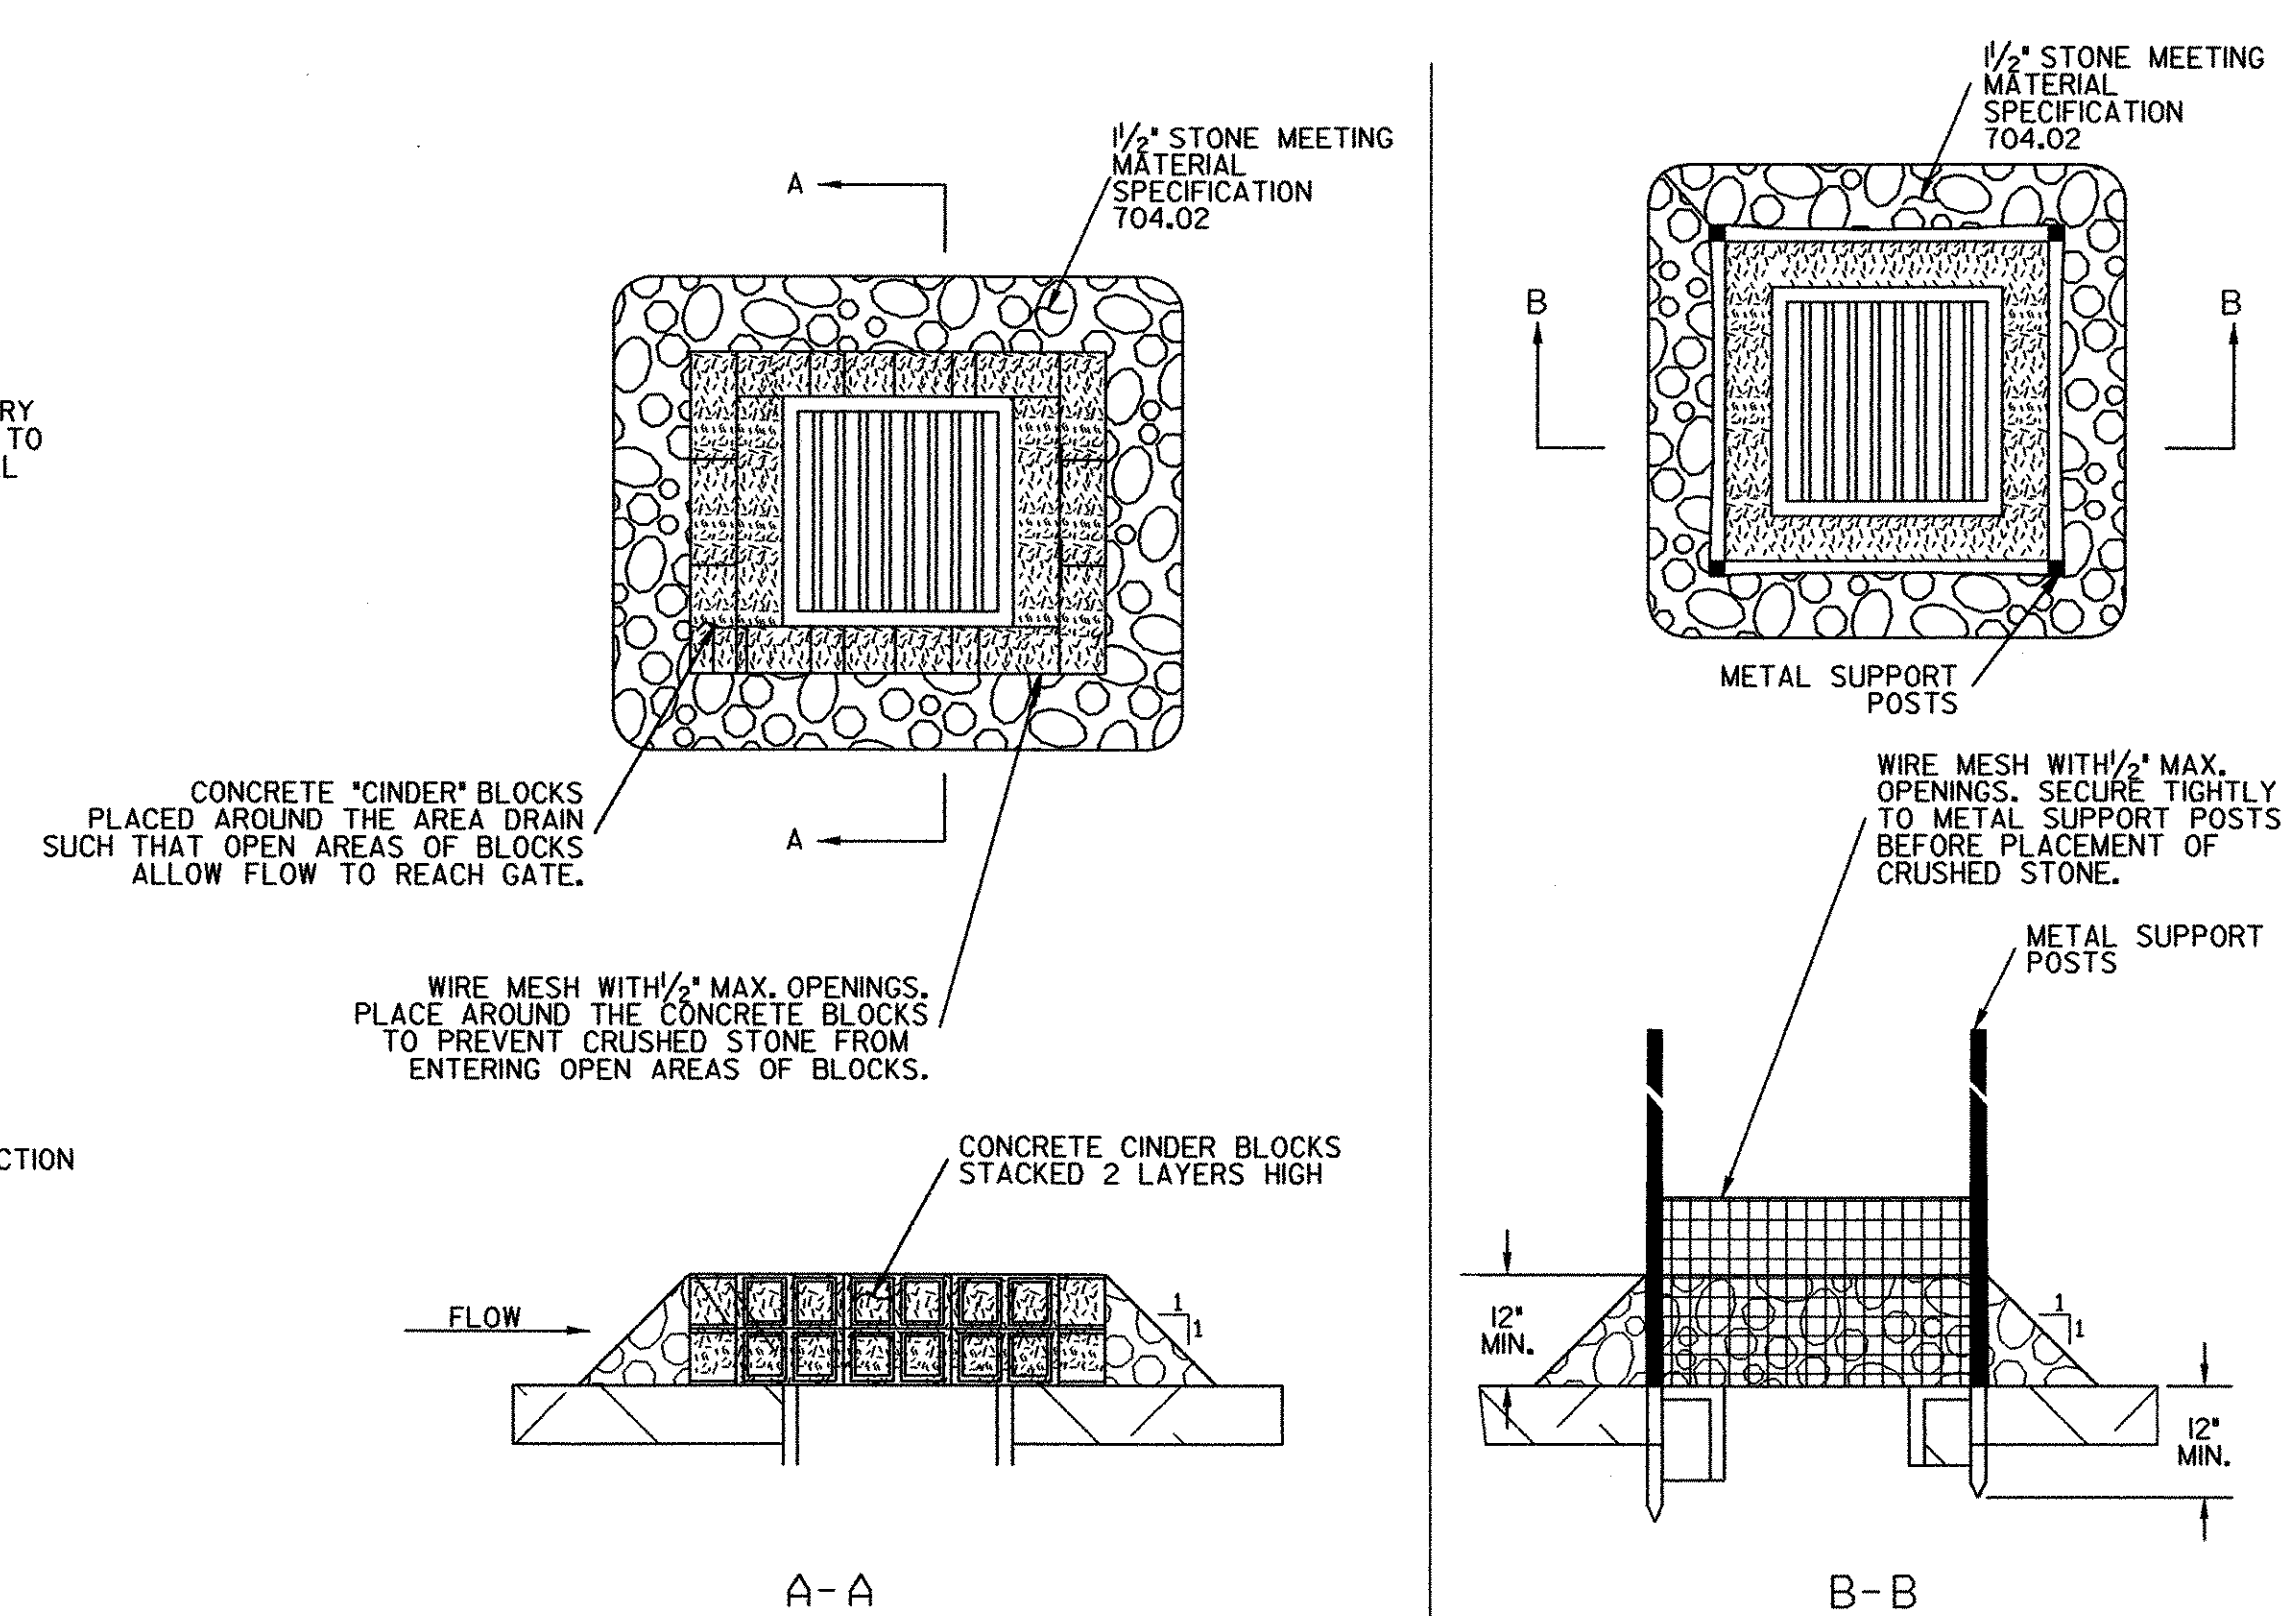

ROCK BARRIER INLET PROTECTION

NOT TO SCALE


5
5

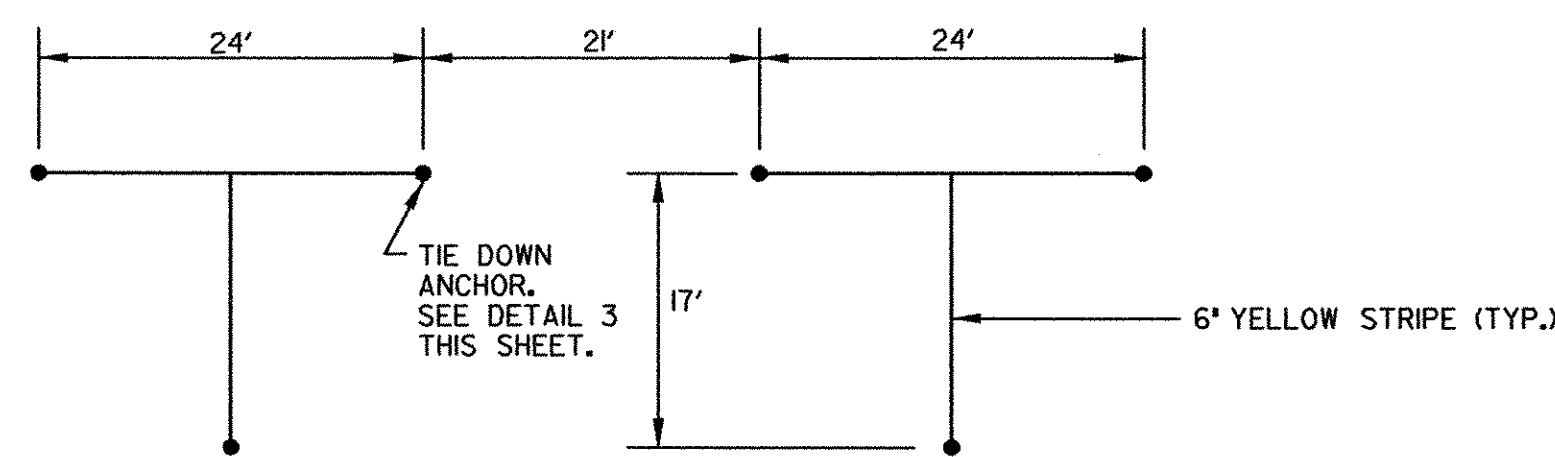

NOTE:
1. SEE SHEETS 14 & 15 FOR LOCATIONS.

AIRCRAFT TIE-DOWN MARKING DETAIL
NOT TO SCALE


2
5

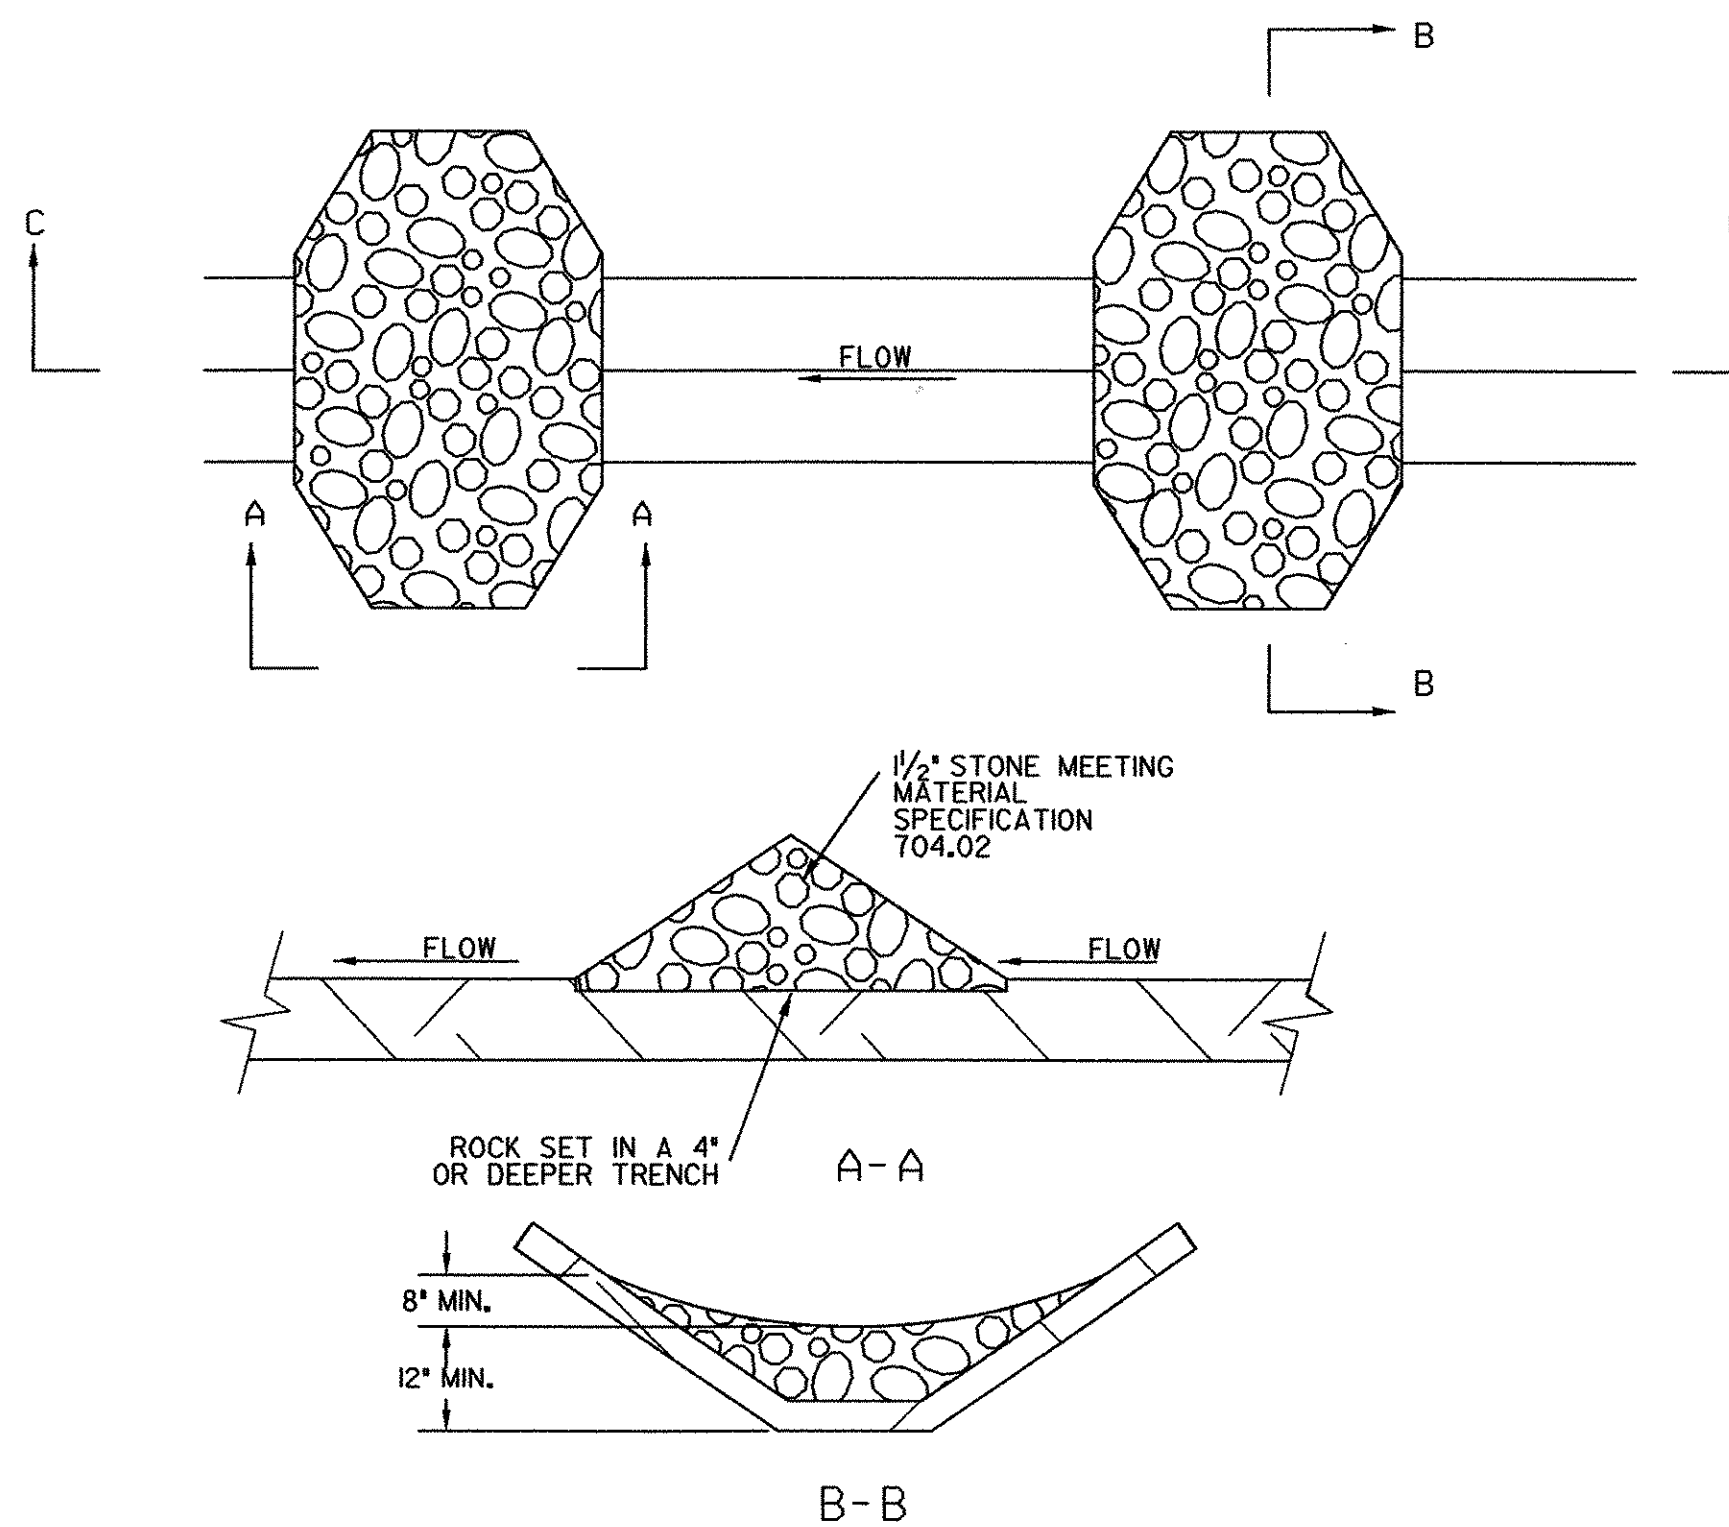

STONE CHECK DAM

NOT TO SCALE

4
5

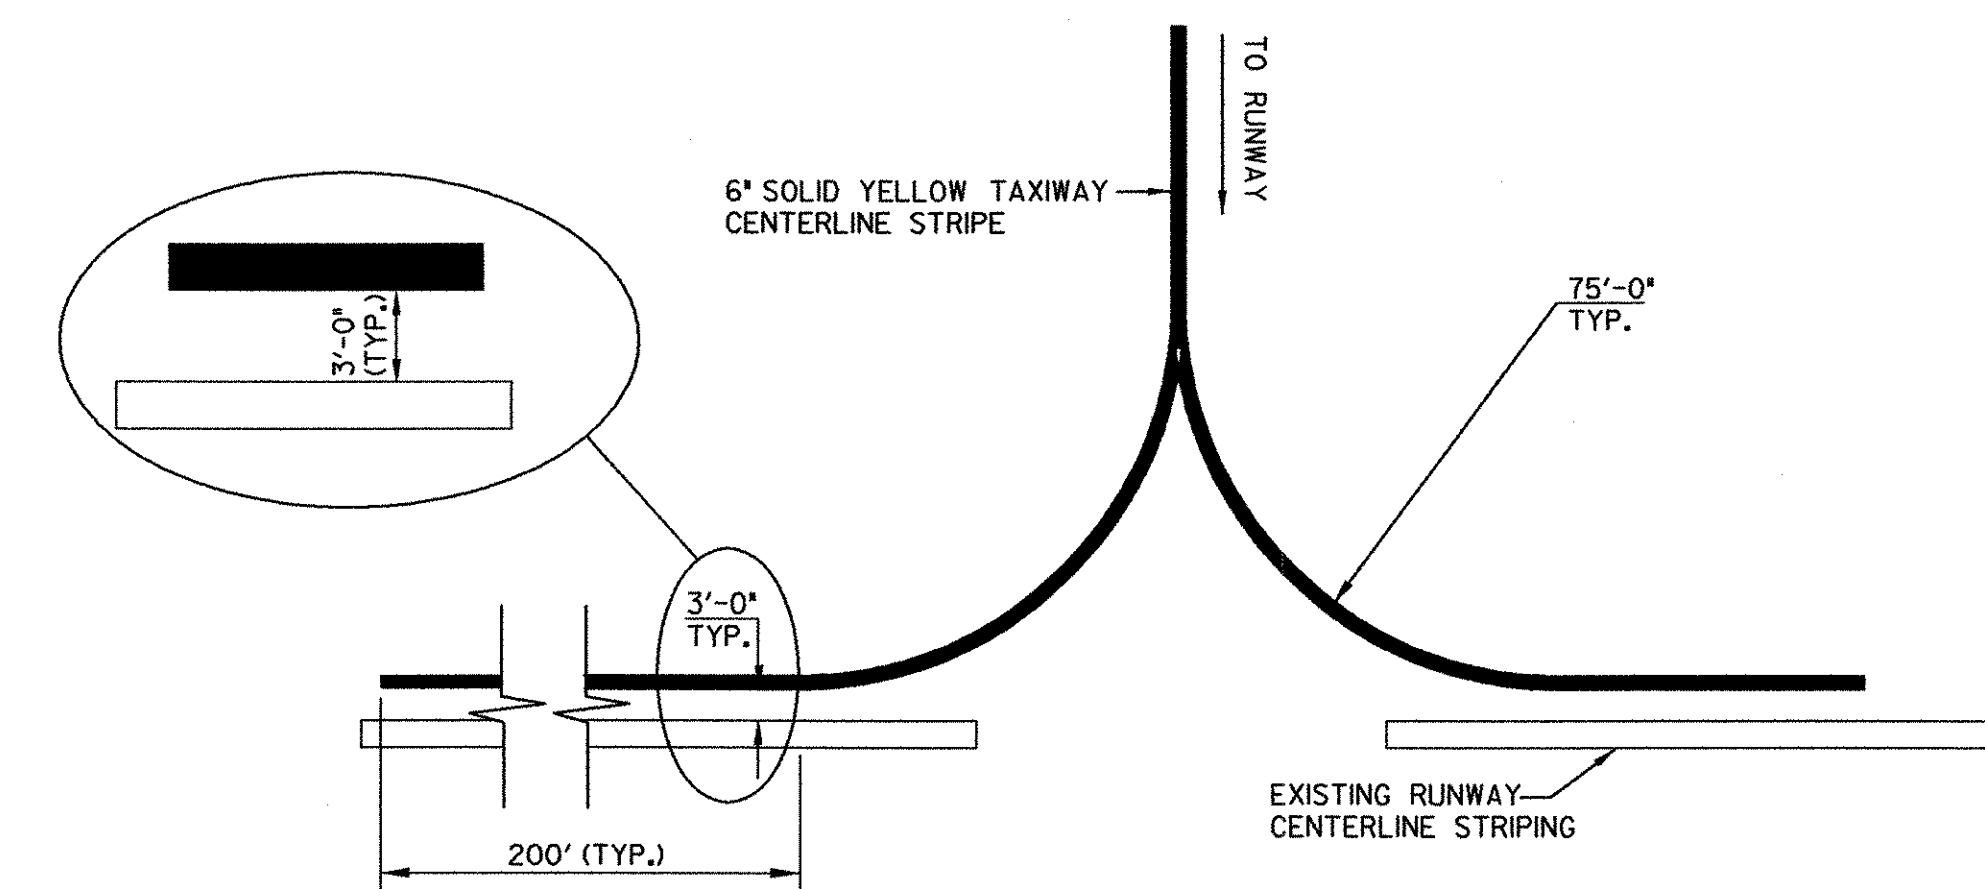

NOTE:
1. SEE SHEETS 14 & 15 FOR LOCATIONS.

TAXIWAY/RUNWAY STRIPING DETAIL
NOT TO SCALE

6
5



PROJECT NAME: SPRINGFIELD AIR
PROJECT NUMBER: 04-3161

FILE NAME: hartness frn.dgn
PROJECT LEADER: JBL
DESIGNED BY: TPL
EROSION AND STRIPING DETAILS

PLOT DATE: 05/21/2003
DRAWN BY: TPL
CHECKED BY: JBL
SHEET 5 OF 17