

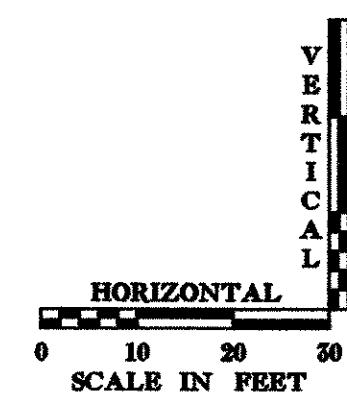


PIPE 2 PROFILE

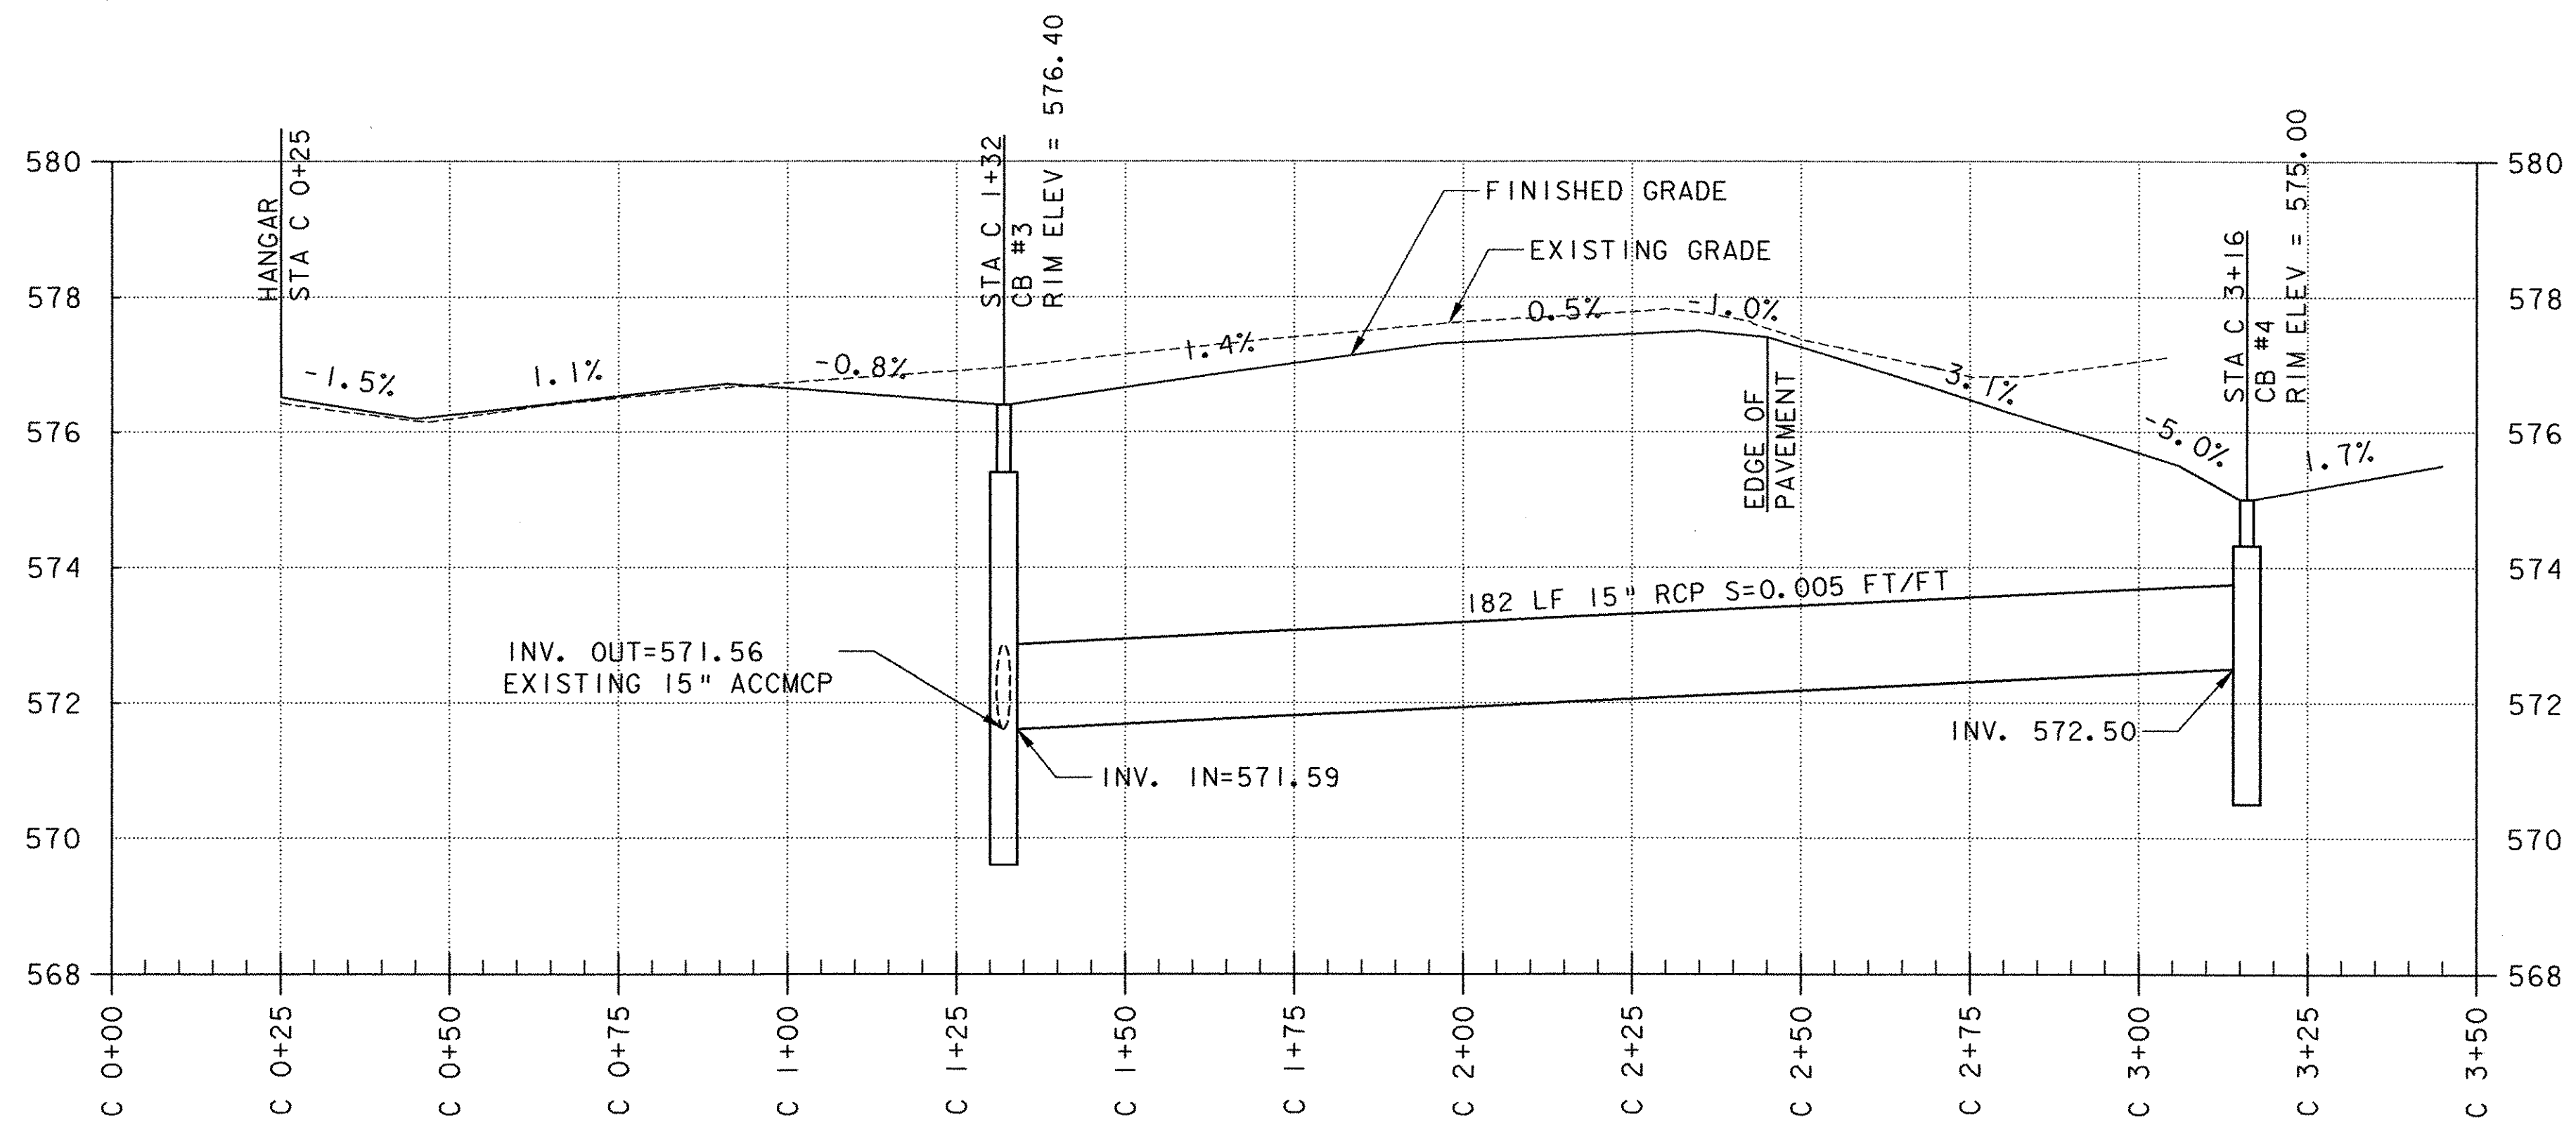

PIPE 10 PROFILE

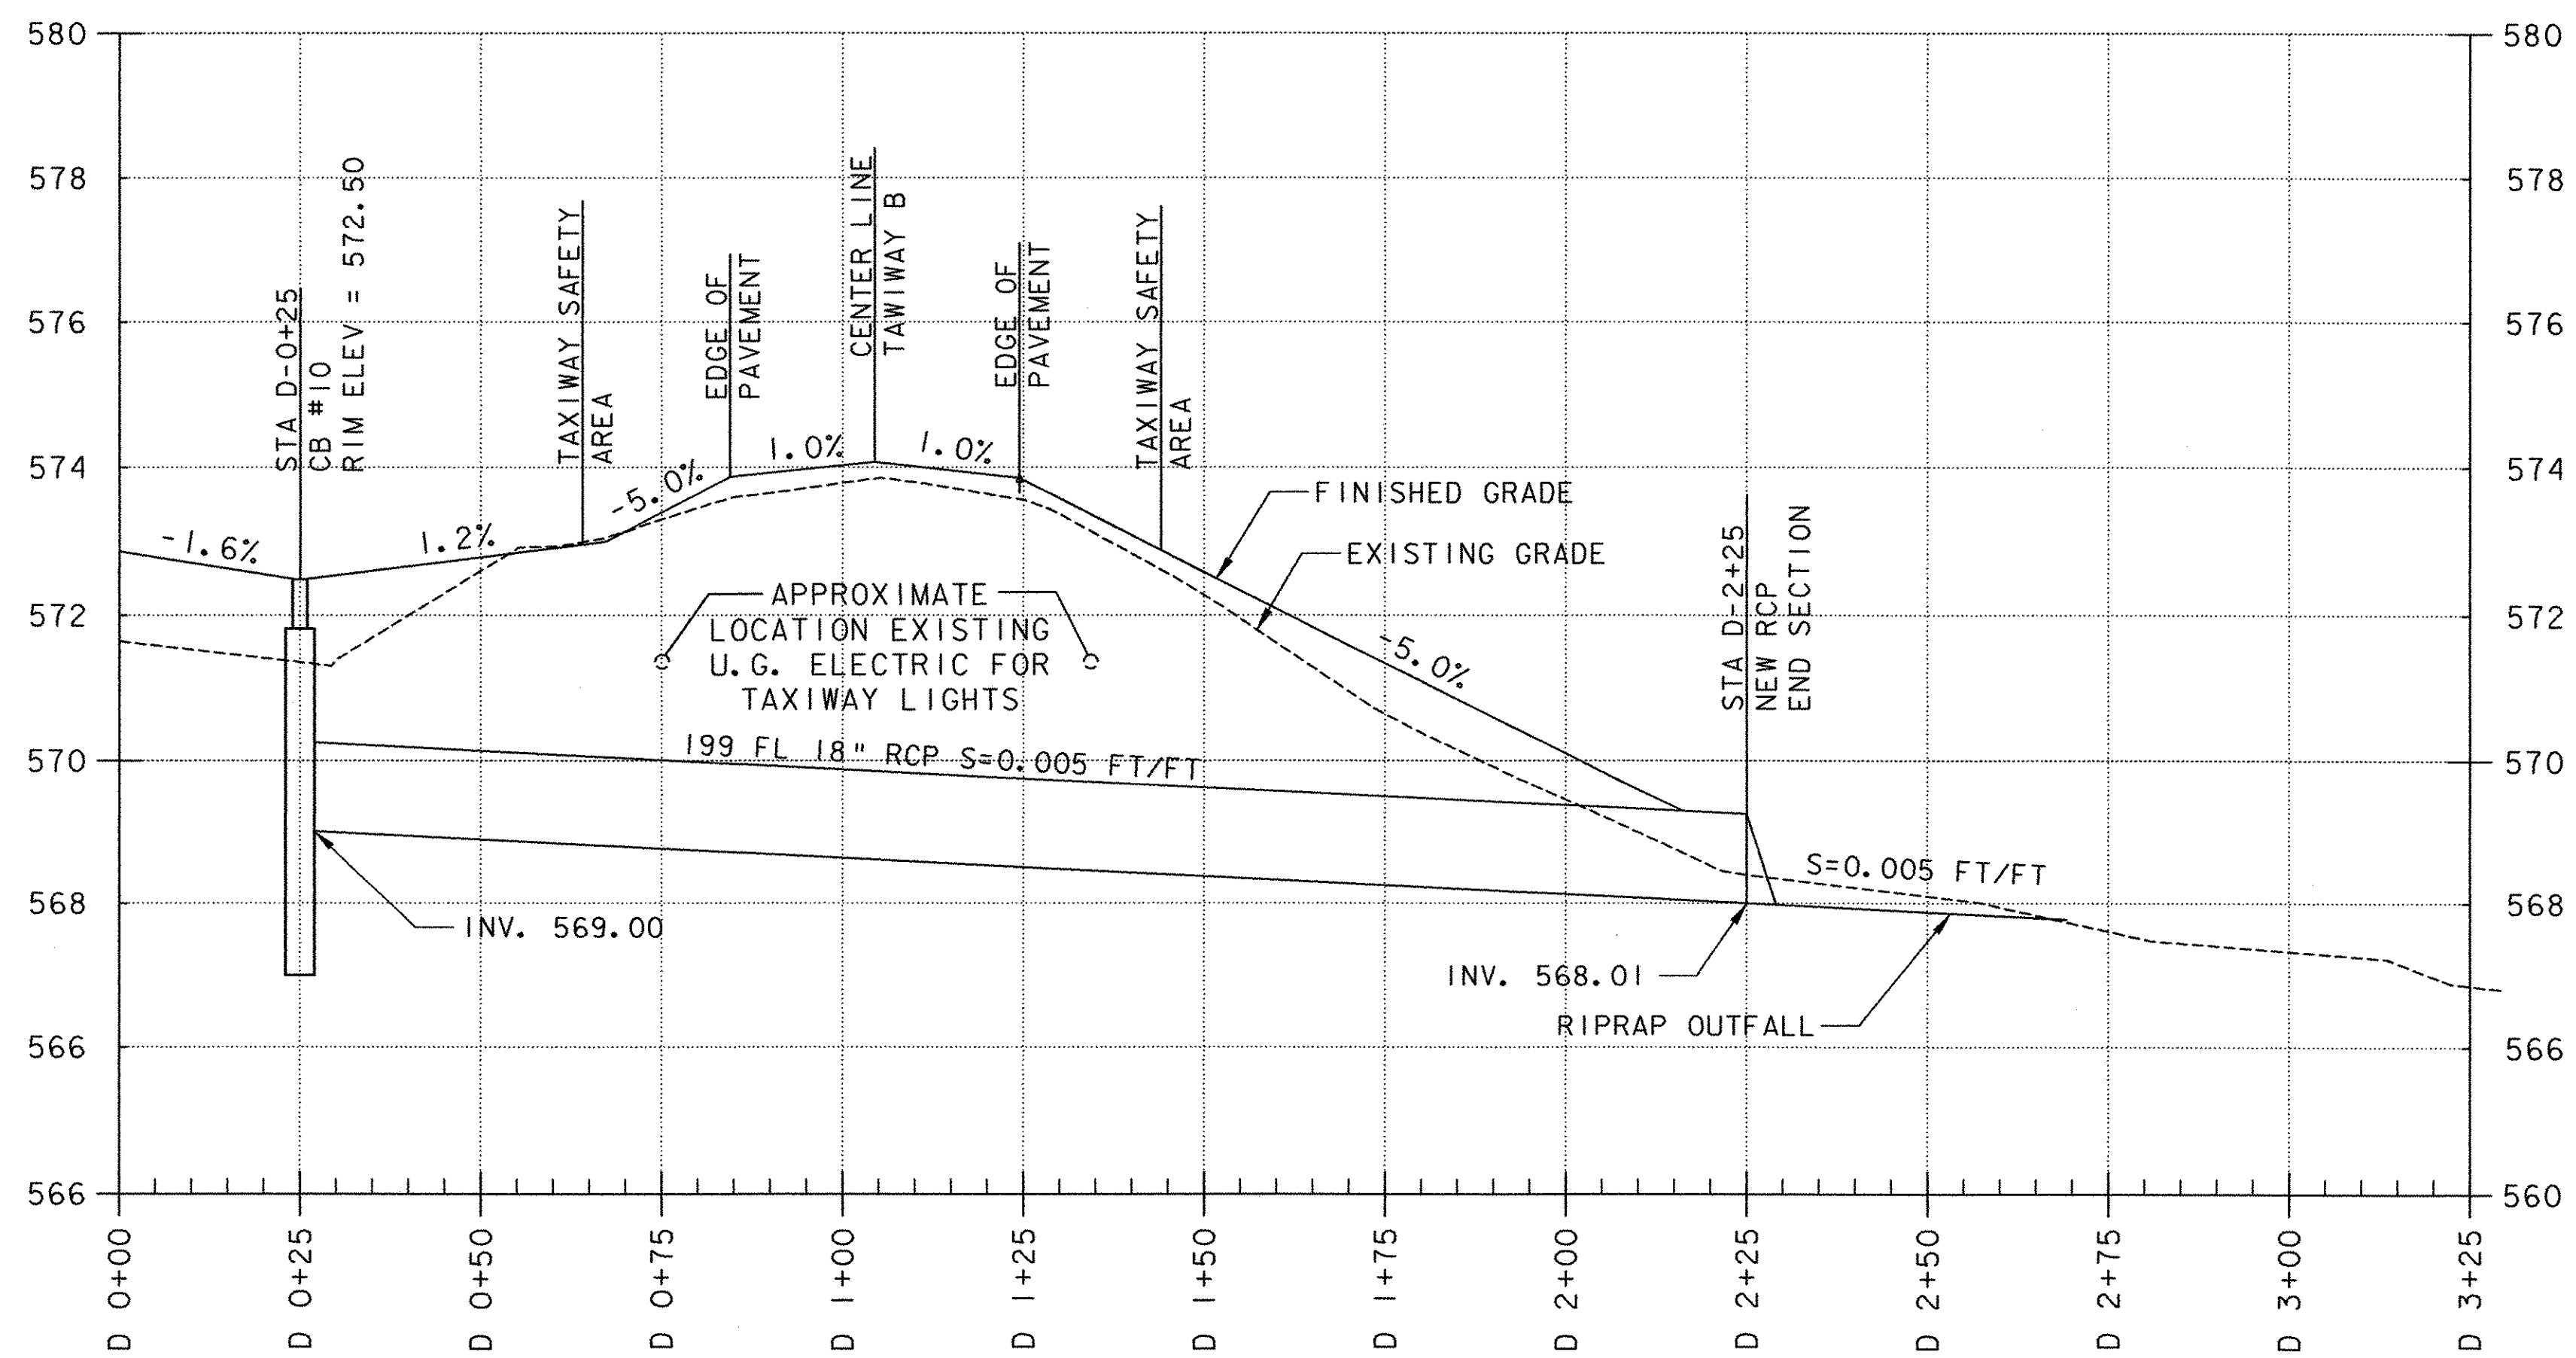

PROJECT NAME:	SPRINGFIELD AIR
PROJECT NUMBER:	04-3161
FILE NAME:	hartness xls.dgn
PROJECT LEADER:	JBL
DESIGNED BY:	MCS
CHECKED BY:	MCS
PLOT DATE:	05/21/2003
DRAWN BY:	TPL
CHECKED BY:	MCS
SHEET	16 OF 17

\\p01f1\des\sections\05212003\10-46-01.dwg