



TAXIWAY-A PROFILE

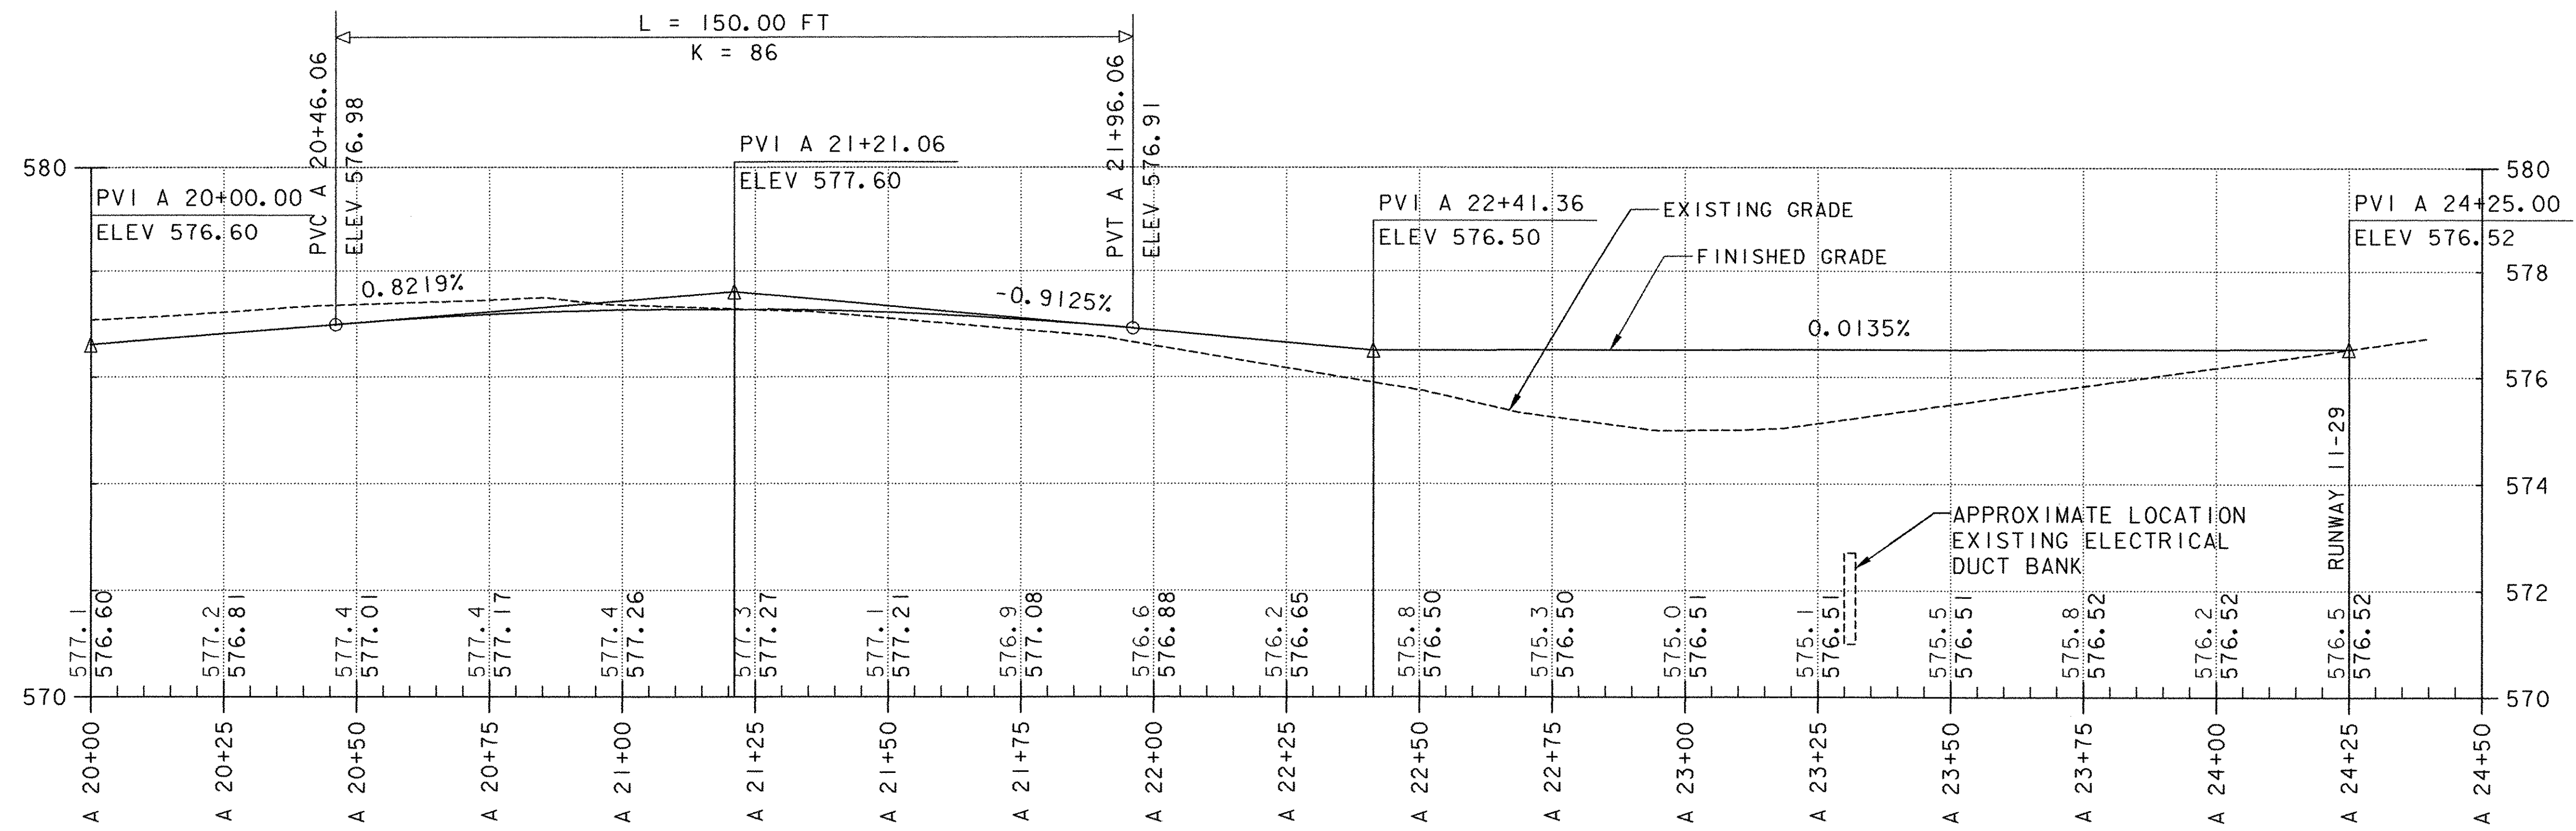

APRON CROSS-SECTION

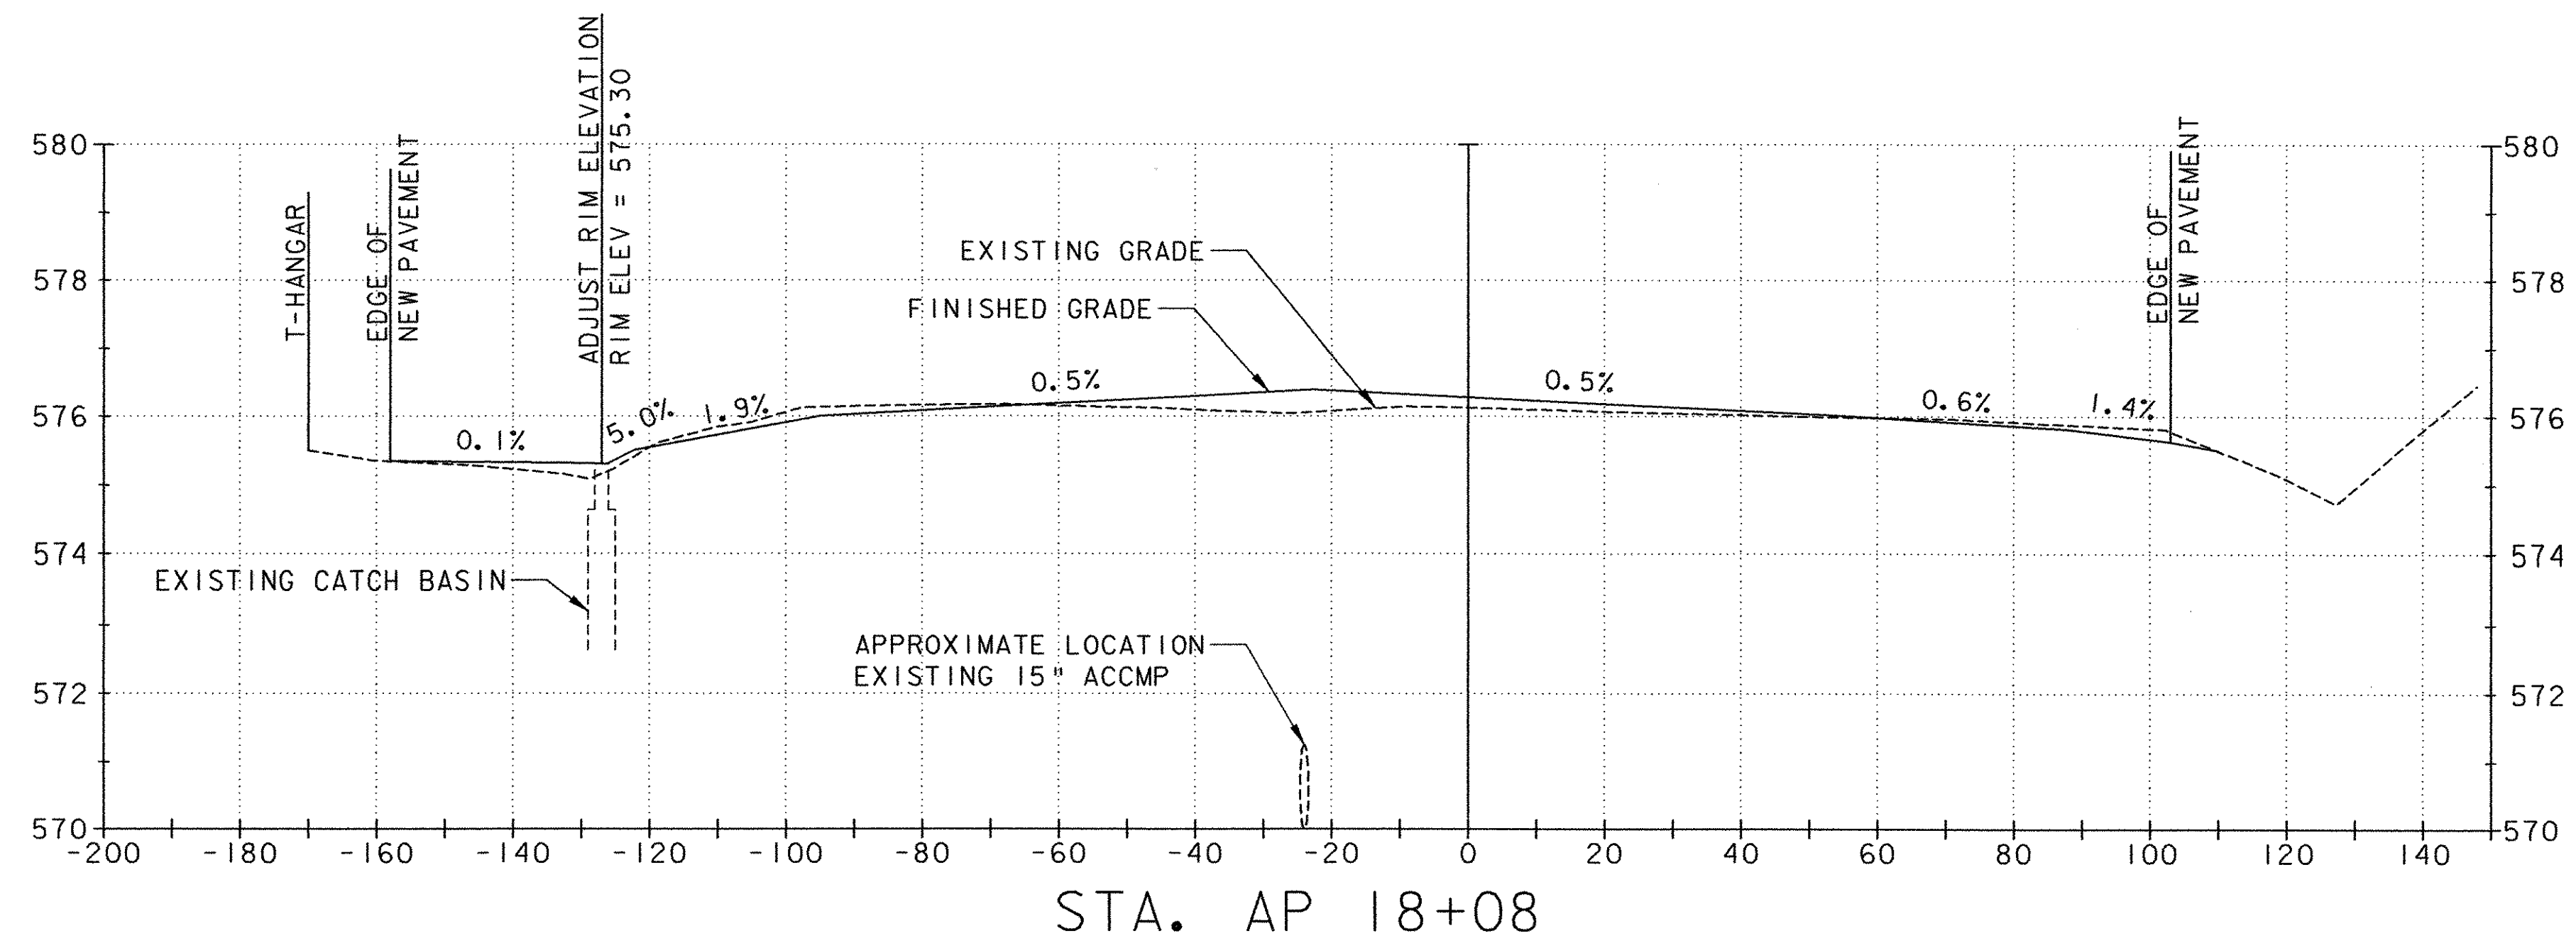

PROJECT NAME: SPRINGFIELD AIR	PROJECT NUMBER: 04-3161
FILE NAME: hartness_xsl.dgn	PLOT DATE: 05/21/2003
PROJECT LEADER: JBL	DRAWN BY: TPL
DESIGNED BY: MCS	CHECKED BY: MCS
CROSS SECTION & PROFILE	SHEET 17 OF 17

...:\VDFP11es\sections.dwt 05/21/2003 10:45:08 AM