


QUANTITY SHEET

SUMMARY OF ESTIMATED QUANTITIES			
ITEM NO.	UNIT	ITEMS	QUANTITIES GRAND TOTAL
201.10	LS	CLEARING AND GRUBBING (MOD.)	1
203.30	CY	EARTH BORROW	150
601.0920	LF	24" CPEP	40
604.11	EA	CONCRETE MANHOLE WITH CAST IRON COVER (MOD.-ELECTRIC MANHOLES)	2
608.25	HOURL	ALL PURPOSE EXCAVATOR RENTAL, TYPE I	40
609.10	MGAL	DUST CONTROL WITH WATER	10
613.10	CY	STONE FILL, TYPE I	5
620.13	LF	CHAIN-LINK FENCE, 2.4 M (8 FEET)	5900
620.13	LF	CHAIN-LINK FENCE, 2.4 M (8 FEET) (VINYL COATED)	6300
620.17	LF	GATE FOR CHAIN-LINK FENCE, 8 FEET (MOD.-GATE 1)	16
620.17	LF	GATE FOR CHAIN-LINK FENCE, 8 FEET (MOD.-GATE 2)	16
620.17	LF	GATE FOR CHAIN-LINK FENCE, 8 FEET (MOD.-GATE 3)	26
620.17	LF	GATE FOR CHAIN-LINK FENCE, 8 FEET (MOD.-GATE 4)	17
620.17	LF	GATE FOR CHAIN-LINK FENCE, 8 FEET (MOD.-GATE 5)	17
620.17	LF	GATE FOR CHAIN-LINK FENCE, 8 FEET (MOD.-GATE 6)	20
620.17	LF	GATE FOR CHAIN-LINK FENCE, 8 FEET (MOD.-GATE 7)	4
620.17	LF	GATE FOR CHAIN-LINK FENCE, 8 FEET (MOD.-GATE 8)	12
620.17	LF	GATE FOR CHAIN-LINK FENCE, 8 FEET (MOD.-GATE 9)	4
620.17	LF	GATE FOR CHAIN-LINK FENCE, 8 FEET (MOD.-GATE 10)	16
620.17	LF	GATE FOR CHAIN-LINK FENCE, 8 FEET (MOD.-GATE 11)	4
620.22	EA	BRACING ASSEMBLY FOR CHAIN-LINK FENCE, 8 FEET	125
620.55	LF	REMOVAL OF EXISTING FENCE	2200
620.70	LF	SNOW FENCE (MOD.-PDF)	2000
631.16	LS	TESTING EQUIPMENT - CONCRETE	1
631.25	LU	FIELD OFFICE - TELEPHONE (NABI)	1
635.11	LS	MOBILIZATION/DEMOBILIZATION	1
646.215	LF	6" YELLOW LINE (P-620)	3000
646.85	SF	REMOVAL OF EXISTING PAVEMENT MARKINGS	850
649.51	SY	GEOTEXTILE FOR SILT FENCE	200
651.15	LB	SEED	200
651.18	LB	FERTILIZER	250
651.20	TON	AGRICULTURAL LIMESTONE	1
651.25	TON	HAY MULCH	1
651.35	CY	TOPSOIL	40
654.10	SY	EROSION MATTING	100
678.21	LF	ELECTRICAL CONDUIT (2")	2400
854.07	EA	AIRCRAFT TIE DOWN ANCHOR, TYPE A	4
864.04	LF	L-108, CABLE TRENCH	2300
864.05	LF	L-108, 1/C #8 L-824 TYPE C, 5KV	2700
864.06	LF	L-108, #8 COUNTERPOISE WIRE (MOD.)	2400
864.11	EA	L-125, MEDIUM INTENSITY TAXIWAY LIGHTS, BASE MOUNTED	4
864.14	EA	L-125, TAXIWAY GUIDANCE SIGN	2
864.14	EA	L-125, TAXIWAY GUIDANCE SIGN (MOD.-RELOCATED)	5

PROJECT "A":

- (1) INSTALL AIRFIELD FENCE (APPROXIMATELY 12,200 LF)
- (2) INSTALL MITLS AND SIGNS ON TAXIWAYS A AND B-WEST
- (3) RELOCATE SIGNS ON TAXIWAYS B-WEST AND F

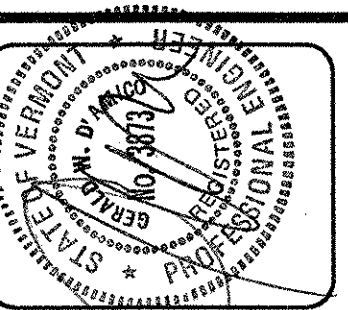

AS REQUESTED BY VTTRANS	DATE	REV.	DESCRIPTION	Job No.	38397036	File No.	38397036462			

RUTLAND STATE AIRPORT
CLARENDON, VERMONT

QUANTITY SHEET

URS
28 CORPORATE DRIVE
CLIFTON PARK, NEW YORK

Designed by: G.W.D.
Drawn by: M.C.M.
Checked by: M.L.C.
Approved by: G.W.D.

Scales: N/A
Date: MARCH, 2005
Sheet 2 of 13
Sheet No. **2**

P:\38397036\Civil\Sheet\Project A Sheets\38397036462.dgn 4/11/2005