




CEX-654
 SUBBASE 431
 BASECOURSE 105
 1483 666 AND
 1485 331 BACK

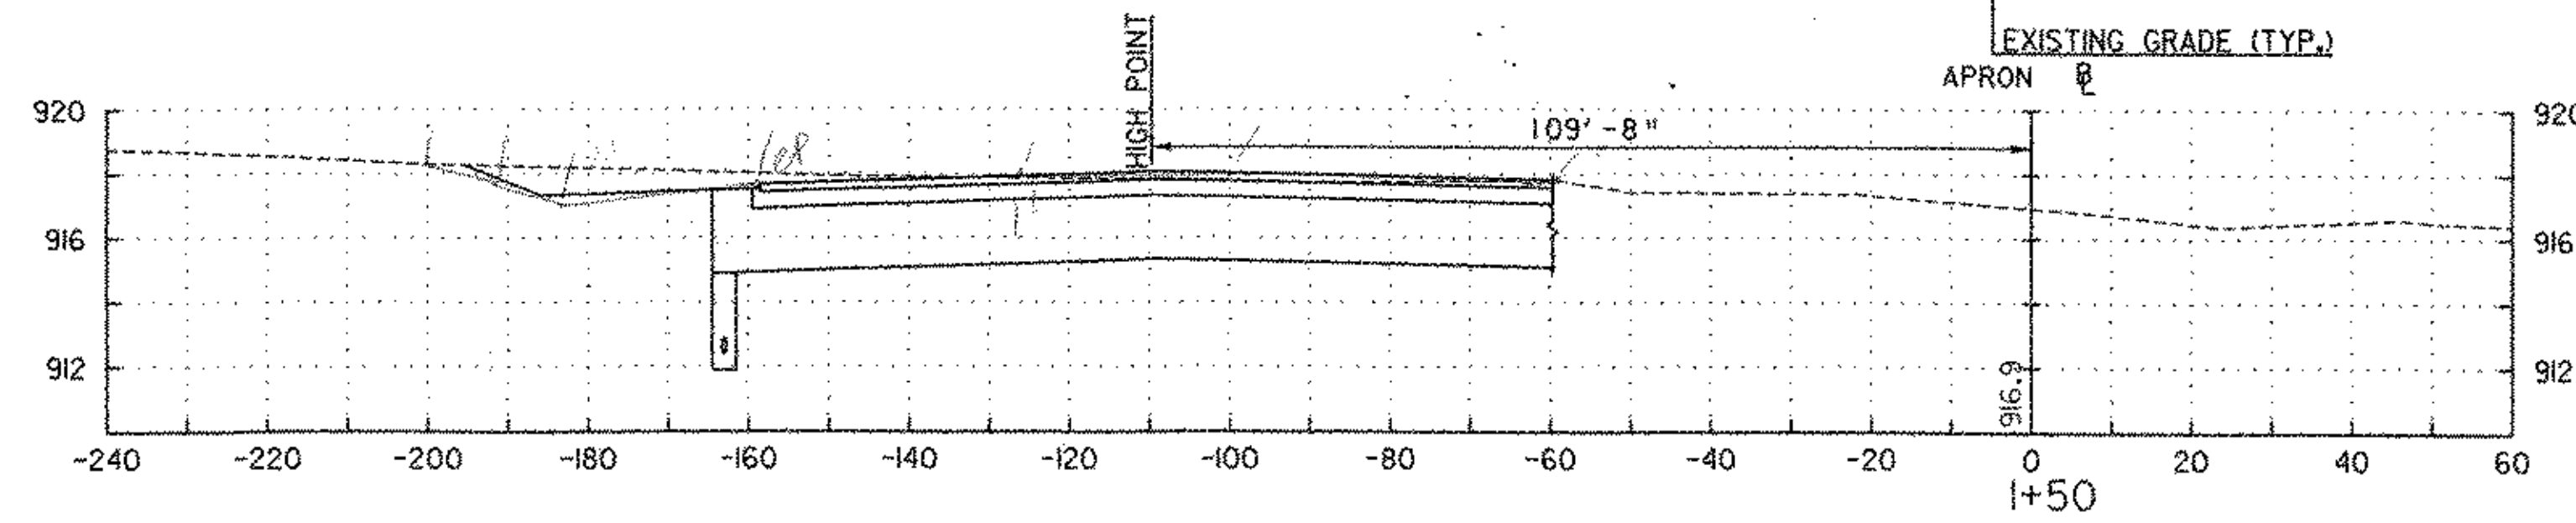


331
 CEX-331
 SUBBASE 260
 BASECOURSE 50

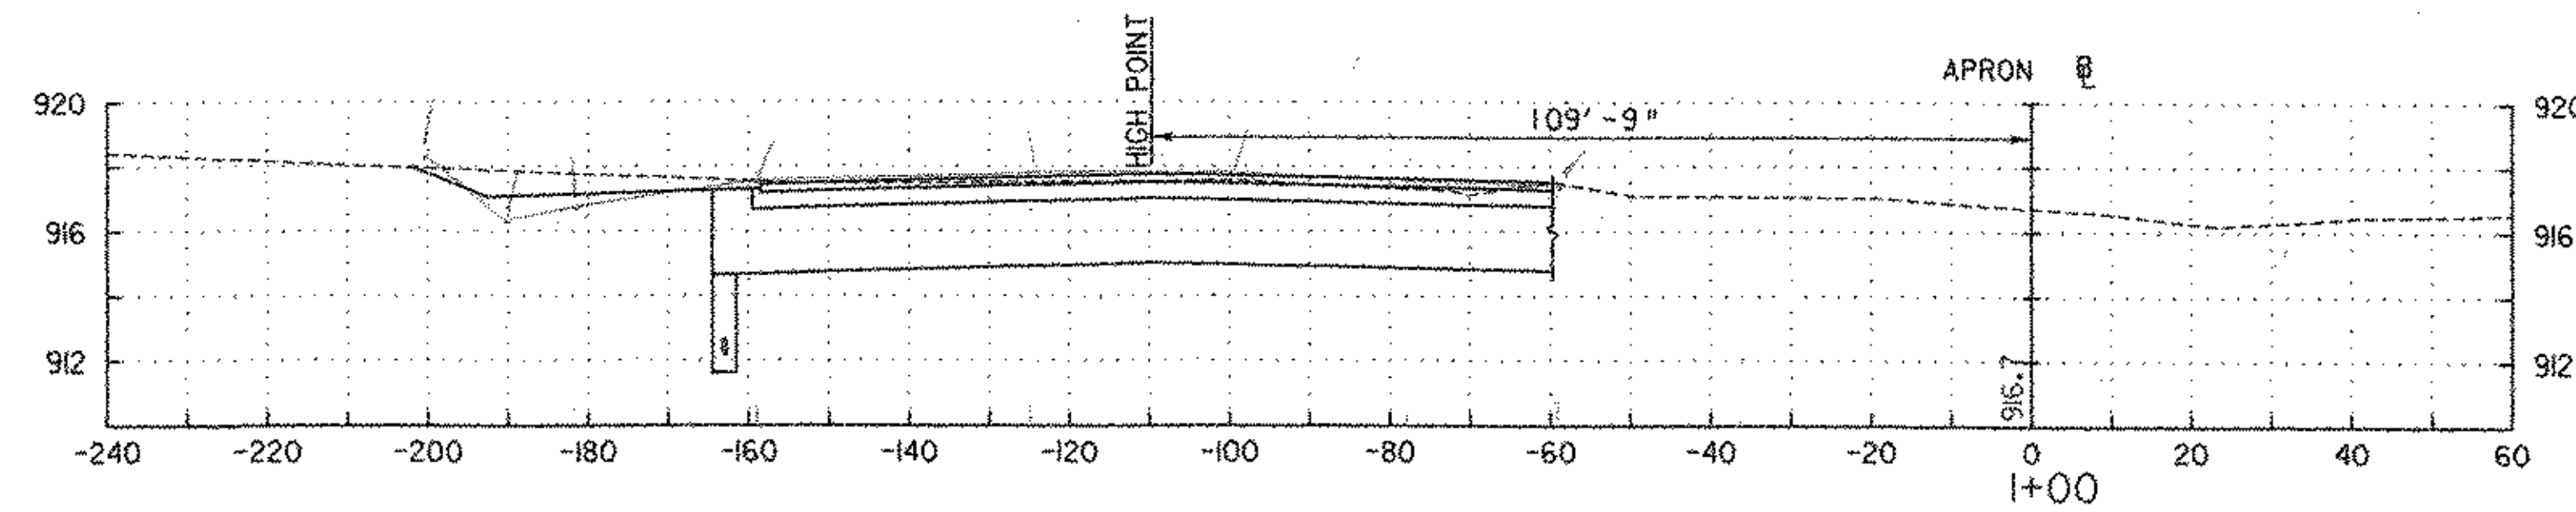


CEX-319
 SUBBASE 260
 BASECOURSE 50

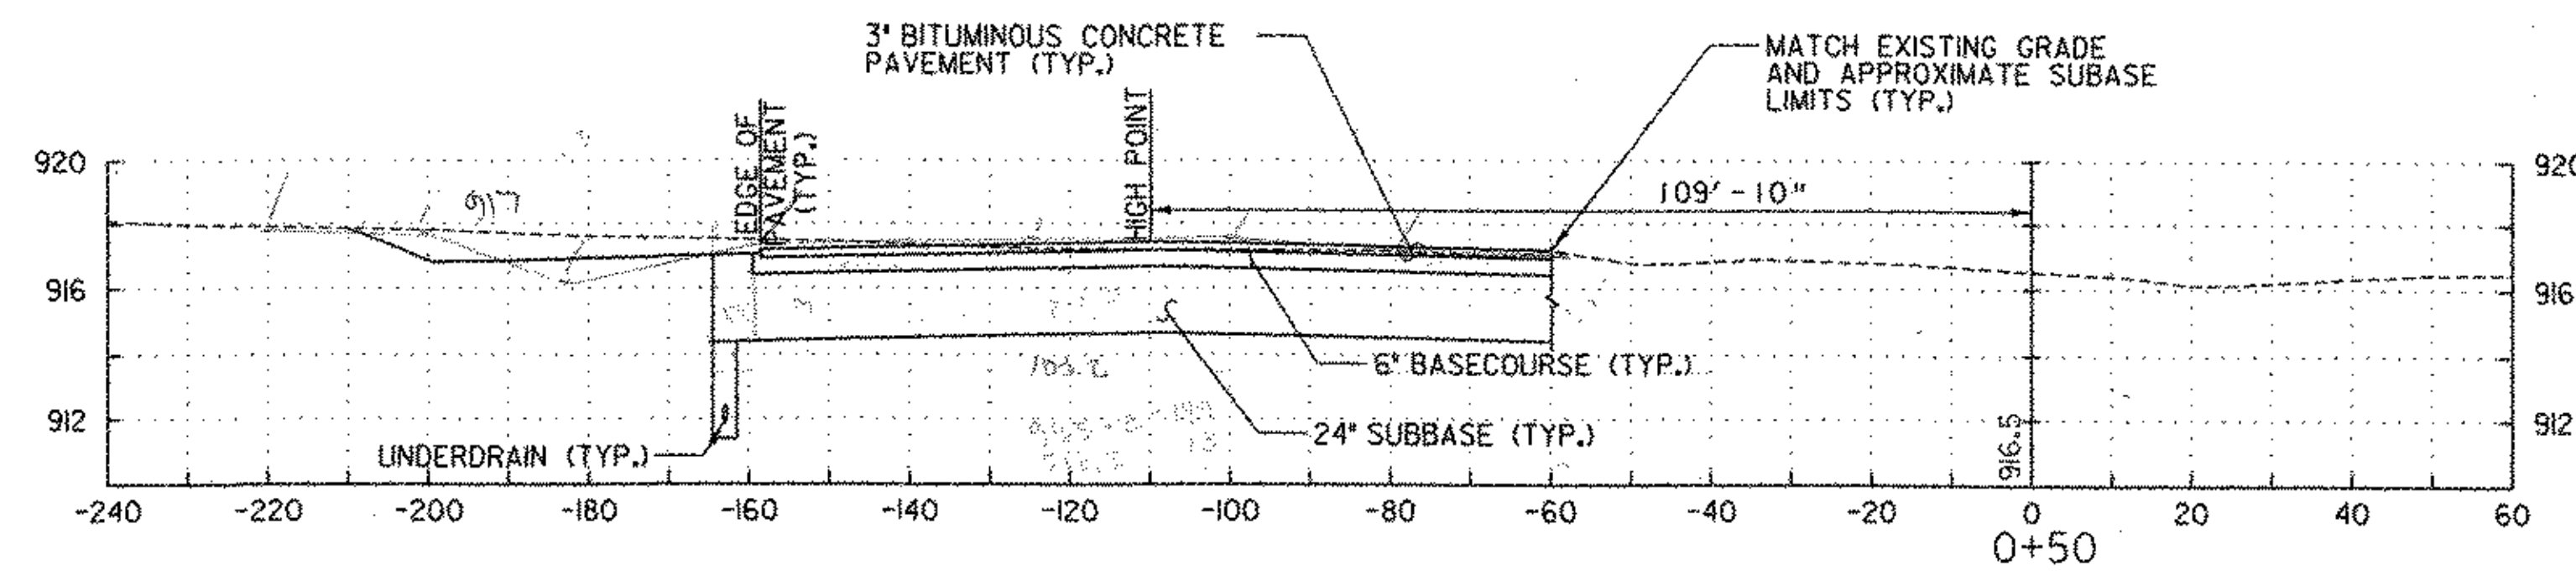

CEX-319
 SUBBASE 260
 BASECOURSE 50

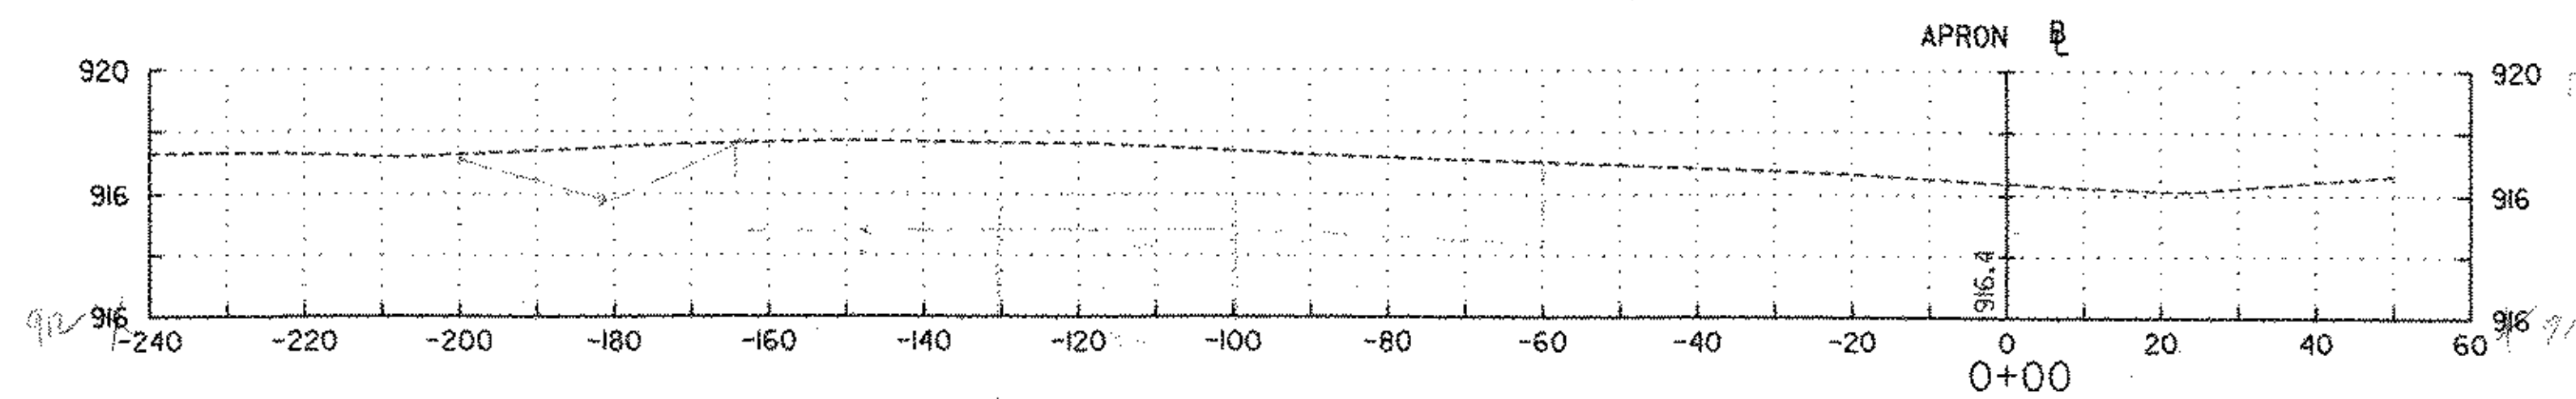

319
 SUBBASE 260
 BASECOURSE 50

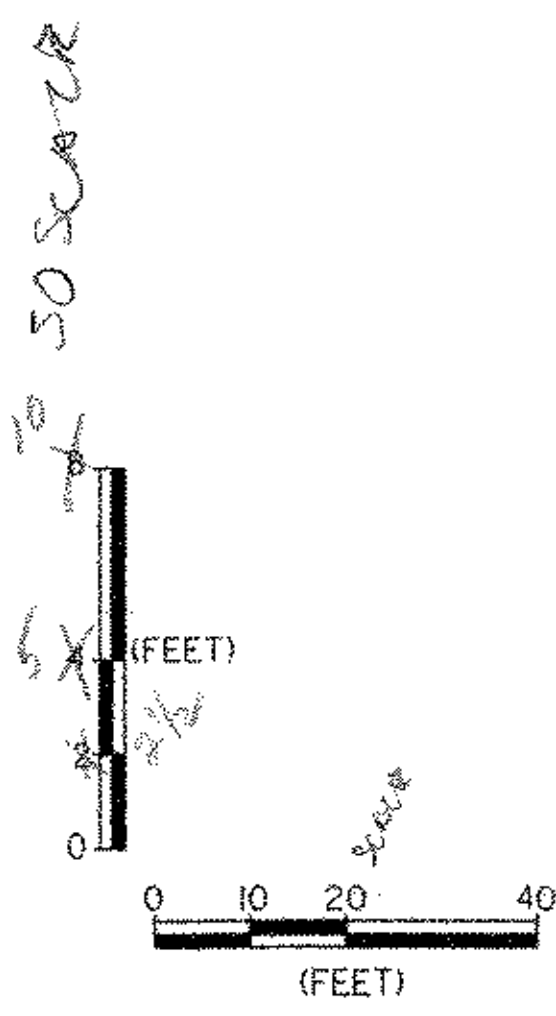

DATUM	
VERTICAL	NAVD 88
HORIZONTAL	NAD 83

PROJECT NAME: COVENTRY	
PROJECT NUMBER: AIR 04-3173	
FILE NAME:	PLOT DATE: 04/06/2005
PROJECT LEADER: JAA	DRAWN BY: PGJ
DESIGNED BY: JDR	CHECKED BY: JWT
APRON CROSS SECTIONS	SHEET 18 OF 22