

TAXIWAY "G" TYPICAL
 STA. 606+05.35 TO 607+05.75
 N.T.S.

GENERAL NOTES

1. SUBGRADE UNDER AREAS TO BE PAVED SHALL BE COMPACTED TO 100% DENSITY, AASHTO T-99, ASTM D-698
2. BITUMINOUS TACK COAT (EMULSIFIED ASPHALT, RS-1) SHALL BE APPLIED BETWEEN LIFTS OF BITUMINOUS CONCRETE PAVEMENT AT A RATE OF 0.01 TO 0.03 GAL/SY WHEN DIRECTED BY THE ENGINEER (NOT A SEPARATE PAY ITEM).
3. SEED, ITEM 651.15, SHALL BE APPLIED AS DIRECTED BY ENGINEER. THE SEED MIXTURE SHALL CONFORM TO:

% WT	LBS / A		PUR. %	GERM
20	14	TALL FESCUE (K-31)	95	85
10	7	PERENNIAL RYE GRASS	95	85
1	1	MEDIUM RED CLOVER	95	85
2	2	EMPIRE BIRDS FOOT TREFOIL	98	85
22	15	CLIMAX TIMOTHY	95	85
25	17	CREEPING RED FESCUE	98	85
10	7	ANNUAL RYE	95	85
10	7	ORCHARD GRASS	95	85
100	70			

THE SEED MIXTURE SHALL NOT HAVE A WEED CONTENT EXCEEDING 0.40% BY WEIGHT AND SHALL BE FREE OF ALL NOXIOUS WEED SEED.

4. FERTILIZER, (ITEM 651.18, FORMULA 10-20-10) SHALL BE USED WITH SEED. ITEM 651.15, SHALL BE APPLIED AT THE RATE OF 500 LBS / ACRE.

AGRICULTURAL LIMESTONE, ITEM 651.20, SHALL BE APPLIED AT THE RATE OF 2 TONS/ACRE OR AS DIRECTED BY ENGINEER.

MAY MULCH, ITEM 651.25, SHALL BE PLACED ON EARTH SLOPES AT THE RATE OF 2 TONS/ACRE.


TOPSOIL, ITEM 651.35, SHALL BE USED WITH SEED, ITEM 651.15, AS DIRECTED BY THE ENGINEER.

5. UNDERCUT AND BACKFILL WITH SUBBASE OF DENSE GRADED CRUSHED STONE, ITEM 301.35 WHEN DIRECTED BY THE ENGINEER.

6. ALLOWABLE THICKNESS TOLERANCES:
 SUBGRADE ± 1/2"
 CONTROLLED MATERIAL ± 1/2"
 PAVEMENT ± 3/16"
 BASE COURSE ± 1/2"

7. PAY LIMITS FOR SEED, LIME, FERTILIZER & MULCH ARE EQUAL TO THE APPROVED CONSTRUCTION LIMITS.

8. GRANULAR BORROW (P-154), ITEM 203.32, SHALL LIMIT % PASSING .02MM TO 3 % (NON FROST SUSCEPTIBLE). THE COMPACTION REQUIREMENT IS 100% DENSITY, ASTM D 698.

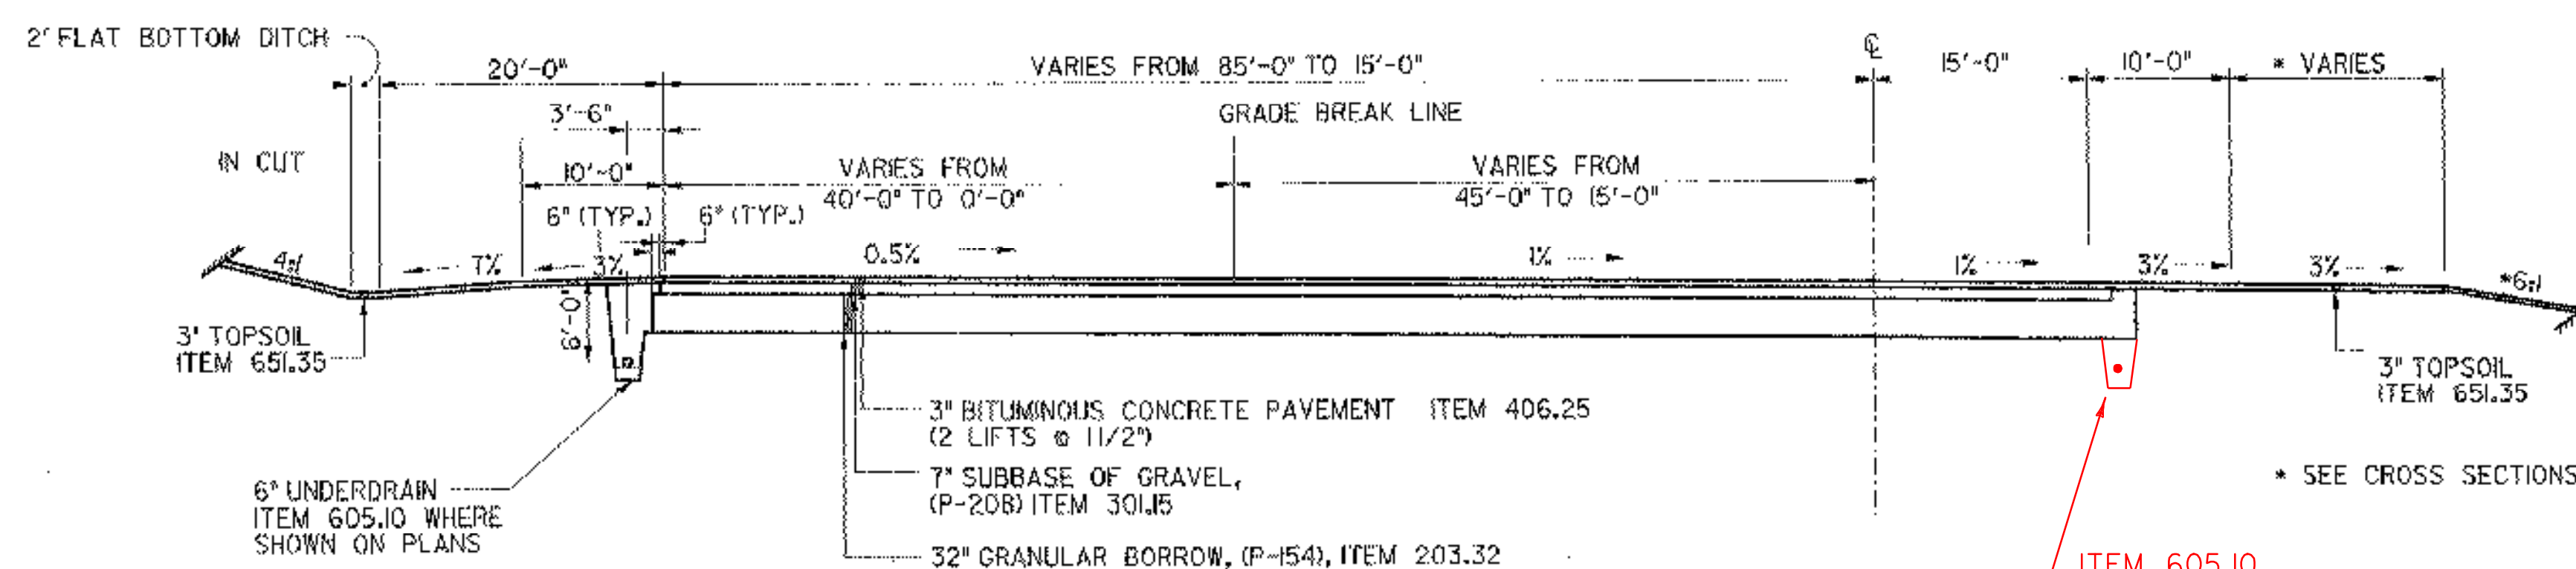

APRON EXPANSION AREA
 STA. 603+05.34 TO 606+05.35
 N.T.S.

ITEM 605.10
 6" UNDERDRAIN
 2.5' X 2.5' TRENCH
 STA 606+07 - C.B. @ STA 603+15.91, 35.81' RT
 (INCLUDE 2 FLUSHING BASINS @ STA 606+07
 EDGE OF PAVEMENT). CHANGE ORDER #1

DATUM	
VERTICAL	NAVD 88
HORIZONTAL	NAD 83



AIP 3-50-0015

PROJECT NAME:	CLARENDON
PROJECT NUMBER:	AIR 04-3172-C2
FILE NAME:	38397036sheet6.dgn
PROJECT LEADER:	G. D'AMICO
DESIGNED BY:	R. DEWEY
TYPICAL SECTIONS	
PLOT DATE:	2/16/2006
DRAWN BY:	R. DEWEY
CHECKED BY:	G. D'AMICO
SHEET 6	OF 27