

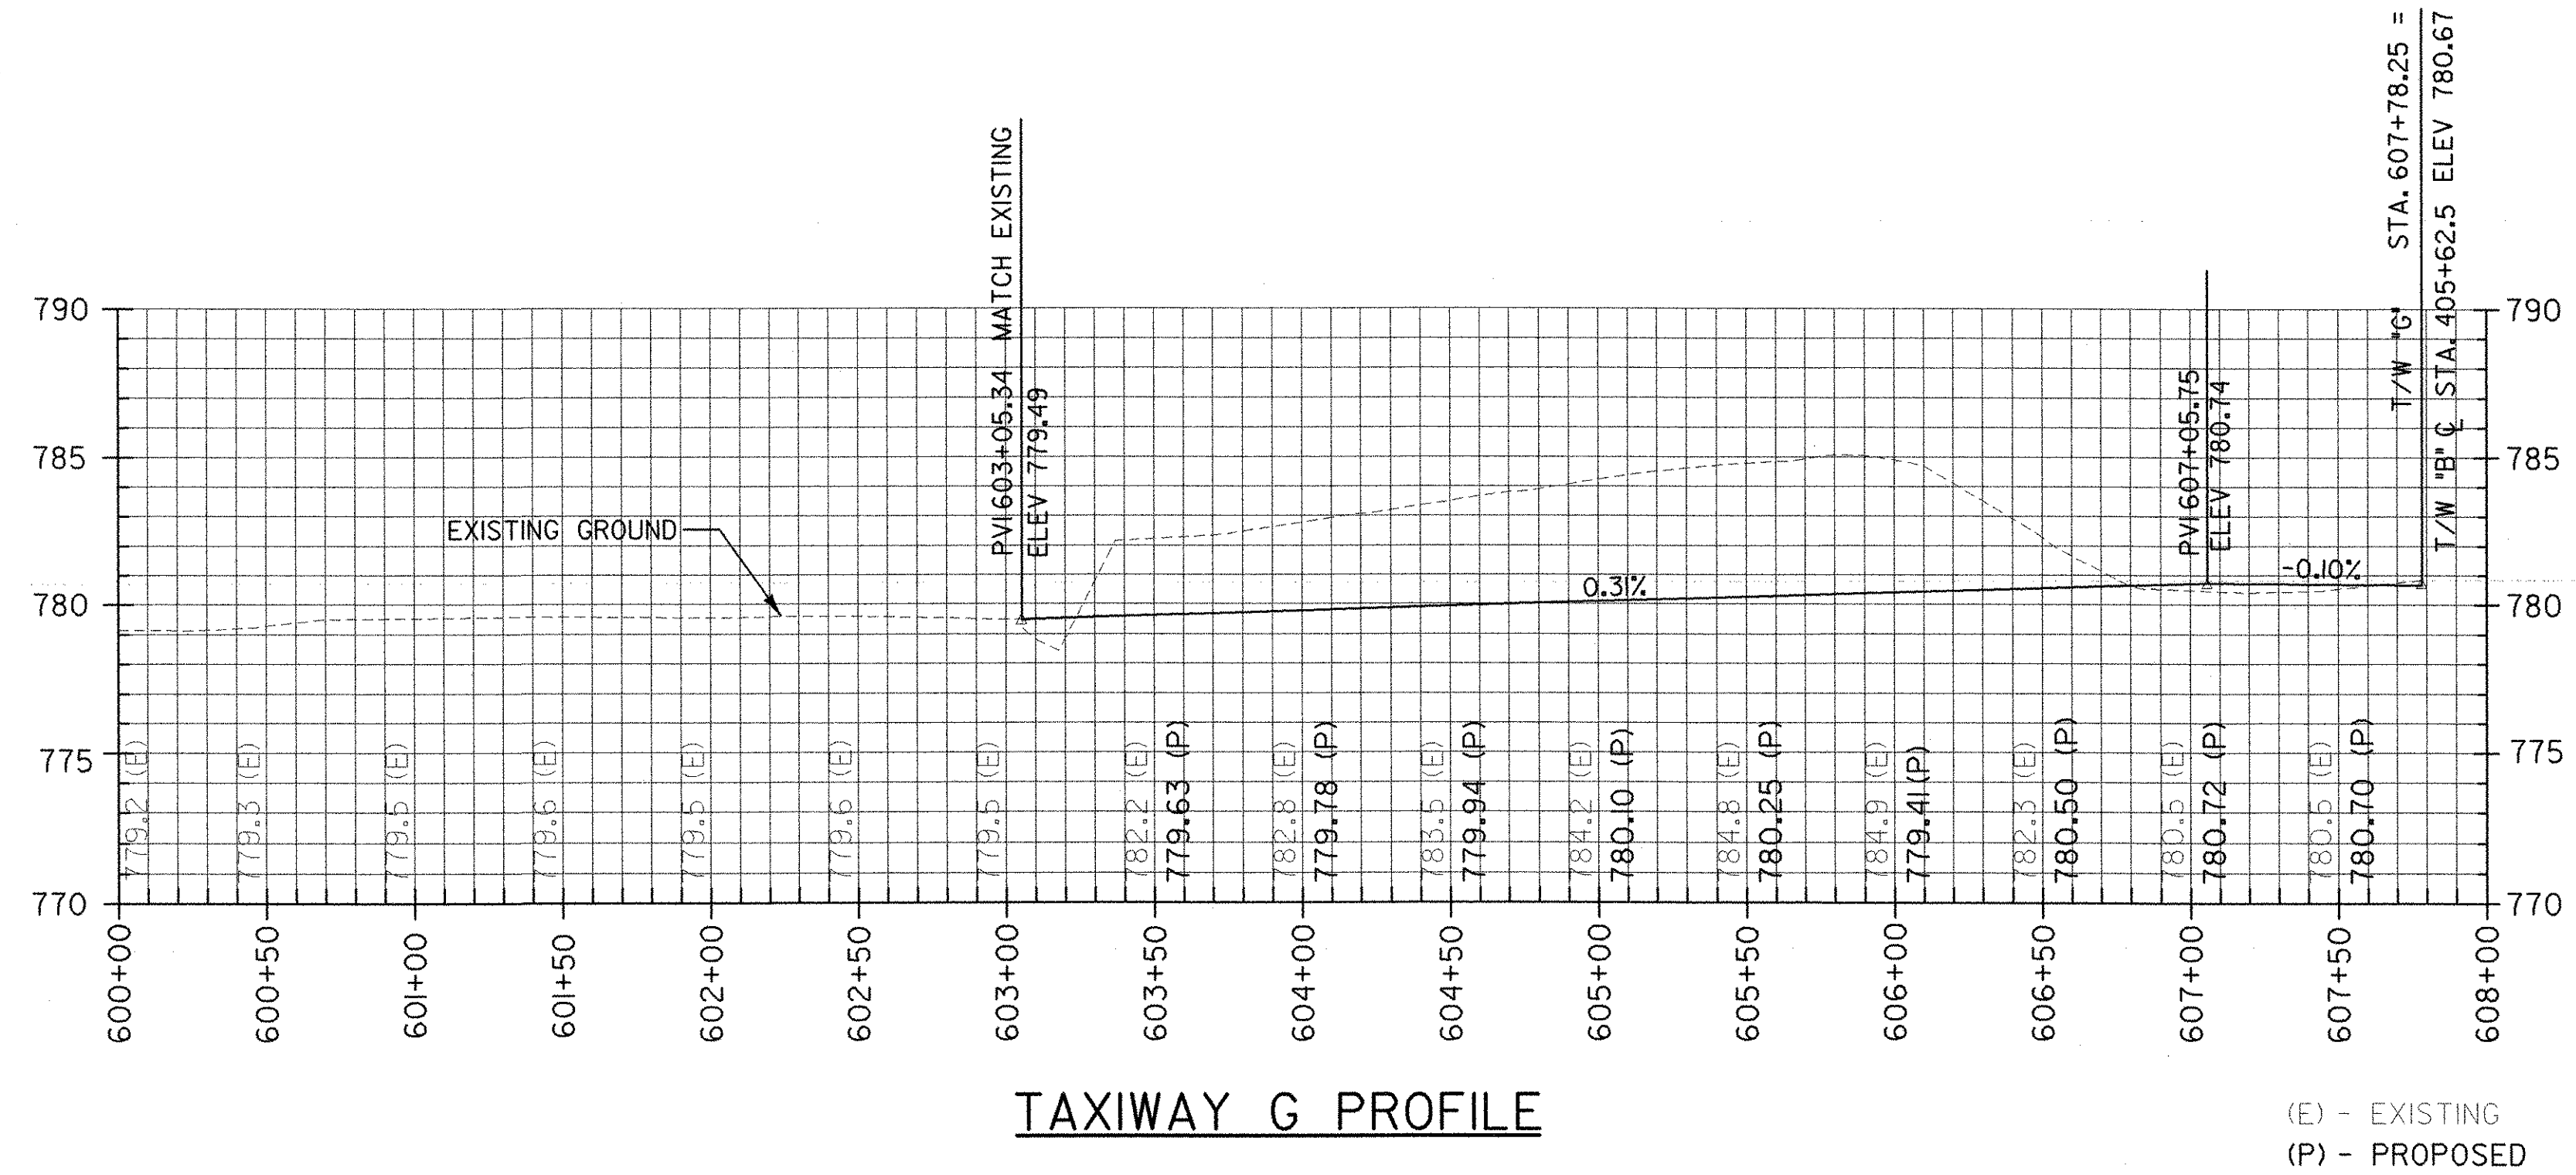


**NOTES**

I. SEE TAXIWAY INTERSECTION GRADING PLAN (SHEET 10) FOR MORE DETAILS.

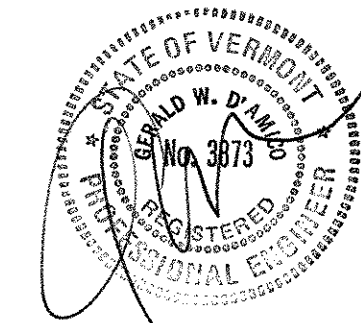

(E) - EXISTING  
(P) - PROPOSED

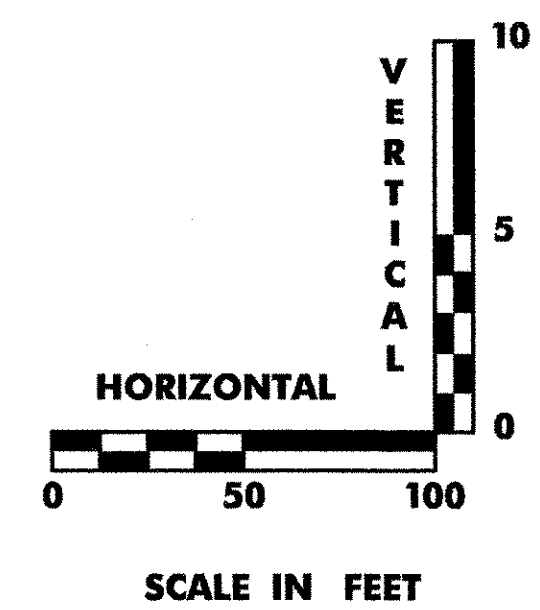

**AIP 3-50-0015**

<b>DATUM</b>	
VERTICAL	NAVD 88
HORIZONTAL	NAD 83

PROJECT NAME:	<b>CLARENDON</b>	PLOT DATE:	2/16/2006
PROJECT NUMBER:	<b>AIR 04-3172-C2</b>	DRAWN BY:	R. DEWEY
FILE NAME:	38397036sheet7.dgn	CHECKED BY:	G. D'AMICO
PROJECT LEADER:	G. D'AMICO	TAXIWAY G PROFILE	SHEET 7 OF 27
DESIGNED BY:	R. DEWEY		