



LEGEND

	EXISTING CONTOURS (MAJOR)
	PROPOSED CONTOURS (MAJOR)
	EXISTING CONTOURS (MINOR)
	PROPOSED CONTOURS (MINOR)
	INDICATES AREA OF MILLING AND RESURFACING
	INDICATES NEW ASPHALT PAVEMENT
	780.26 PROPOSED SPOT ELEVATION
	779.69 EXISTING ELEVATIONS

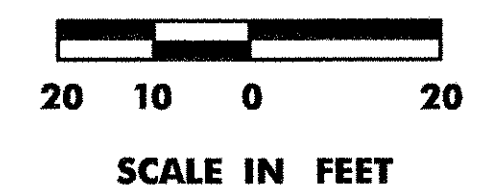

DATUM

VERTICAL	NAVD 88
HORIZONTAL	NAD 83

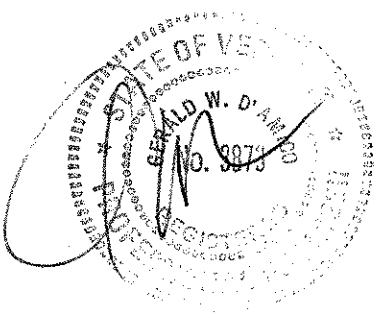

AIP 3-50-0015

PROJECT NAME:	CLARENDON	PLOT DATE:	2/16/2006
PROJECT NUMBER:	AIR 04-3172-C2	DRAWN BY:	R. DEWEY
FILE NAME:	38397036sheet10.dgn	CHECKED BY:	G. D'AMICO
PROJECT LEADER:	G. D'AMICO	SHEET 10	OF 27
DESIGNED BY:	R. DEWEY	TAXIWAY INTERSECTION GRADING PLAN	

P:\38397036\Civil\Sheet\February 2006 Submission\38397036sheet10.dgn