


SIGN SCHEDULE						
SIGN	LEGEND	COLOR	TYPE	LOCATION	REMARKS	PAY ITEM
TG18R		(W/R) (BLANK)	MANDATORY	45' RT. 311+25	TO REMAIN	—
TG19R		(Y/B) (BLANK)	LOCATION	48' RT. 311+25	TO REMAIN	—
TG39		(Y/B)	LOCATION	35' LT. 607+00	NEW	864.14
TG40		(B/Y) (BLANK)	DIRECTION	40' LT. 607+00	NEW	864.14
TG44		(B/Y) (BLANK)	DIRECTION	37.5' RT. 404+89	NEW	864.14
TG42		(BLANK) (R/Y)	DIRECTION	37.5' RT. 406+32.5	NEW	864.14
TG20B		(BLANK) (Y/B)	LOCATION	45' RT. 400+72.5	TO REMAIN	—
TG20C		(BLANK) (B/Y)	DIRECTION	40' LT. 400+72.5	TO REMAIN	—

NOTES:
 1. ALL SIGNS TO BE L-858, SIZE 1 (18" PANEL WITH 12" LEGEND), STYLE 2, CLASS 2.
 2. COLORS
 Y/B = YELLOW LEGEND ON BLACK BACKGROUND
 B/Y = BLACK LEGEND ON YELLOW BACKGROUND

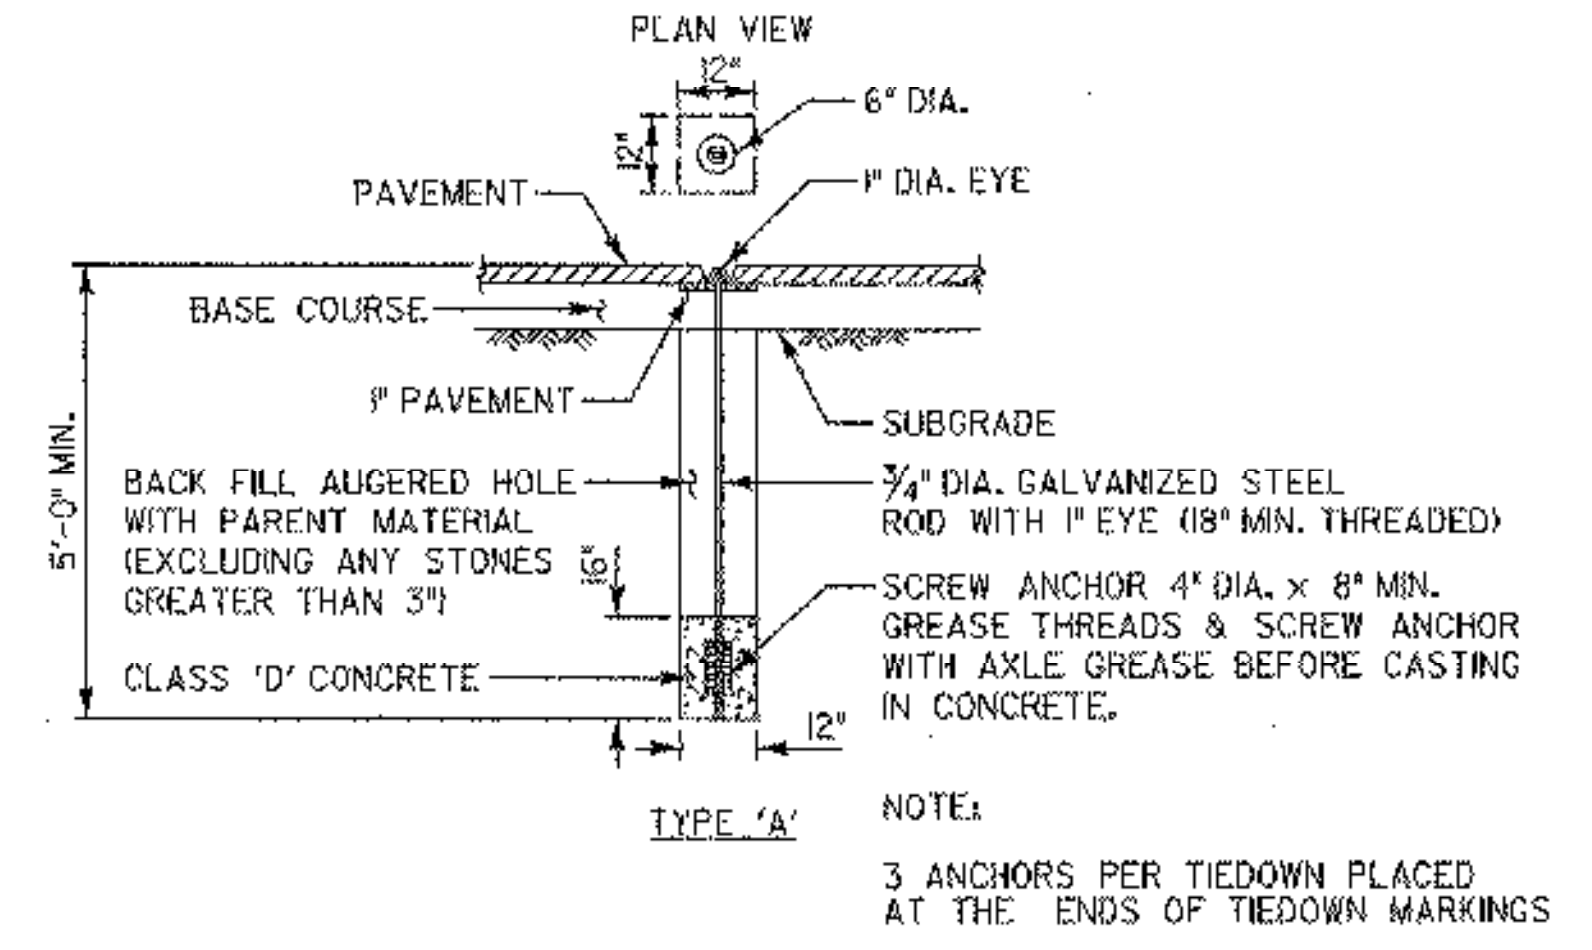

A AIRCRAFT TIE DOWN ANCHOR, TYPE A
 ITEM 854.07
 N.T.S.

LEGEND	
	EXISTING TAXIWAY LIGHTS (MTLS)
	EXISTING TAXIWAY GUIDANCE SIGN
	NEW TAXIWAY GUIDANCE SIGN
	NEW 5/8" dia. x 8' COPPER CLAD GROUND ROD
	EXISTING UNDERGROUND ELECTRICAL
	PROPOSED UNDERGROUND ELECTRICAL

- NOTES
- TAXIWAY MARKINGS SHALL CONFORM TO AC 150/5340-1H AND VTRANS STANDARD DRAWING AP-11.
 - ALL TAXIWAY MARKINGS SHALL BE YELLOW, REFLECTIVE USING GLASS BEADS.
 - REMOVE PAVEMENT MARKINGS THAT CONFLICT WITH NEW PAVEMENT MARKINGS. PAYMENT TO BE MADE UNDER ITEM 646.85



DATUM
 VERTICAL NAVD 88
 HORIZONTAL NAD 83



AIP 3-50-0015

PROJECT NAME:	CLARENDON
PROJECT NUMBER:	AIR 04-3172-C2
FILE NAME:	36397036sheet1.dgn
PROJECT LEADER:	G. D'AMICO
DESIGNED BY:	R. DEWEY
APRON & TAXIWAY MARKING & SIGN PLAN	
PLOT DATE:	2/16/2006
DRAWN BY:	R. DEWEY
CHECKED BY:	G. D'AMICO
SHEET II	OF 27