


CATCH BASIN COVER LOWERED ~ 1'-0" AS ONE RISER REMOVED FROM BASIN

DATUM
 VERTICAL NAVD 88
 HORIZONTAL NAD 83

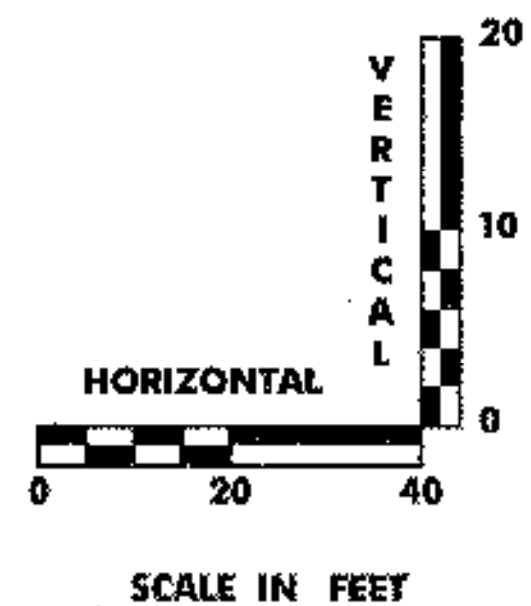

AIP 3-50-0015

PROJECT NAME: **CLARENDON**
 PROJECT NUMBER: **AIR 04-3172-C2**
 FILE NAME: 38397036sheet14.dgn
 PROJECT LEADER: G. D'AMICO
 DESIGNED BY: R. DEWEY
 TAXIWAY & CROSS SECTIONS
 PLOT DATE: 2/16/2006
 DRAWN BY: R. DEWEY
 CHECKED BY: G. D'AMICO
 SHEET 14 OF 27