



LEGEND	
	EXISTING CONTOUR
	PROPOSED CONTOUR
	APPROX. GRADING LIMITS
	SILT FENCE
	EARTH BERM
	PROPERTY LINE
	WETLAND BOUNDRY

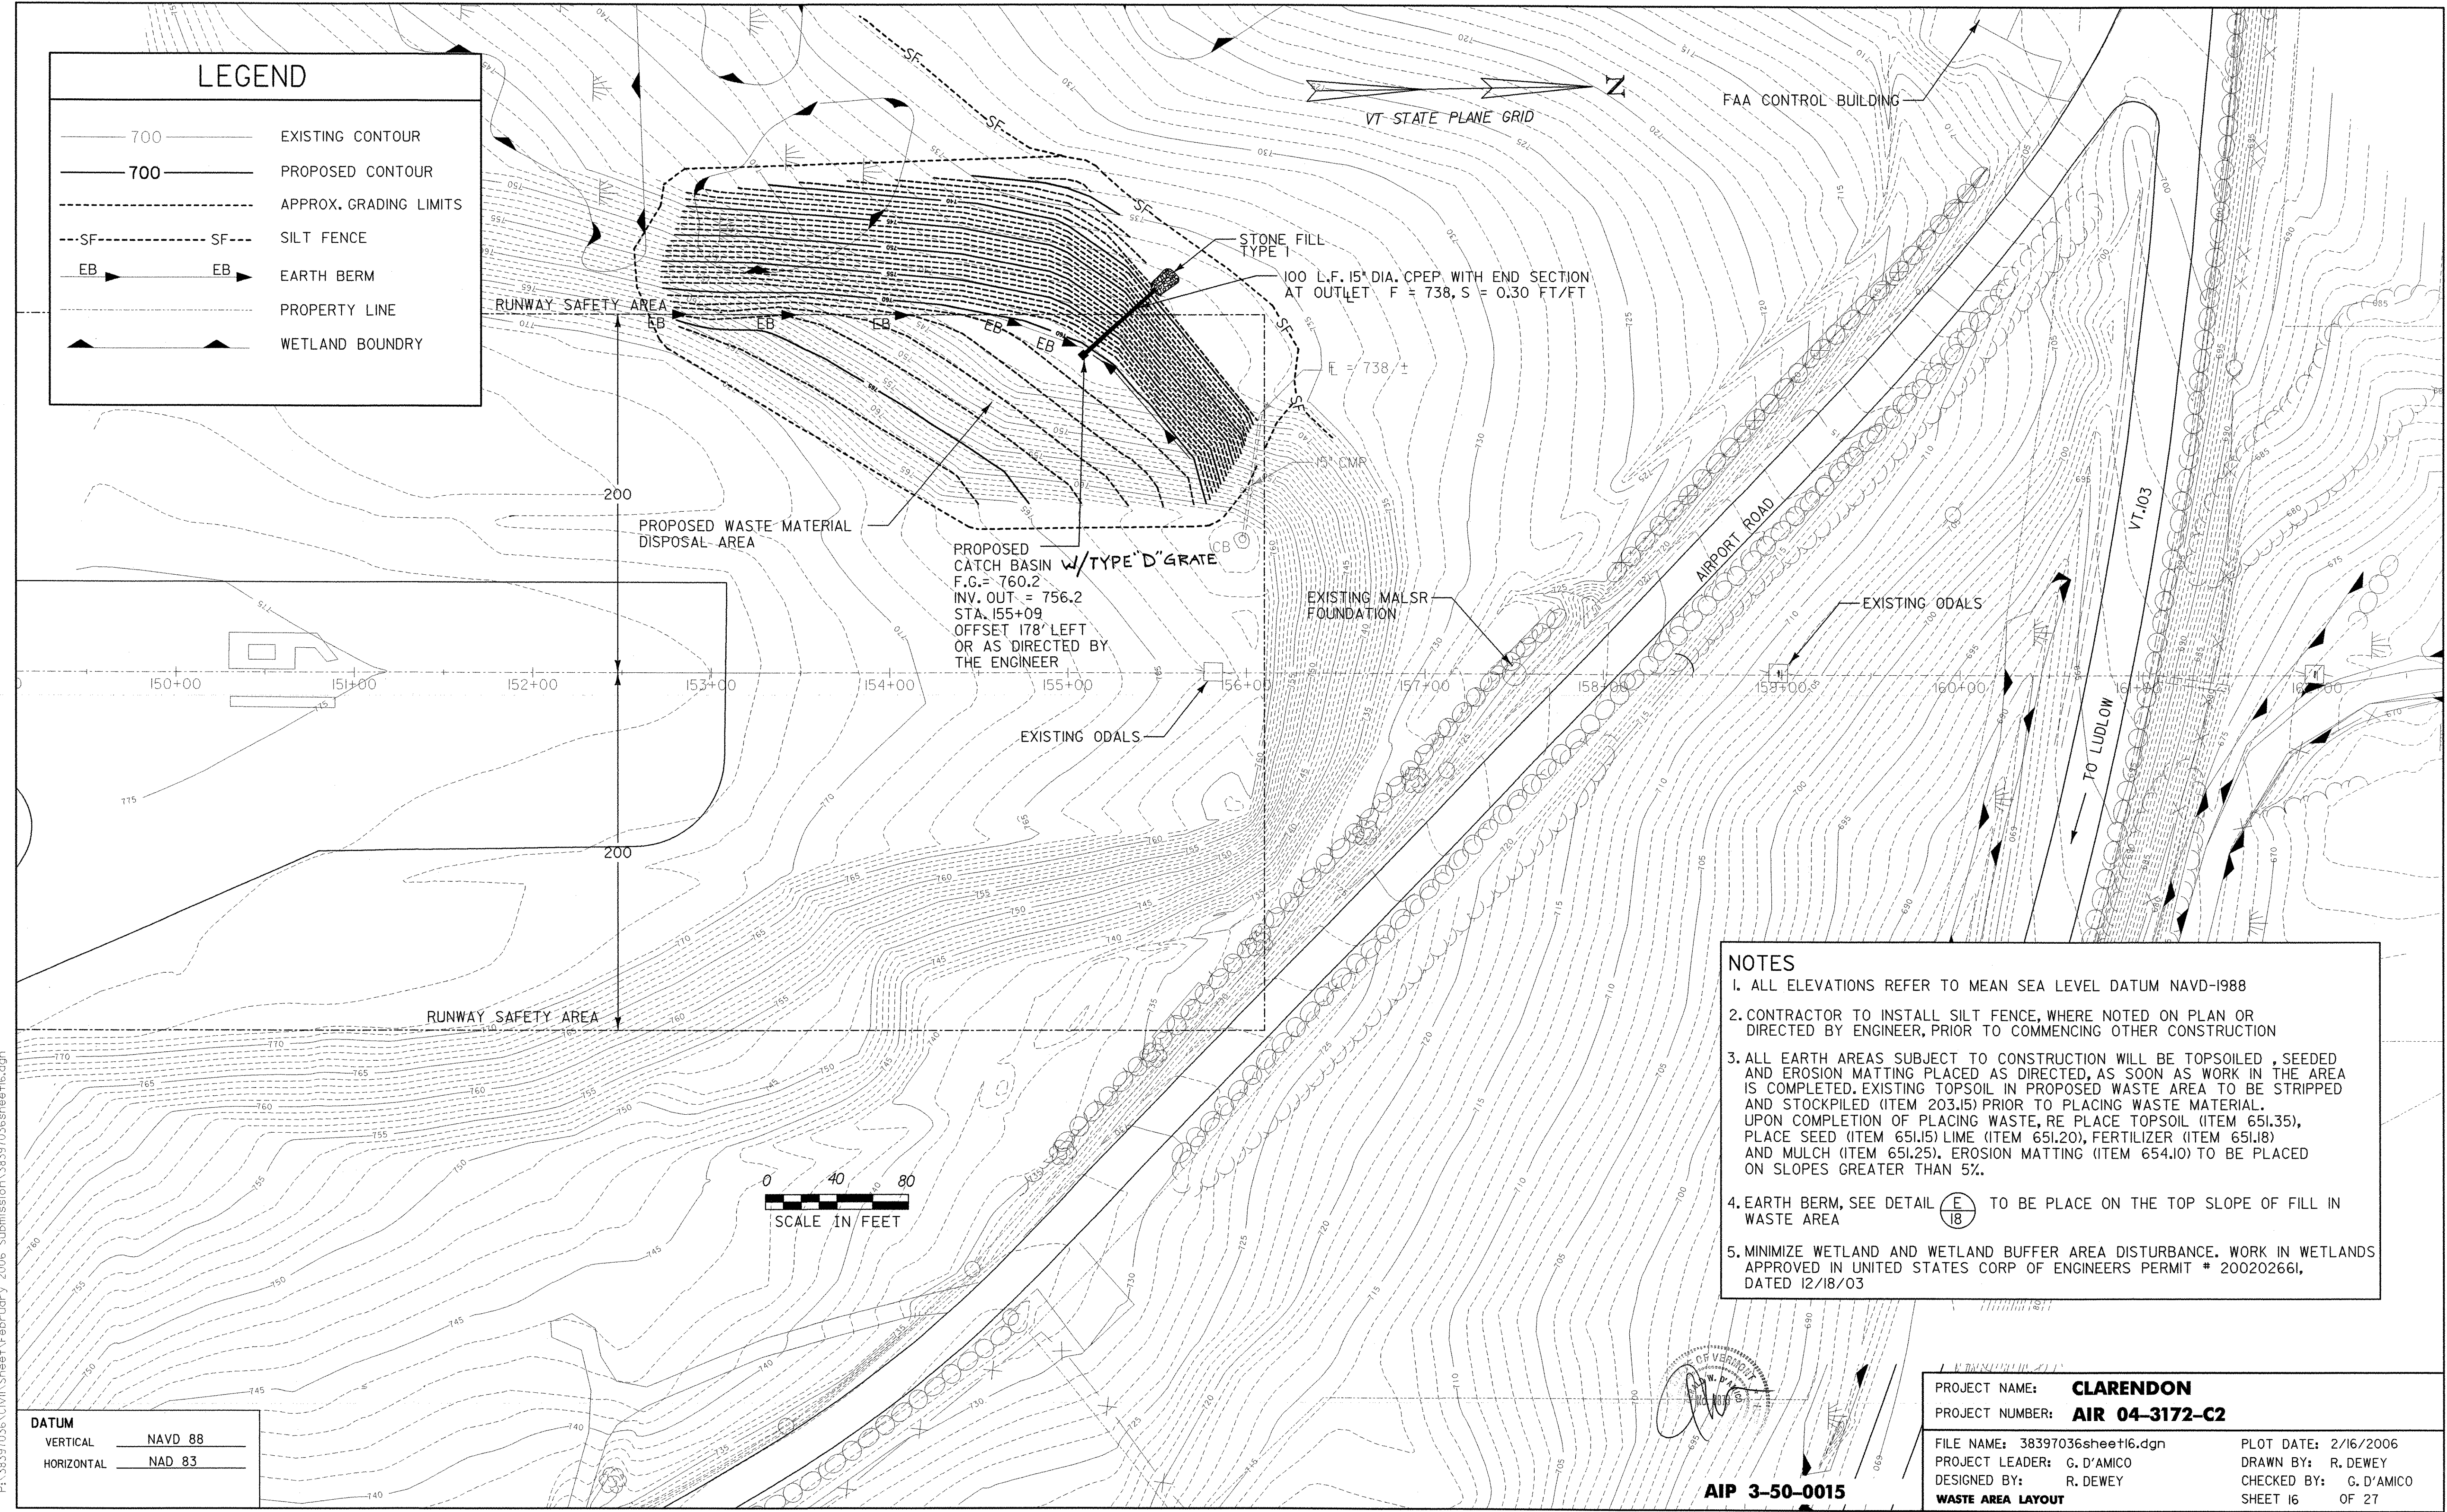

- NOTES**
1. ALL ELEVATIONS REFER TO MEAN SEA LEVEL DATUM NAVD-1988
 2. CONTRACTOR TO INSTALL SILT FENCE, WHERE NOTED ON PLAN OR DIRECTED BY ENGINEER, PRIOR TO COMMENCING OTHER CONSTRUCTION
 3. ALL EARTH AREAS SUBJECT TO CONSTRUCTION WILL BE TOPSOILED, SEEDED AND EROSION MATTING PLACED AS DIRECTED, AS SOON AS WORK IN THE AREA IS COMPLETED. EXISTING TOPSOIL IN PROPOSED WASTE AREA TO BE STRIPPED AND STOCKPILED (ITEM 203.15) PRIOR TO PLACING WASTE MATERIAL. UPON COMPLETION OF PLACING WASTE, RE PLACE TOPSOIL (ITEM 651.35), PLACE SEED (ITEM 651.15) LIME (ITEM 651.20), FERTILIZER (ITEM 651.18) AND MULCH (ITEM 651.25). EROSION MATTING (ITEM 654.10) TO BE PLACED ON SLOPES GREATER THAN 5%.
 4. EARTH BERM, SEE DETAIL TO BE PLACE ON THE TOP SLOPE OF FILL IN WASTE AREA
 5. MINIMIZE WETLAND AND WETLAND BUFFER AREA DISTURBANCE. WORK IN WETLANDS APPROVED IN UNITED STATES CORP OF ENGINEERS PERMIT # 200202661, DATED 12/18/03

DATUM
 VERTICAL NAVD 88
 HORIZONTAL NAD 83

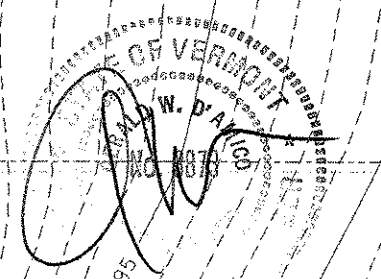

AIP 3-50-0015

PROJECT NAME: **CLARENDON**
 PROJECT NUMBER: **AIR 04-3172-C2**
 FILE NAME: 38397036sheet16.dgn
 PROJECT LEADER: G. D'AMICO
 DESIGNED BY: R. DEWEY
 WASTE AREA LAYOUT

PLOT DATE: 2/16/2006
 DRAWN BY: R. DEWEY
 CHECKED BY: G. D'AMICO
 SHEET 16 OF 27

PA: 38397036\Civil\Sheet16.dwg February 2006 Submission\38397036sheet16.dwg