
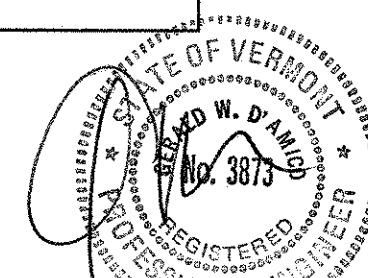


SOIL TYPES: (USDA CLASSIFICATION)

**30** - PAXTON FINE SANDY LOAM

**64** - USDA - STOCKBRIDGE GRAVELLY SILT LOAM

SOURCE: SOIL SURVEY OF RUTLAND COUNTY (1984)

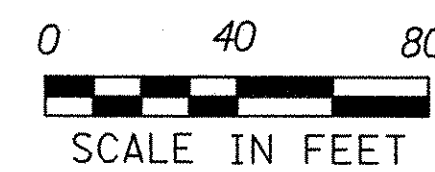

AIP 3-50-0015

DATUM  
VERTICAL NAVD 88  
HORIZONTAL NAD 83

SHEET NAME: EXISTING CONDITIONS PLAN WASTE AREA

PROJECT NAME: **CLARENDON**  
PROJECT NUMBER: **AIR 04-3172-C2**

FILE NAME: 38397036sheet22  
PROJECT LEADER: G. D'AMICO  
DESIGNED BY: R. DEWEY  
EROSION PREVENTION & SEDIMENT CONTROL

PLOT DATE: 2/16/2006  
DRAWN BY: R. DEWEY  
CHECKED BY: G. D'AMICO  
SHEET 22 OF 27

F:\38397036\Civil\Sheet\February 2006 Submission\38397036sheet22.dgn