
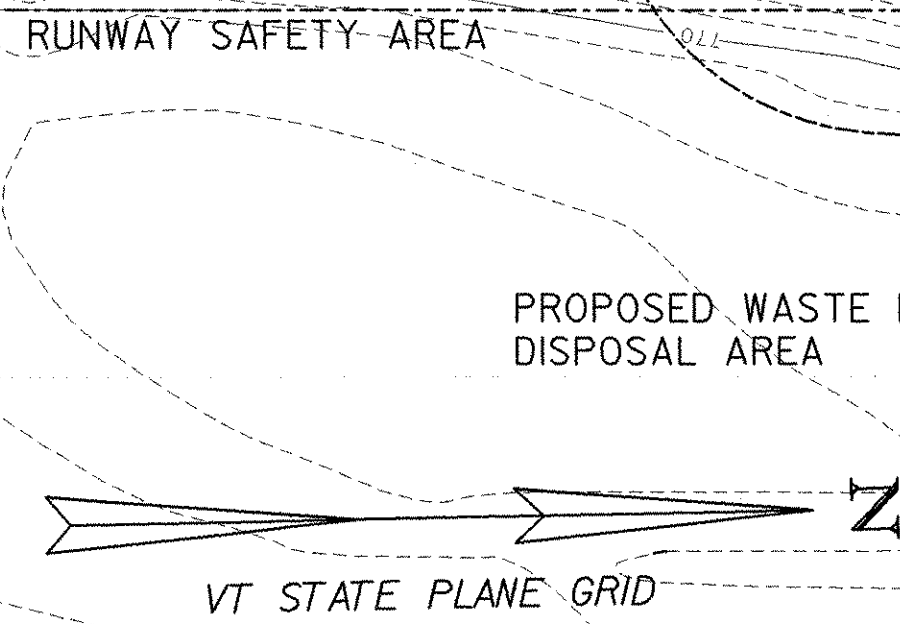


LEGEND

- 700 — EXISTING CONTOUR
- 700 — PROPOSED CONTOUR
- - - - - APPROX. GRADING LIMITS
- - - - - SF - SILT FENCE
- ▲ - - - - - WETLAND BOUNDRY
- - - - - WETLAND BUFFER ZONE
- PDF — PDF — PROJECT DEMARCATION FENCE
- ← - - - - - FLOW DIRECTION

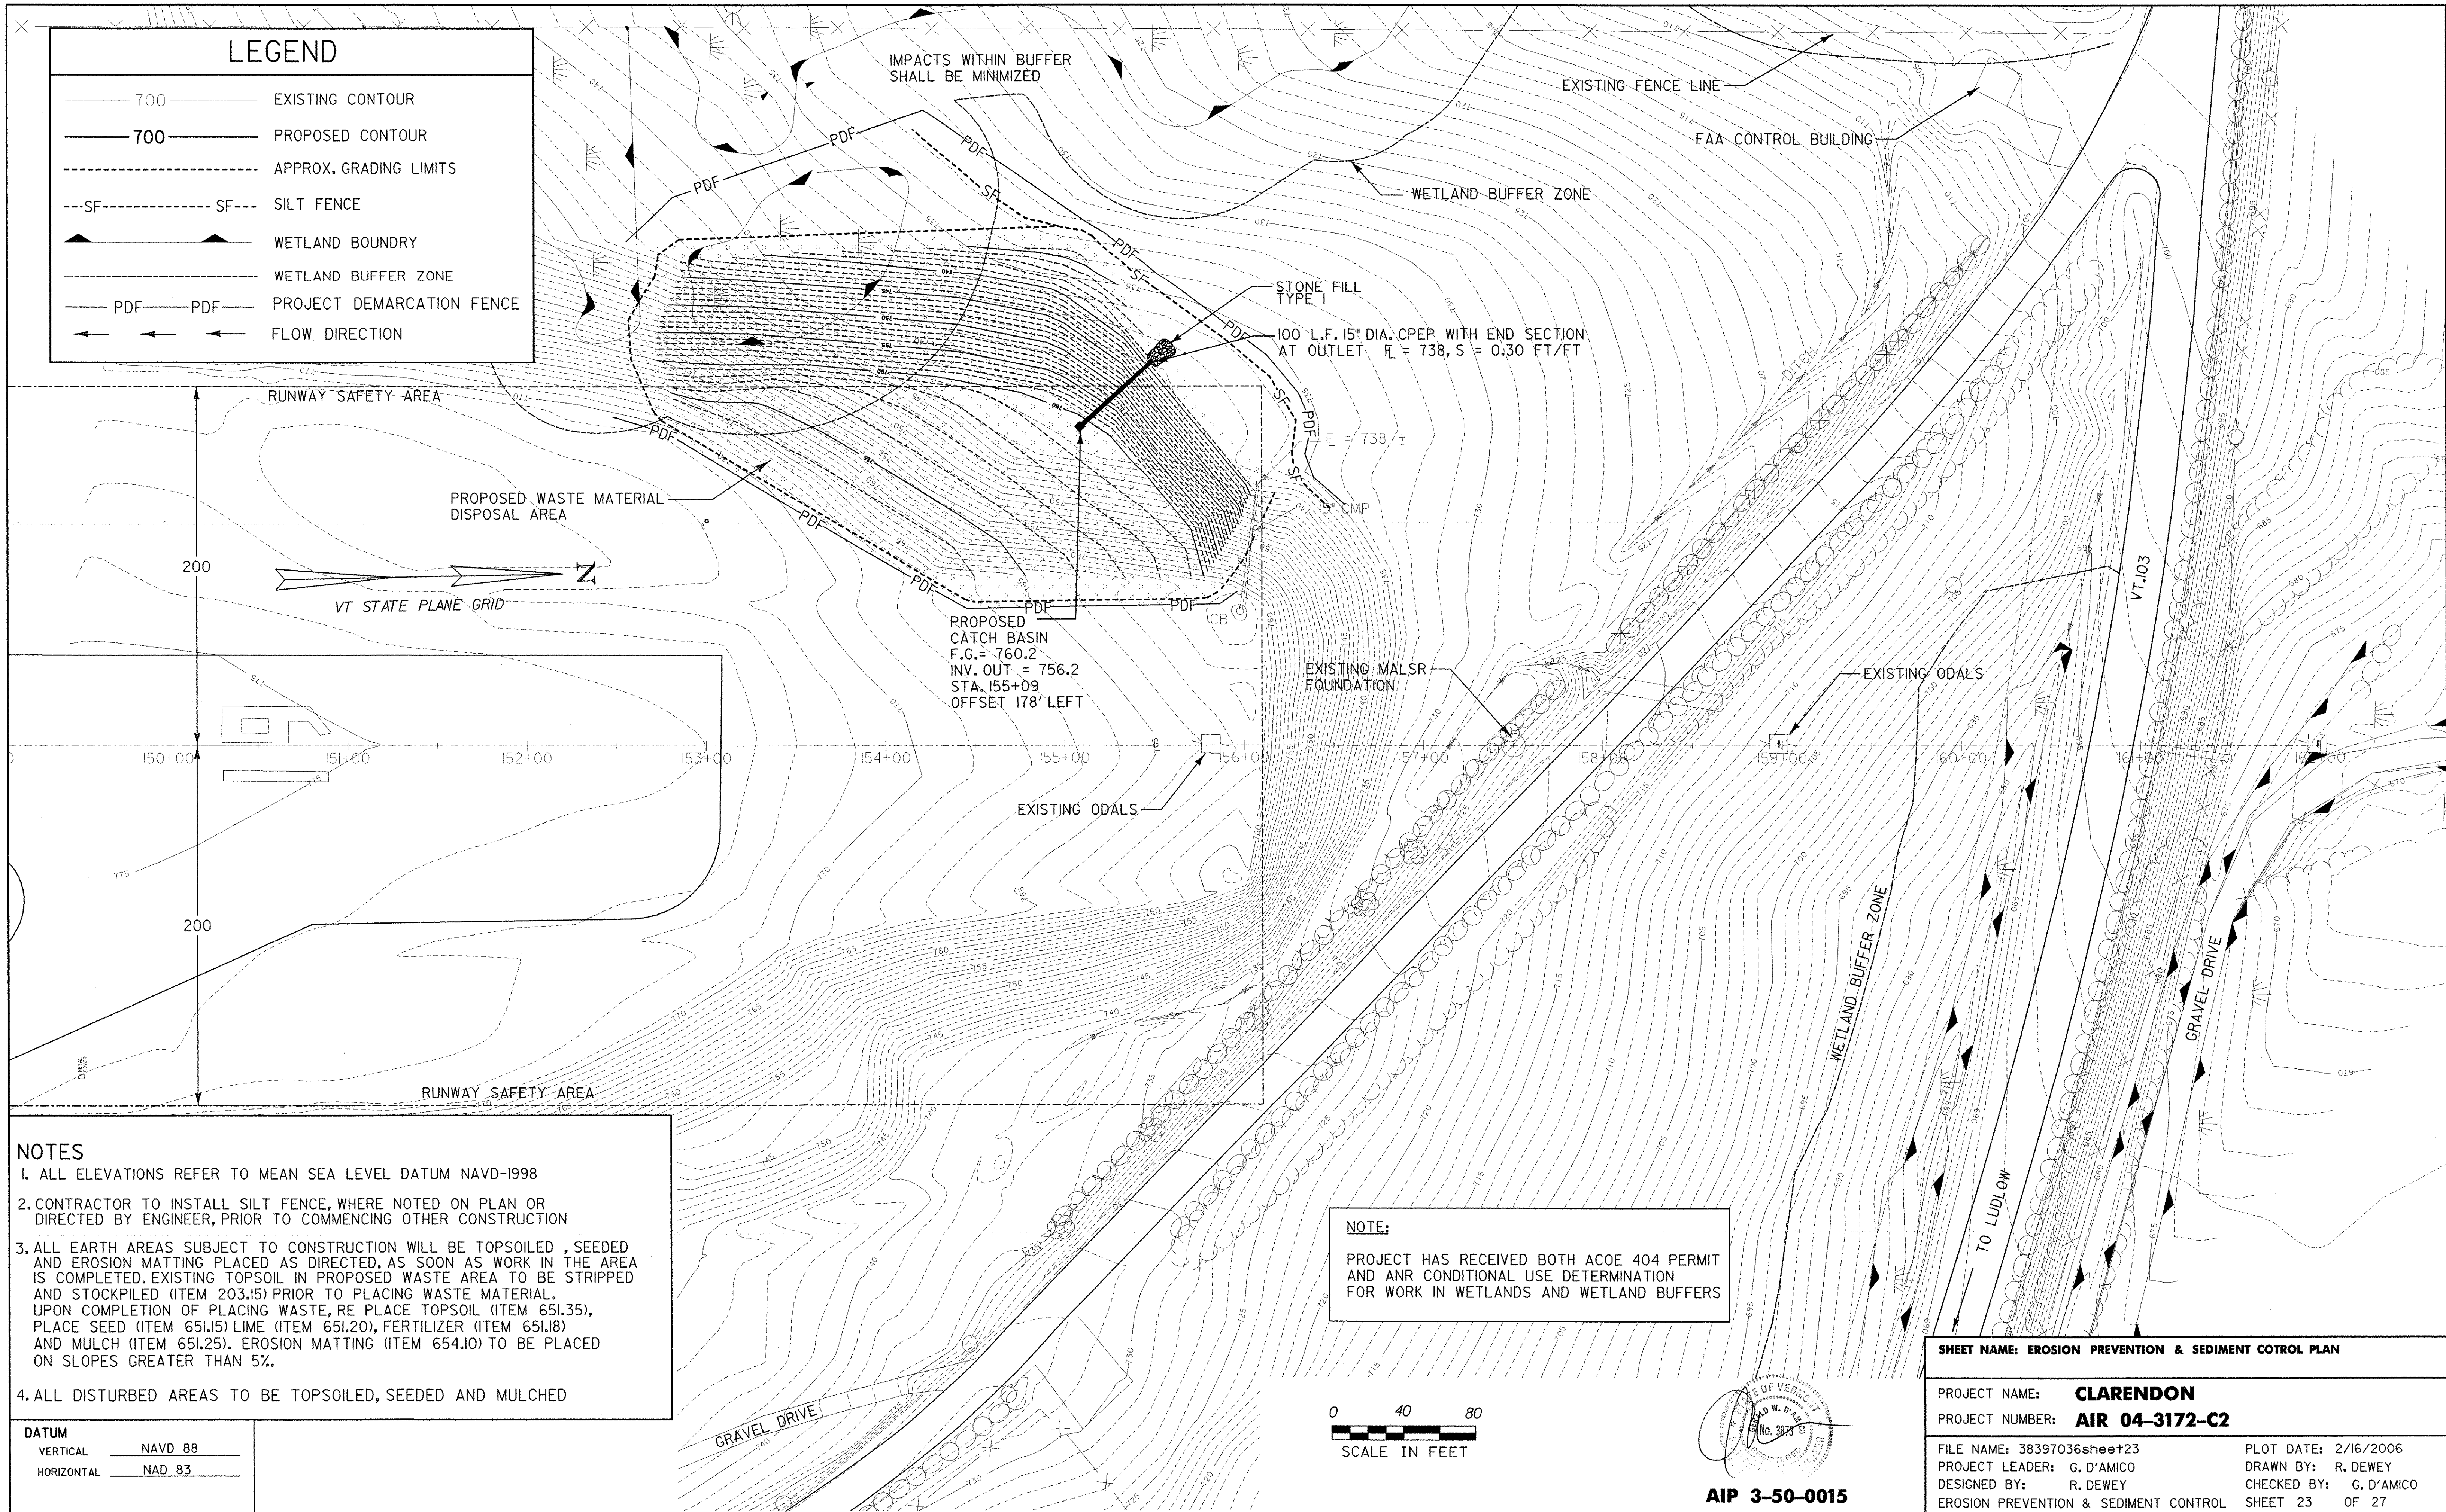


PROPOSED
CATCH BASIN
F.G. = 760.2
INV. OUT. = 756.2
STA. 155+09
OFFSET 178' LEFT

NOTE:
PROJECT HAS RECEIVED BOTH ACOE 404 PERMIT
AND ANR CONDITIONAL USE DETERMINATION
FOR WORK IN WETLANDS AND WETLAND BUFFERS

- NOTES**
1. ALL ELEVATIONS REFER TO MEAN SEA LEVEL DATUM NAVD-1998
 2. CONTRACTOR TO INSTALL SILT FENCE, WHERE NOTED ON PLAN OR DIRECTED BY ENGINEER, PRIOR TO COMMENCING OTHER CONSTRUCTION
 3. ALL EARTH AREAS SUBJECT TO CONSTRUCTION WILL BE TOPSOILED, SEEDED AND EROSION MATTING PLACED AS DIRECTED, AS SOON AS WORK IN THE AREA IS COMPLETED. EXISTING TOPSOIL IN PROPOSED WASTE AREA TO BE STRIPPED AND STOCKPILED (ITEM 203.15) PRIOR TO PLACING WASTE MATERIAL. UPON COMPLETION OF PLACING WASTE, RE PLACE TOPSOIL (ITEM 651.35), PLACE SEED (ITEM 651.15) LIME (ITEM 651.20), FERTILIZER (ITEM 651.18) AND MULCH (ITEM 651.25). EROSION MATTING (ITEM 654.10) TO BE PLACED ON SLOPES GREATER THAN 5%.
 4. ALL DISTURBED AREAS TO BE TOPSOILED, SEEDED AND MULCHED

DATUM

VERTICAL	NAVD 88
HORIZONTAL	NAD 83

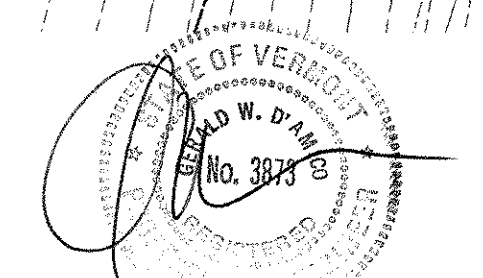

AIP 3-50-0015

SHEET NAME: EROSION PREVENTION & SEDIMENT CONTROL PLAN	
PROJECT NAME:	CLARENDON
PROJECT NUMBER:	AIR 04-3172-C2
FILE NAME:	38397036sheet23
PROJECT LEADER:	G. D'AMICO
DESIGNED BY:	R. DEWEY
EROSION PREVENTION & SEDIMENT CONTROL	SHEET 23 OF 27
PLOT DATE:	2/16/2006
DRAWN BY:	R. DEWEY
CHECKED BY:	G. D'AMICO

P:\38397036\Civil\Sheet\February 2006\Submission\38397036sheet23.dgn