



NO.	DATE	BY
1	11-29-06	HTA
2		
3		
4		
5		
6		
7		
8		
9		
10		

NO.	DATE	BY
1	11-29-06	HTA
2		
3		
4		
5		
6		
7		
8		
9		
10		


STA. 604+50

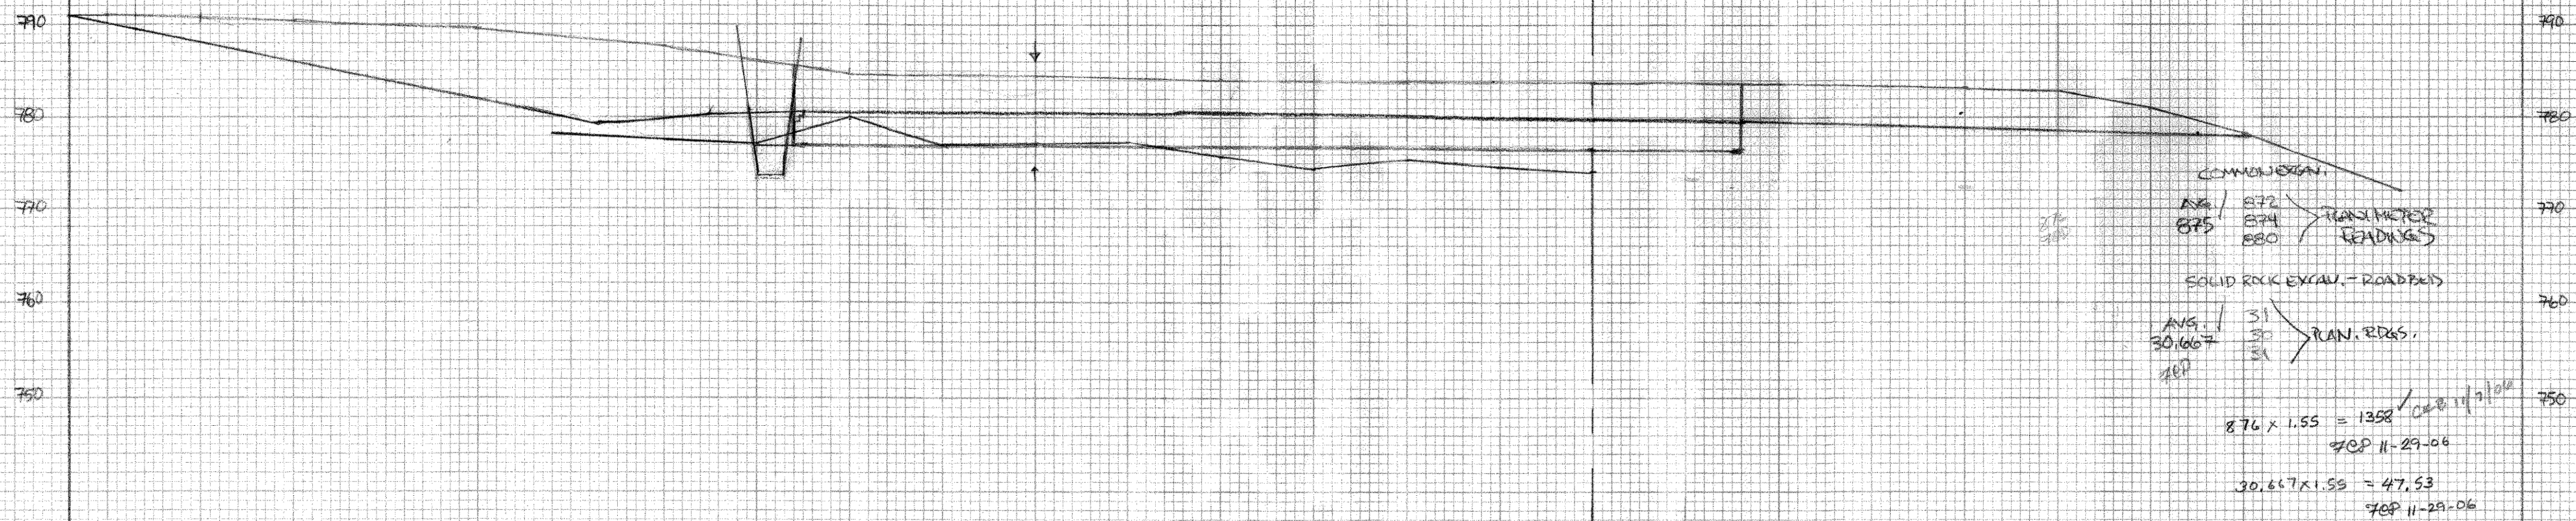

STA. 604+75

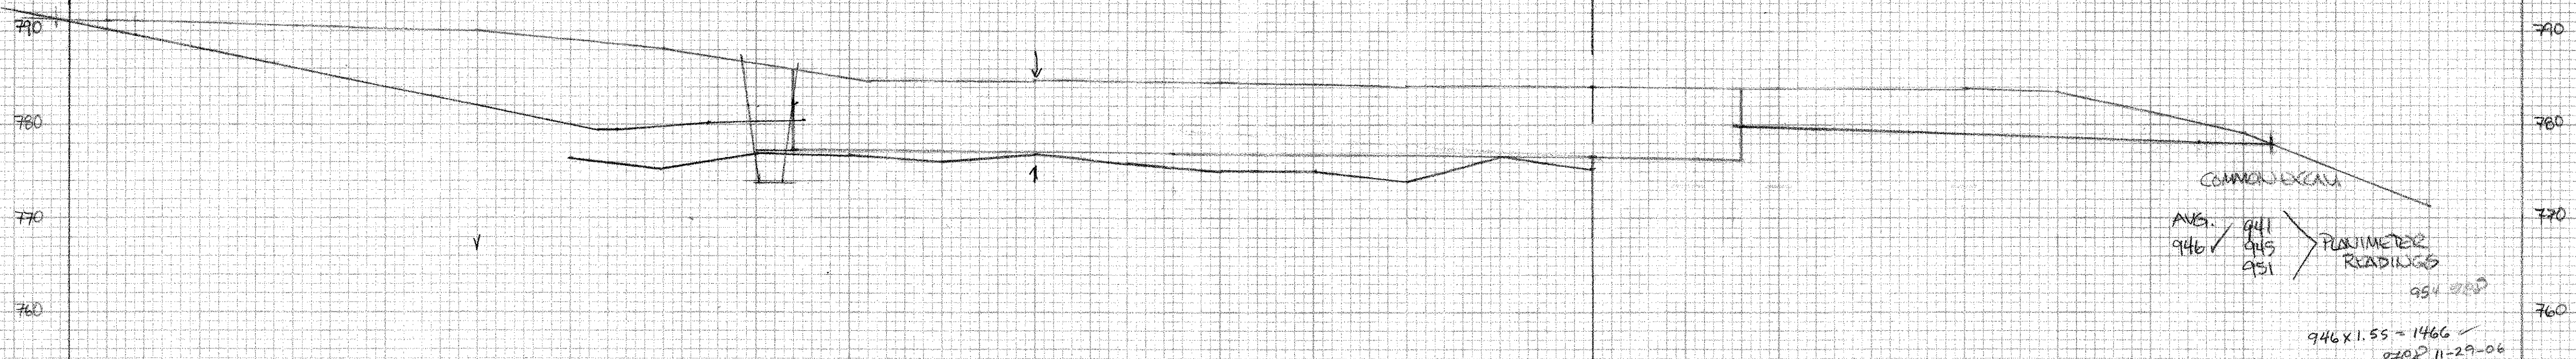

STA. 605+00

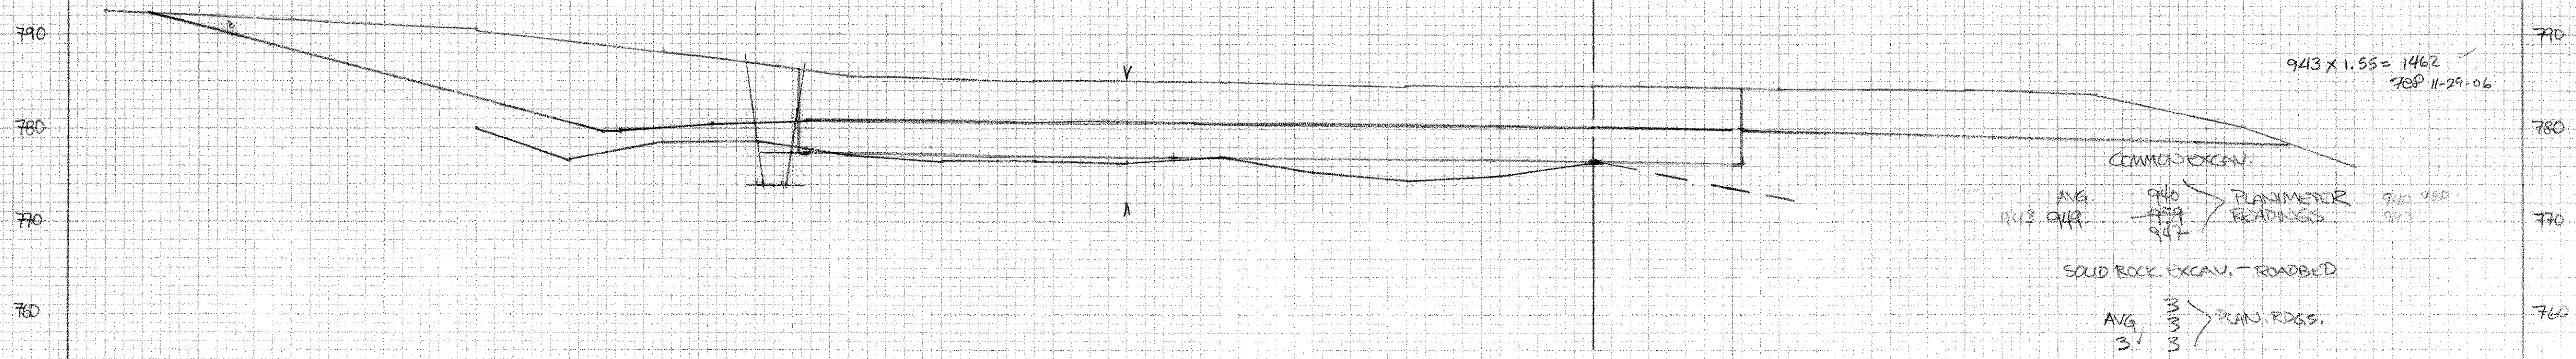

160 150 140 130 120 110 100 90 80 70 60 50 40 30 20 10 0 10 20 30 40 50 60 70 80 90

← LEFT RIGHT →

SCALE: 1 INCH = 10 FEET

CLARENCE AIR 04-3172 C/2

BY: P. REED - HTA

Planimeter led by SS & CRE 11-29-06