

**INDEX OF SHEETS**

- 1. TITLE SHEET
- 2. QUANTITY SHEET
- 3. PAVEMENT REPAIR DETAILS
- 4. MARKING PLAN

# STATE OF VERMONT AGENCY OF TRANSPORTATION




## PROPOSED IMPROVEMENT STATEWIDE AIRPORT CRACK SEALING



PROJECT NUMBER: AIR 04-3185

WORK TO BE PERFORMED UNDER THIS PROJECT INCLUDES PAVEMENT CRACK SEALING, ASPHALT PATCHING AND PAVEMENT MARKINGS AT THE FOLLOWING AIRPORTS:

- HARTNESS STATE AIRPORT
- MIDDLEBURY STATE AIRPORT
- RUTLAND STATE AIRPORT
- W.H. MORSE STATE AIRPORT

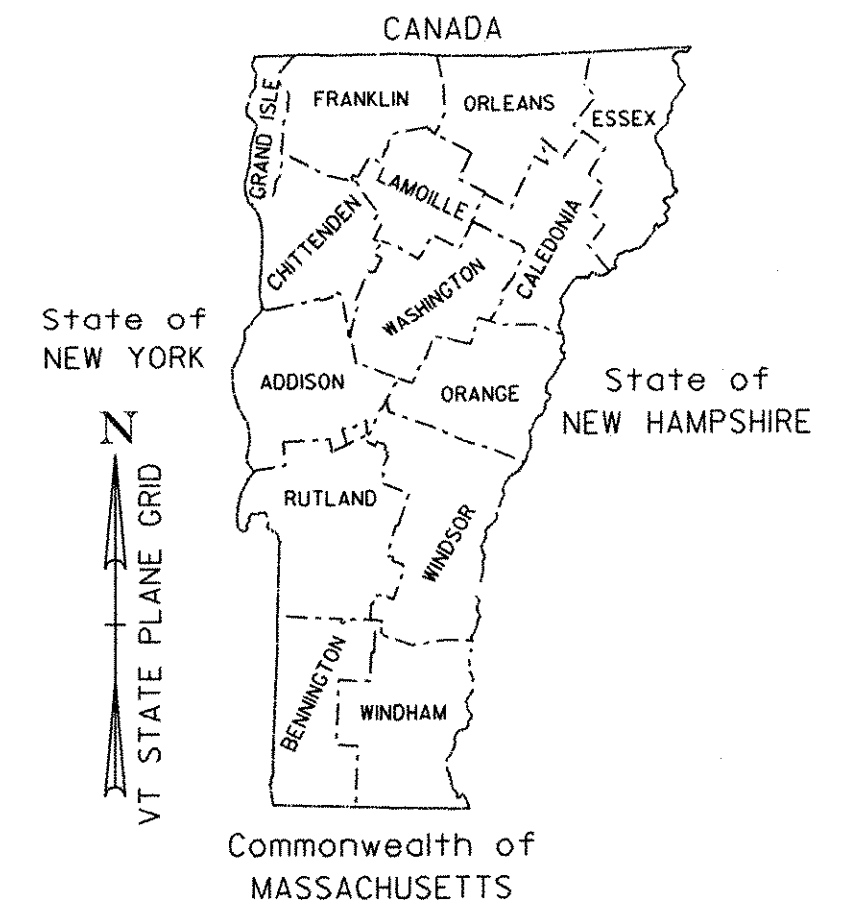


**Vermont Agency of Transportation Airports**

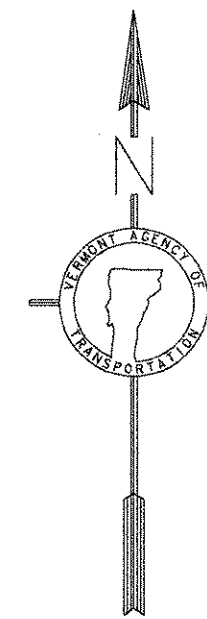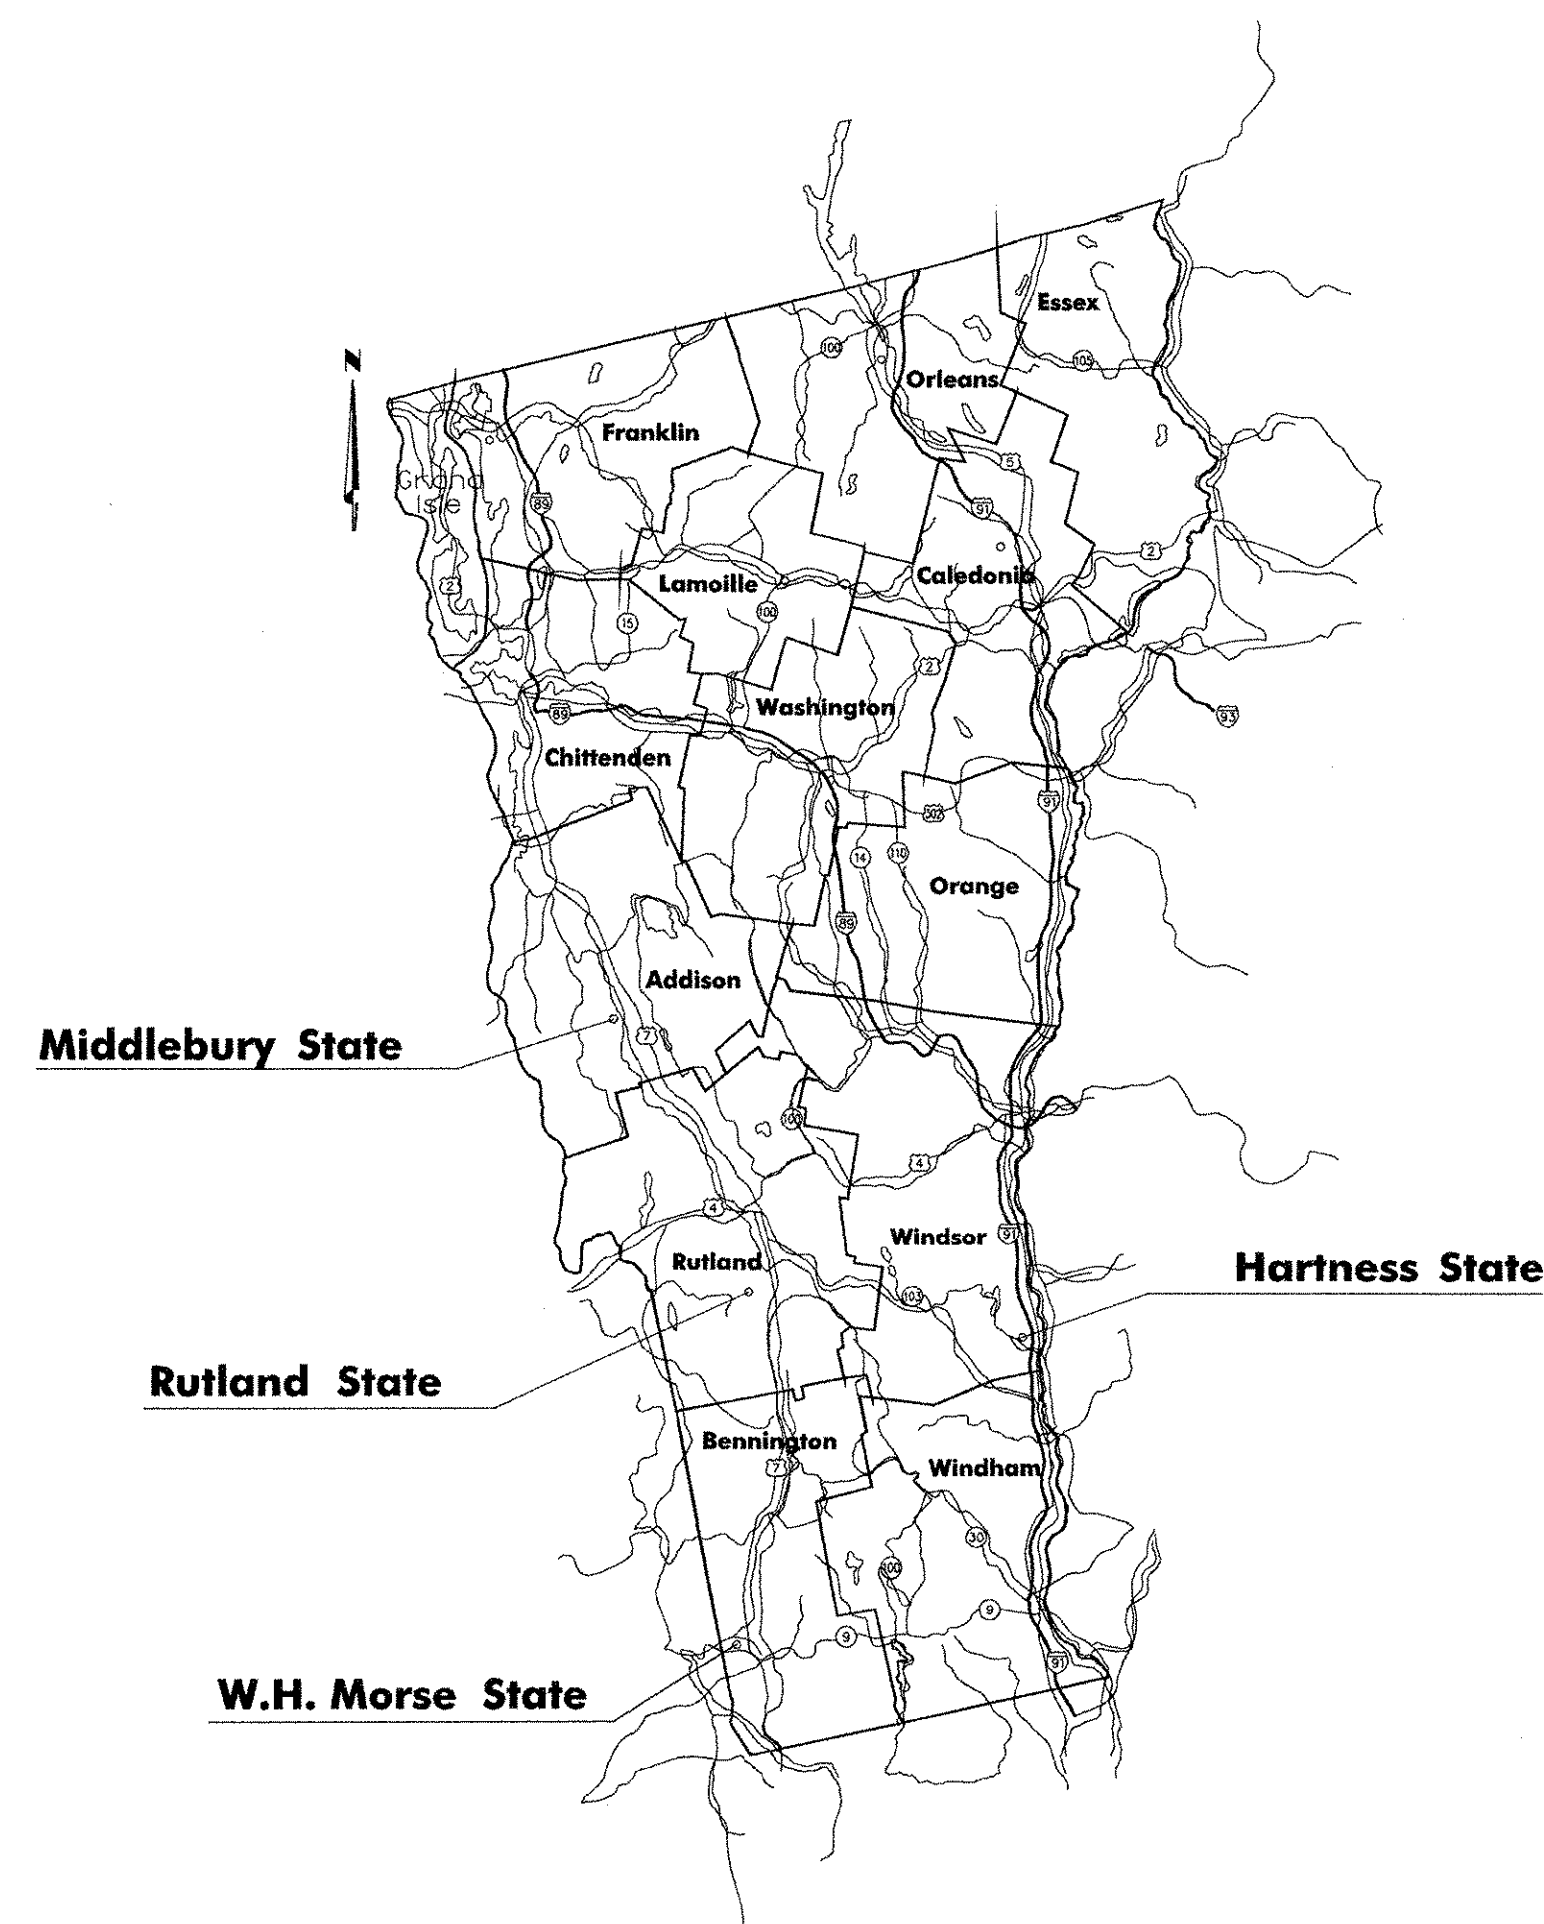

PLANS PREPARED BY



**CLOUGH HARBOUR & ASSOCIATES LLP**  
111 Winners Circle, PO Box 5268, Albany, NY 12205  
Main: (518) 453-4500 • www.coughharbour.com

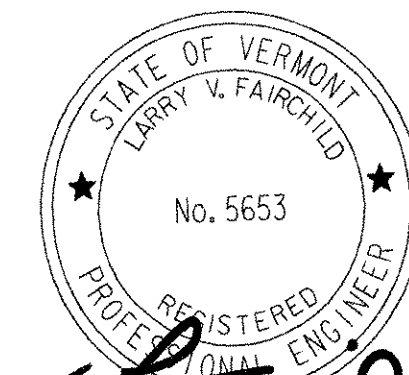

BY Larry V. Fairchild

CONSTRUCTION IS TO BE CARRIED ON IN ACCORDANCE WITH THESE PLANS AND THE STANDARD SPECIFICATIONS FOR CONSTRUCTION DATED 2001, AS APPROVED BY THE FEDERAL HIGHWAY ADMINISTRATION ON JANUARY 4, 2001 FOR USE ON THIS PROJECT, INCLUDING ALL SUBSEQUENT REVISIONS AND SUCH REVISED SPECIFICATIONS AND SPECIAL PROVISIONS AS ARE INCORPORATED IN THESE PLANS.

DIRECTOR OF OPERATIONS DIVISION	
APPROVED <u>[Signature]</u>	DATE <u>12/1/05</u>
PROJECT MANAGER : FORTNEY	
PROJECT NAME : STATEWIDE AIRPORT CRACK SEALING	
PROJECT NUMBER : AIR 04-3185	
SHEET 1 OF 4 SHEETS	

**CONVENTIONAL SYMBOLS**

COUNTY LINE	
TOWN LINE	
LIMITS OF ACCESS	
POINT OF ACCESS	
FENCE LINE	
STONE WALL	
TRAVELED WAY	
GUARD RAIL	
RAILROAD	
SURVEY LINE	
CULVERT	
POWER POLE	
TELEPHONE POLE	
TREES	
CONTROL OF ACCESS	
PROPERTY LINE	
R.O.W. TAKING LINE	
SLOPE RIGHTS	
TOP OF CUT	
TOE OF SLOPE	