

VICINITY MAP

STATE OF VERMONT AGENCY OF TRANSPORTATION



PROPOSED IMPROVEMENT TOWN OF CLARENDON COUNTY OF RUTLAND RUTLAND SOUTHERN VERMONT REGIONAL AIRPORT

RUNWAY 19 SAFETY AREA IMPROVEMENTS PHASE I, TO INCLUDE:

1. RELOCATE A PORTION OF AIRPORT ROAD (28' x 760')
2. CONSTRUCT RIGHT TURN LANE OFF ROUTE 103
3. REPAVE A PORTION OF AIRPORT ROAD (22' x 4100')
4. CONSTRUCT NEW SEWER FORCE MAIN & WATER WELL Δ
- Δ 5. EXTEND & PAVE FBO PARKING AREA (APPROX. 500 SY)

Δ AIP 3-50-0015-34 (DESIGN)
Δ AIP 3-50-0015-41 (CONSTRUCTION)

**RECORD DRAWING
DECEMBER 27, 2013**

DESIGN CERTIFICATION

THESE PLANS AND SPECIFICATIONS HAVE BEEN PREPARED IN ACCORDANCE WITH CURRENT FAA STANDARDS IDENTIFIED IN ADVISORY CIRCULAR CHECKLIST, AC 00-2.13, DATED JANUARY 25, 2012. DEVIATIONS FROM FAA STANDARDS ARE DISCUSSED IN THE ENGINEER'S REPORT, DATED FEBRUARY, 2013.

URS CORPORATION

DATE

STANDARD NOTE

THESE PLANS ARE SUBJECT TO SUCH ENGINEERING CHANGES AS MAY BE REQUIRED BY THE FEDERAL AVIATION ADMINISTRATION OR THE DIRECTOR OF POLICY PLANNING AND INTERMODAL DEVELOPMENT.

CONSTRUCTION IS TO CARRIED ON IN ACCORDANCE WITH THESE PLANS, FAA ADVISORY CIRCULAR 150/5370-10F, AND THE STANDARD SPECIFICATIONS FOR CONSTRUCTION, DATED 2011, AS APPROVED BY THE FEDERAL HIGHWAY ADMINISTRATION INCLUDING ALL SUBSEQUENT REVISIONS AND SUCH REVISED SPECIFICATIONS AND SPECIAL PROVISIONS AS ARE INCORPORATED IN THESE PLANS.

DEPARTMENT OF TRANSPORTATION
FEDERAL AVIATION ADMINISTRATION

APPROVED _____ DATE _____

DIRECTOR, POLICY PLANNING AND
INTERMODAL DEVELOPMENT

APPROVED _____ DATE _____

PROJECT MANAGER | SCOTT FORTNEY

PROJECT NAME | RUTLAND SOUTHERN VERMONT
REGIONAL AIRPORT-
CLARENDON, VERMONT

PROJECT NUMBER | AV148001-300
SHEET | OF 29 SHEETS


PLANS PREPARED BY:



URS CORPORATION
3 CORPORATE DRIVE, SUITE 203
CLIFTON PARK, NY 12065
PH# (518) 688-0005

URS PROJECT NO.
38397211

Δ RECORD DRAWING

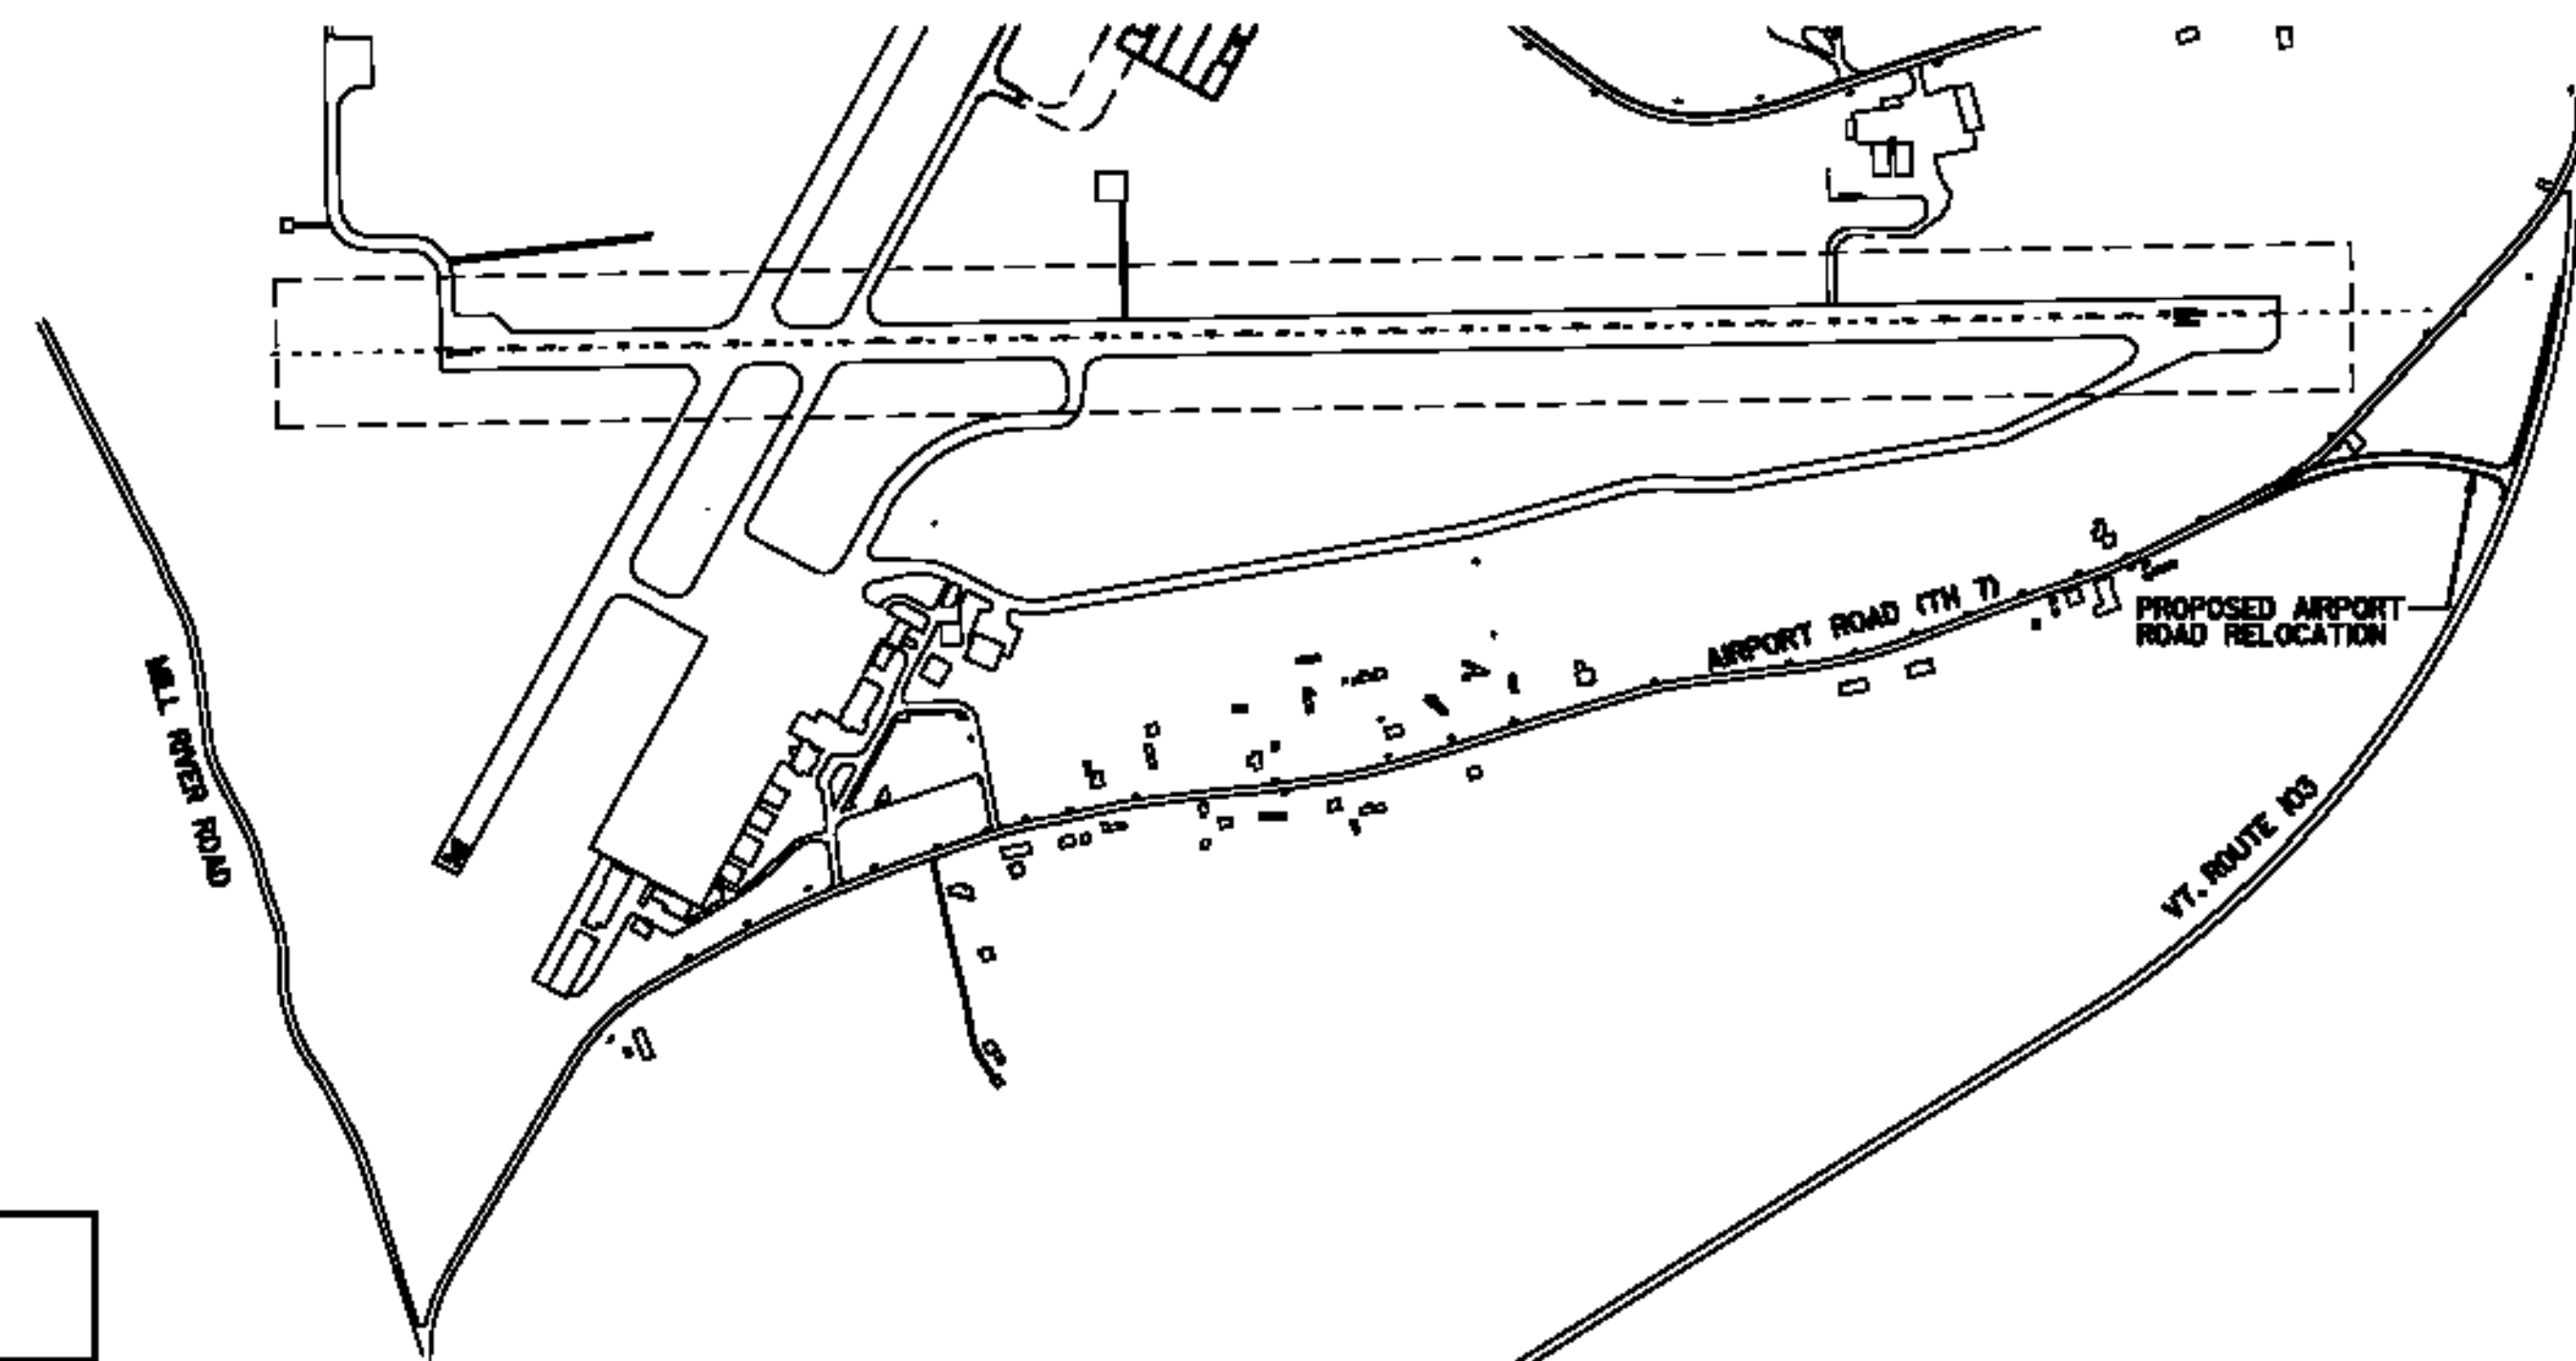

500 0 500

CONVENTIONAL SYMBOLS

COUNTY LINE	———
TOWN LINE	———
LIMITS OF ACCESS	○——○
POINT OF ACCESS	X
FENCE LINE	X—X—X—X—X
STONE WALL	○—○—○—○—○
TRAVELED WAY	———
GUARD RAIL	○—○—○—○—○
RAILROAD	———
SURVEY LINE	———
CULVERT	———
POWER POLE	⊕
TELEPHONE POLE	⊕
TREES	⊙
CONTROL OF ACCESS	///
PROPERTY LINE	———
R.O.W. TAKING LINE	SR ○ SR ○ SR
SLOPE RIGHTS	○—△—○
TOP OF CLUT	△
TOE OF SLOPE	○

SURVEYED BY | URS CORPORATION
SURVEYED DATE | 2005 - 2012

DATUM
VERTICAL NGVD 88
HORIZONTAL NAD 83