



12/30/2013 J:\38397229 RUT RSA 19 Improvements Final Design & CIPhase \6.0 CADD\6.1 Plan Sheets\RECORD DRAWINGS\z07h124pro_road-rd.dgn

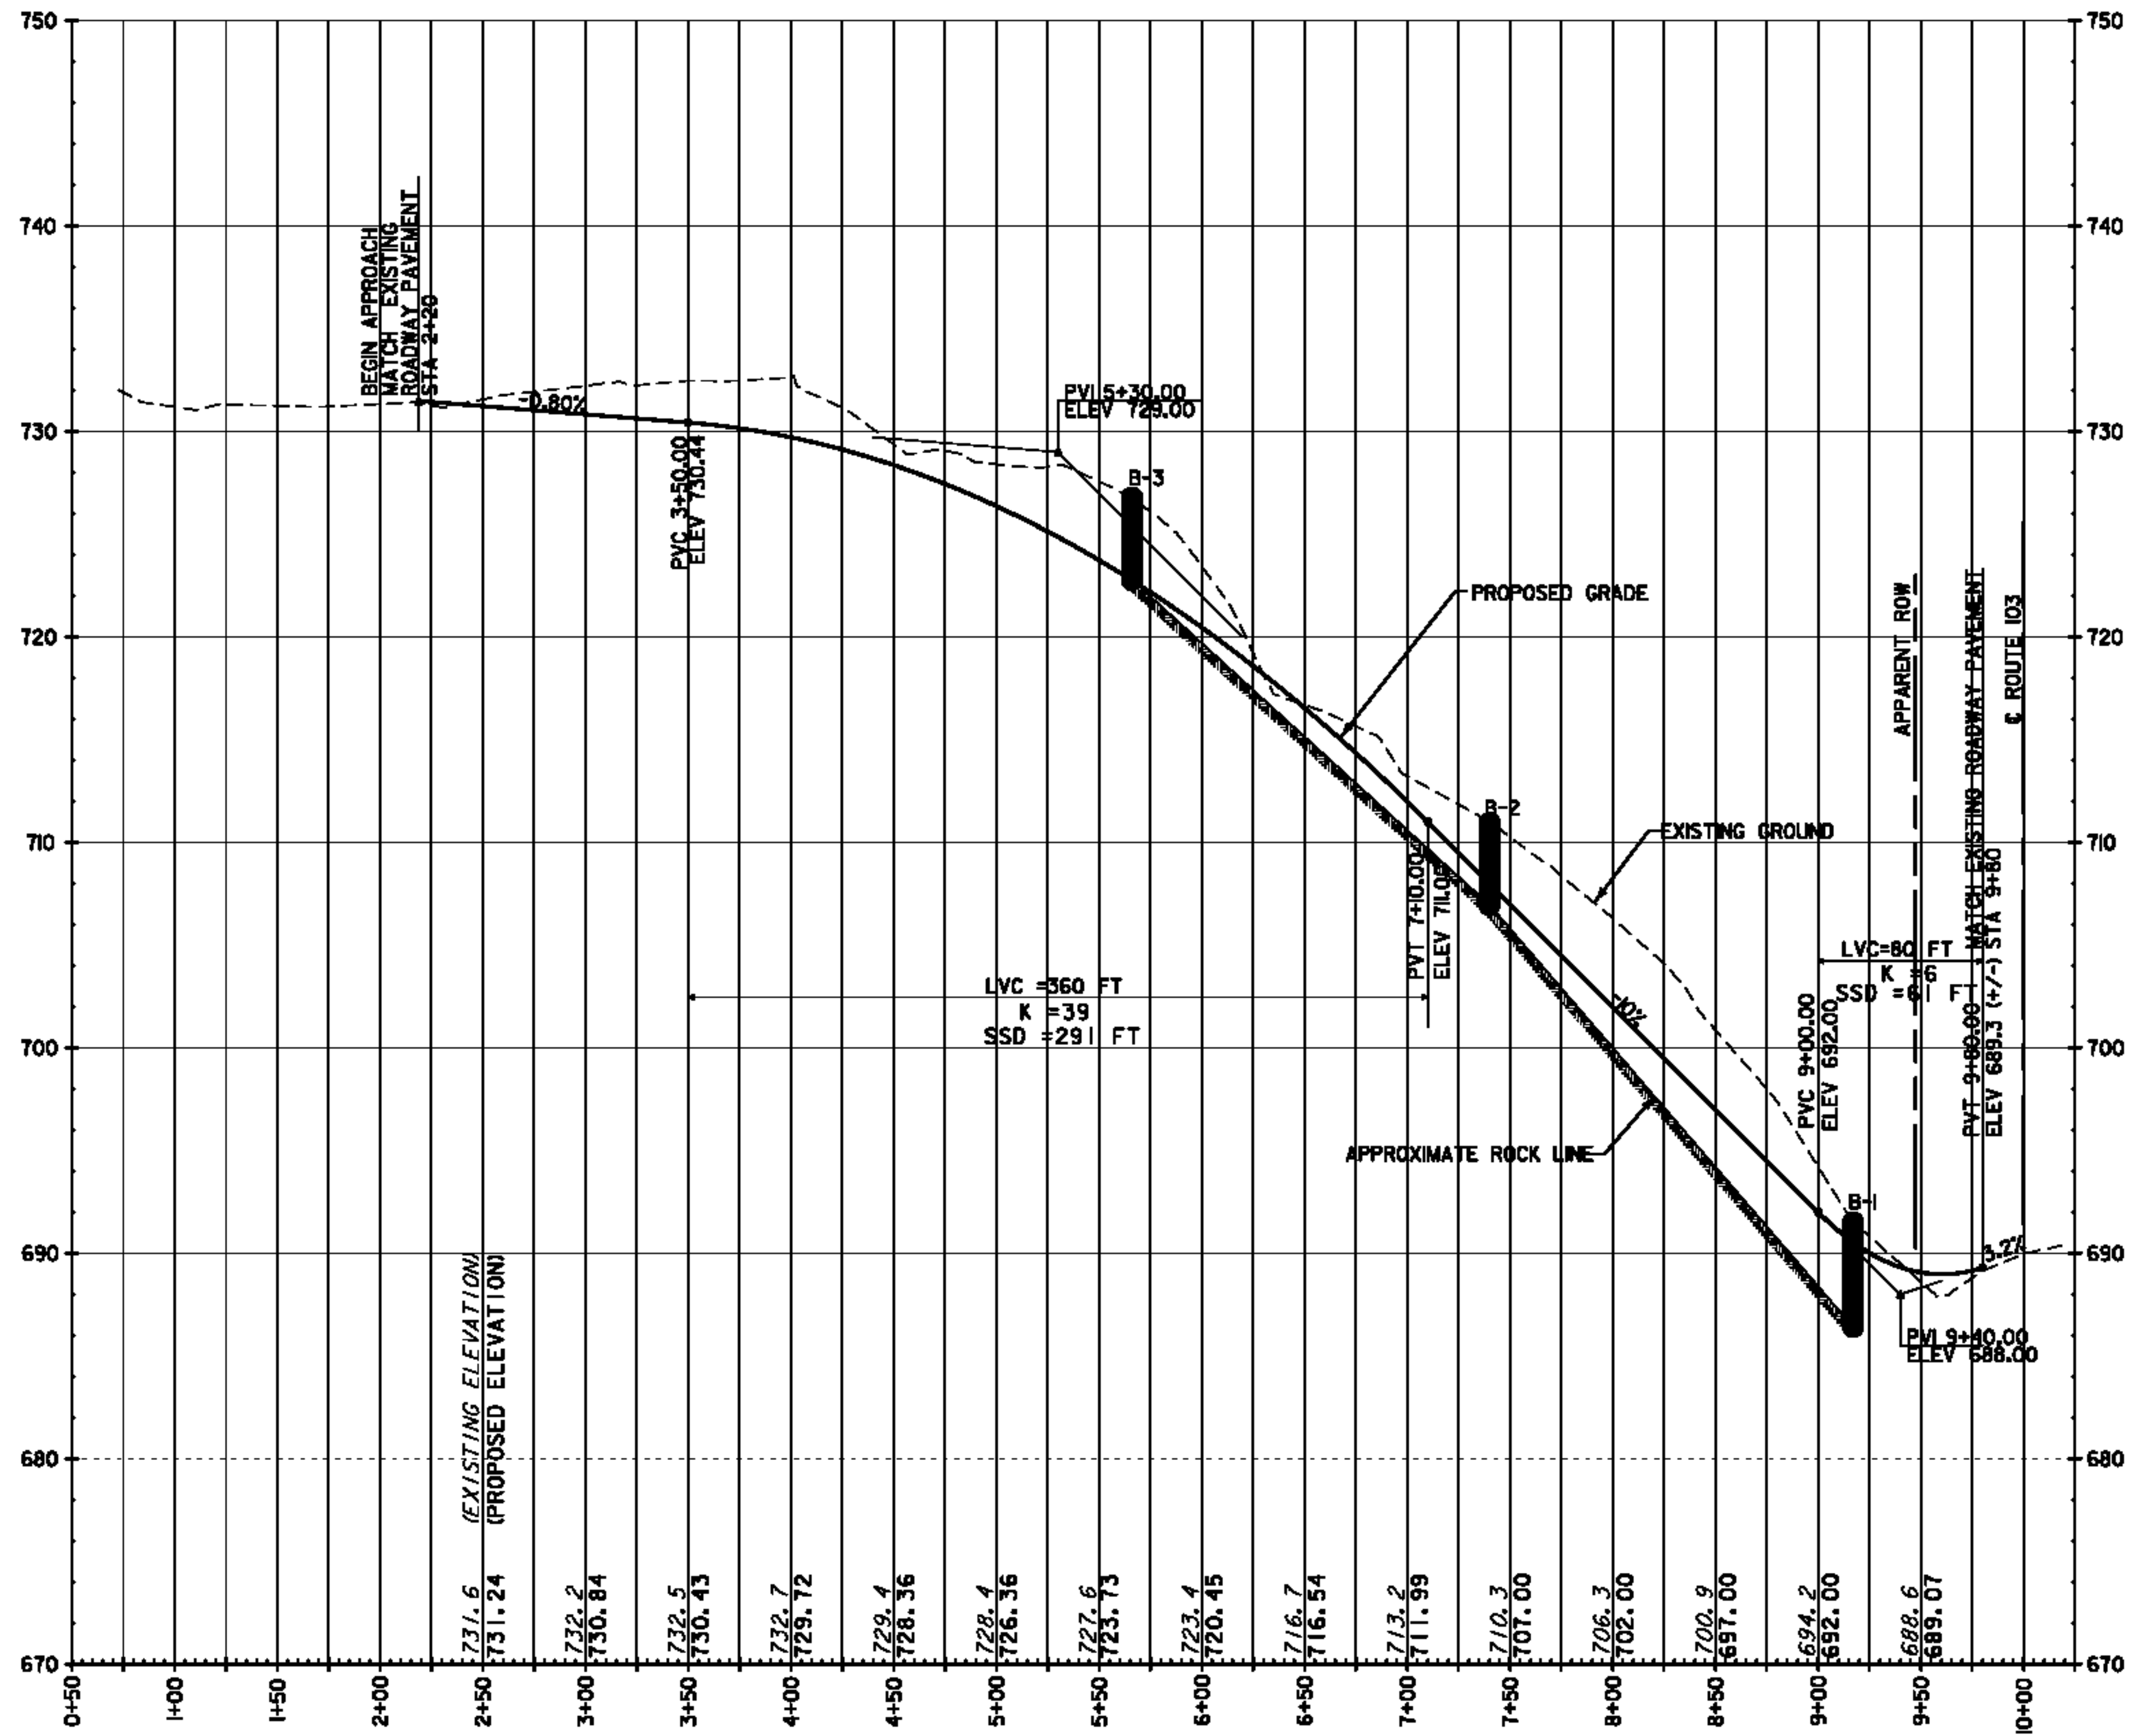

**RECORD DRAWING
DECEMBER 27, 2013**

NOTES:
BORINGS B-1, B-2, B-3 WERE RECORDED BY
GEODESIGN, INC., ON JULY 20, 2009.
SEE BORING LOGS ON SHEET 35 OF 65.

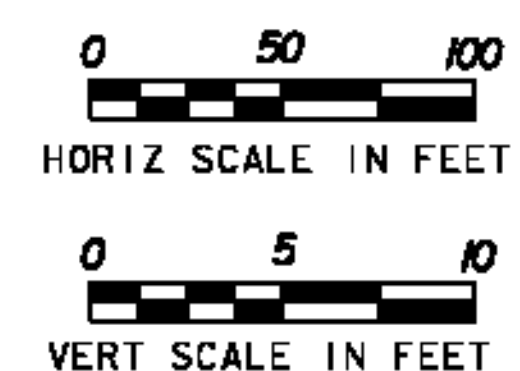

AP 3-50-0015-34

AIRPORT ACCESS ROAD (RELOCATED)

VERMONT AGENCY OF TRANSPORTATION	
URS	
URS CORPORATION 3 CORPORATE DRIVE, SUITE 203 CLIFTON PARK, NY 12065 (518) 688-0015	
PROJECT NAME: RUTLAND SOUTHERN VERMONT REGIONAL AIRPORT CLARENDON, VERMONT PROJECT NUMBER: AV14-8008-300	FILE NAME: z07h124pro_road-rd.dgn PROJECT LEADER: F. WALSH DESIGNED BY: A. JOHNSON AIRPORT ROAD-PROFILE
PLOT DATE: 12/30/2013 DRAWN BY: J. RICHARDS CHECKED BY:	SHEET 12 OF 29