


12/30/2013 J:\38397229 RUT RSA 19 Improvements Final Design & CIPhase \6.0 CADD\6.1 Plan Sheets\RECORD DRAWINGS\z07h124mp_road-rd.dgn



NOTES:
 1. THE FOLLOWING VTRANS STANDARD SHEETS WERE USED FOR THE ABOVE SIGNAGE: E-136B, E-142, E-143, E-152, E-191, E-192
 2. SEE SHEET 20 FOR SIGN TYPES AND SIZES 15

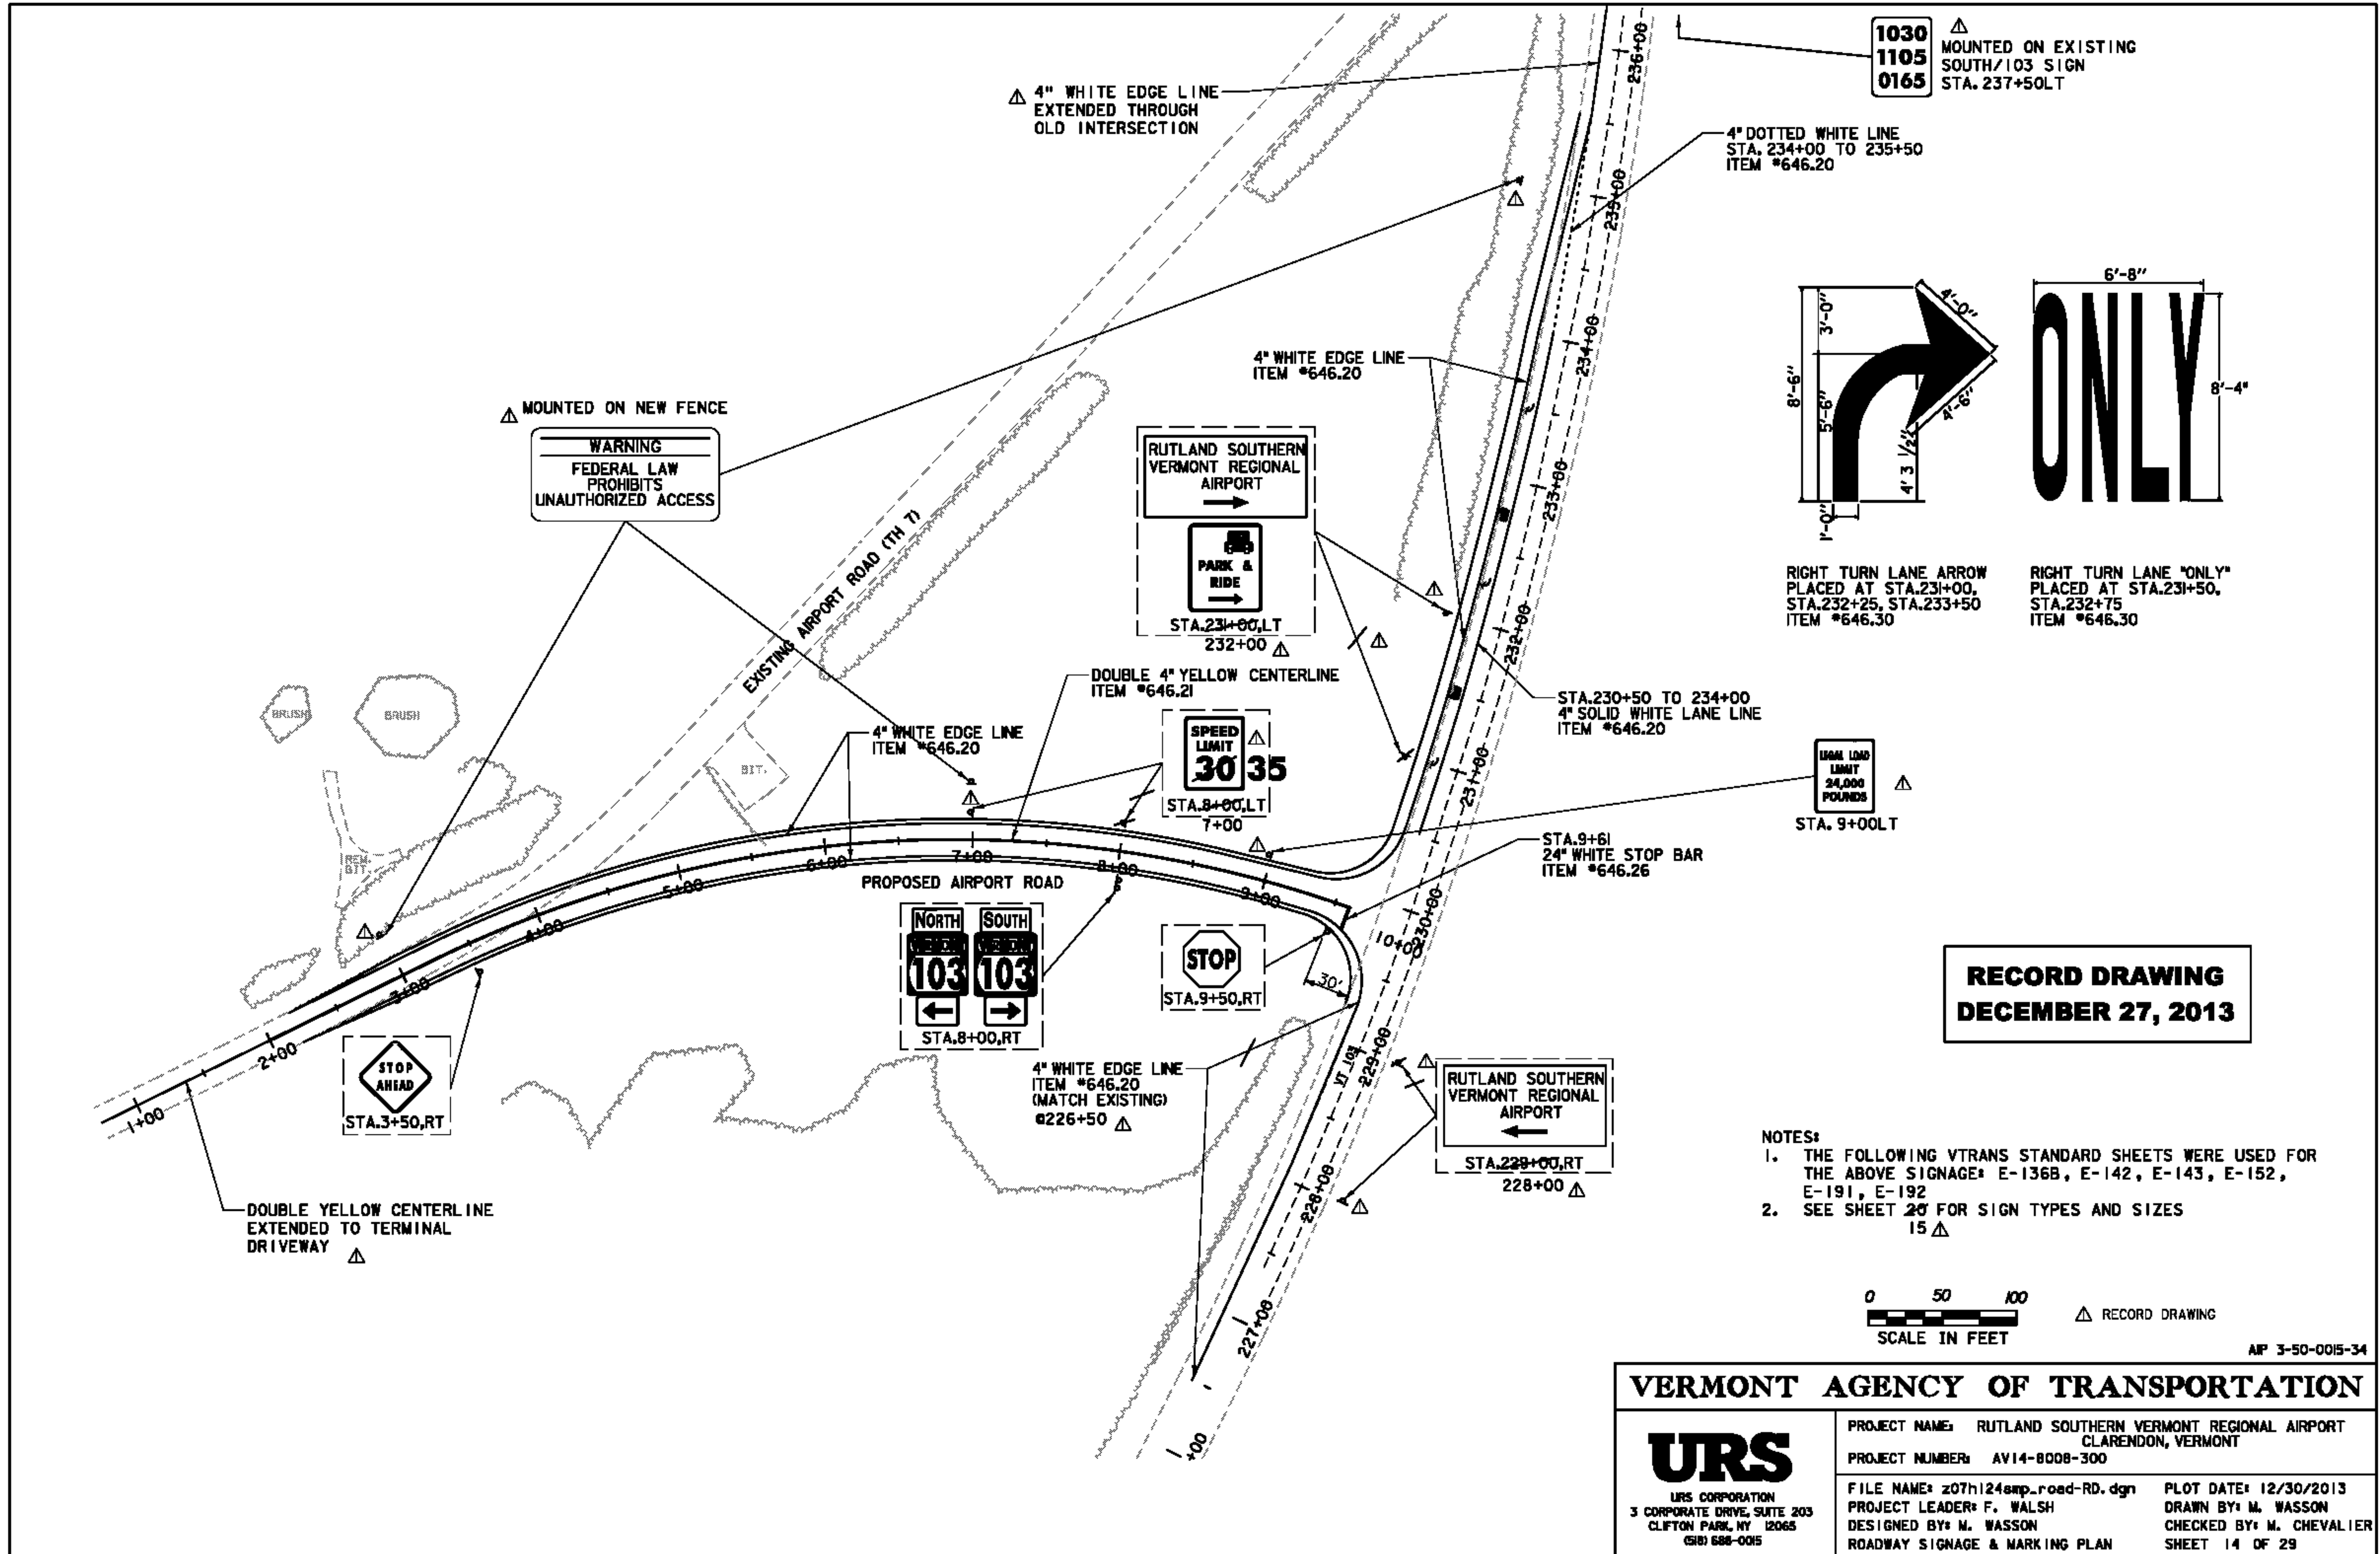

RECORD DRAWING

MP 3-50-0015-34

VERMONT AGENCY OF TRANSPORTATION

URS
 URS CORPORATION
 3 CORPORATE DRIVE, SUITE 203
 CLIFTON PARK, NY 12065
 (518) 688-0015

PROJECT NAME: RUTLAND SOUTHERN VERMONT REGIONAL AIRPORT
 CLARENDON, VERMONT
 PROJECT NUMBER: AV14-8008-300
 FILE NAME: z07h124mp_road-rd.dgn
 PROJECT LEADER: F. WALSH
 DESIGNED BY: M. WASSON
 ROADWAY SIGNAGE & MARKING PLAN
 PLOT DATE: 12/30/2013
 DRAWN BY: M. WASSON
 CHECKED BY: M. CHEVALIER
 SHEET 14 OF 29