


TRAFFIC CONTROL SIGNING FOR PHASE 1-1b, 1-1c AND 1-2b LANE SHIFT

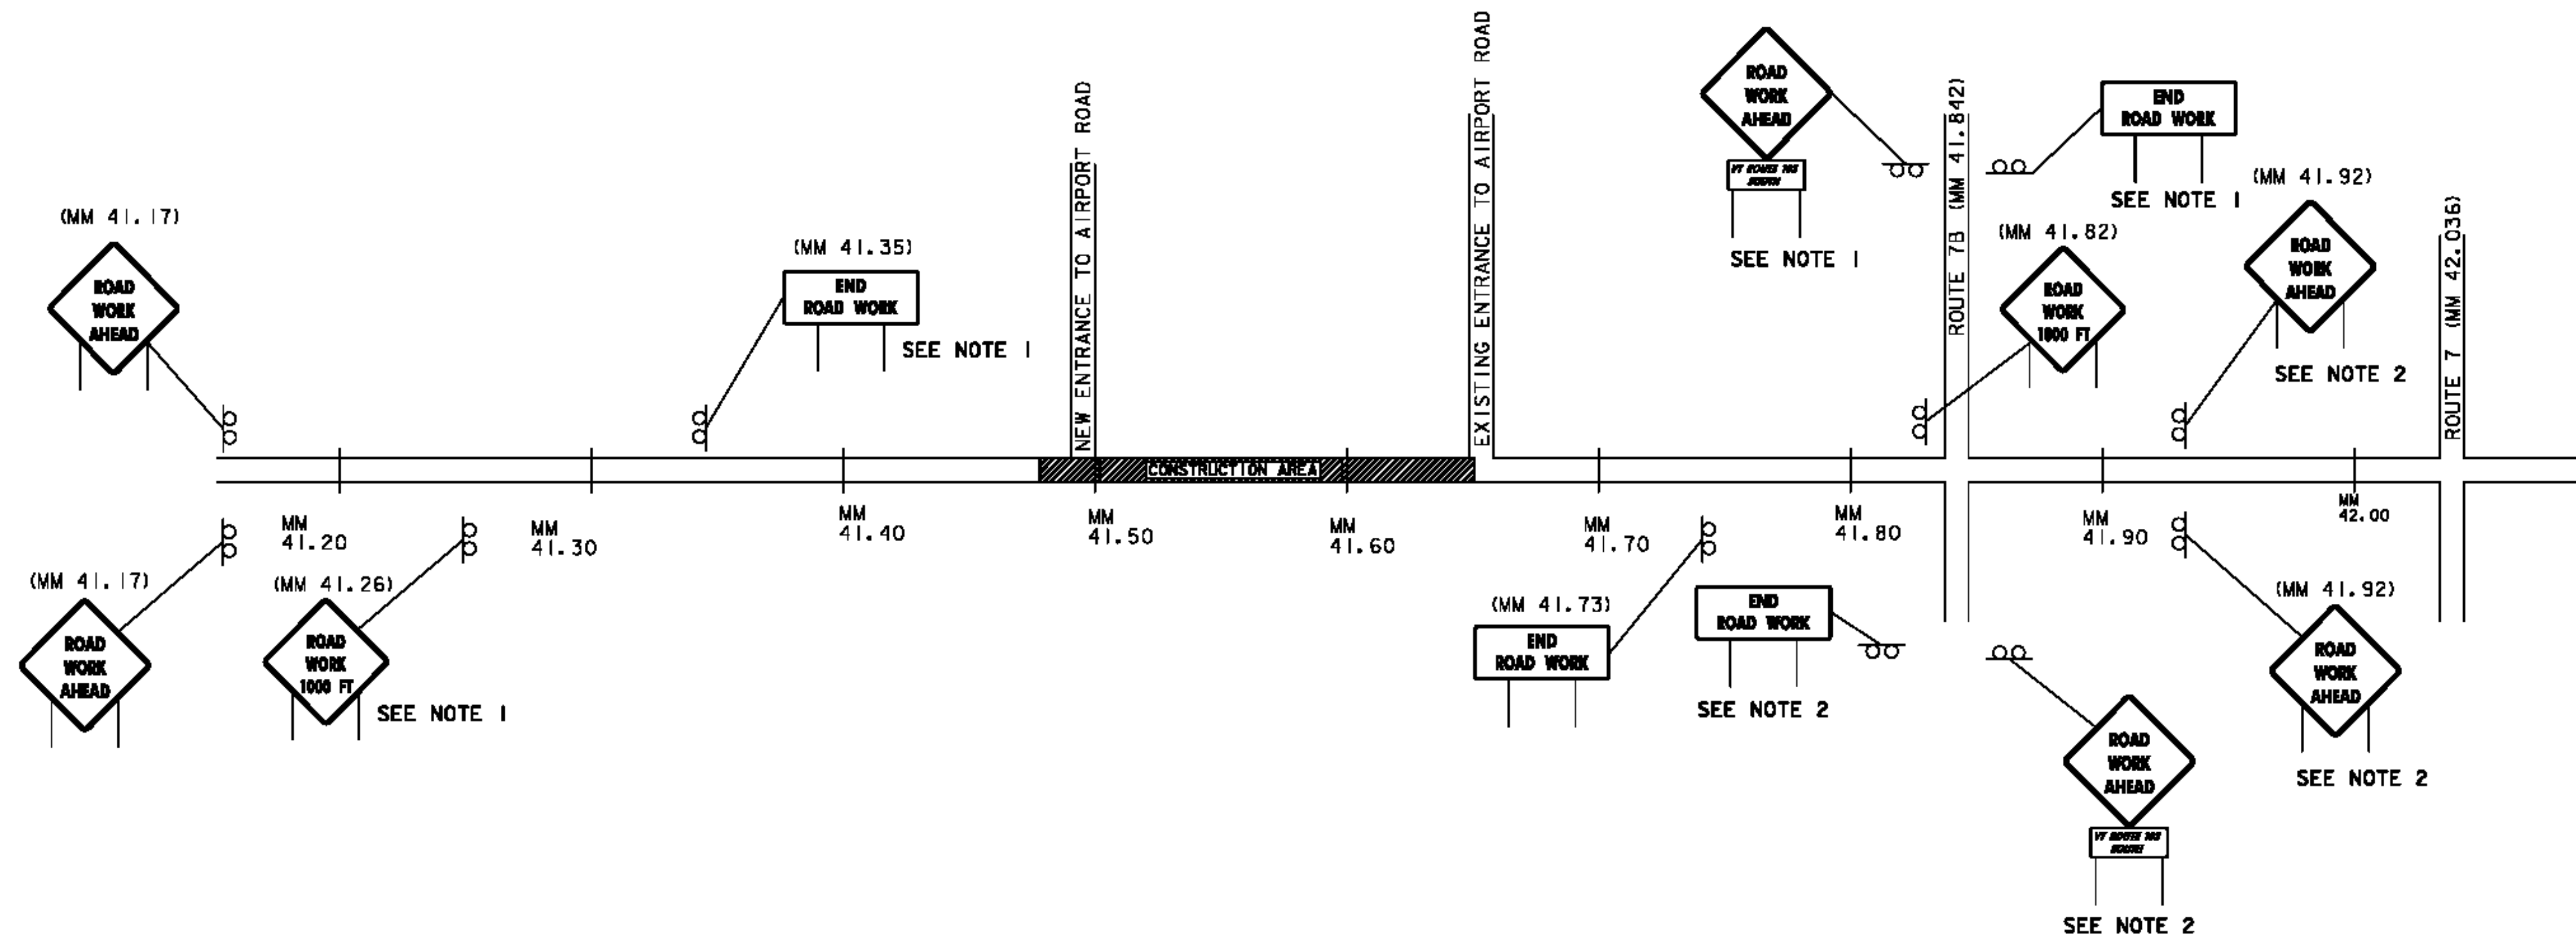

**RECORD DRAWING
DECEMBER 27, 2013**

- NOTES:
- 1) ROADWORK AHEAD SIGNS TO BE RELOCATED AS SHOWN ON PHASE 2 TRAFFIC CONTROL PLAN
 - 2) ROAD WORK AHEAD SIGNS TO REMAIN AS SHOWN FOR PHASE 2 CONSTRUCTION
 - 3) CONSTRUCTION SIGNS WERE INSTALLED ESSENTIALLY AS SHOWN

△ RECORD DRAWING

AP 3-50-0015-34

VERMONT AGENCY OF TRANSPORTATION



URS CORPORATION
3 CORPORATE DRIVE, SUITE 203
CLIFTON PARK, NY 12065
(518) 688-0015

PROJECT NAME: RUTLAND SOUTHERN VERMONT REGIONAL AIRPORT
CLARENDON, VERMONT
PROJECT NUMBER: AV14-8008-300
FILE NAME: z07h124ts_03-RD.dgn
PLOT DATE: 12/30/2013
PROJECT LEADER: F. WALSH
DRAWN BY: R. ROSS
DESIGNED BY: R. ROSS
CHECKED BY: M. CHEVALIER
TRAFFIC CONTROL PLAN (3)
SHEET 19 OF 29

12/30/2013 J:\38397229 RUT RSA 19 Improvements Final Design & CIPhase 1\6.0 CADD\6.1 Plan Sheets\RECORD DRAWINGS\z07h124ts_03-RD.dgn