


TRAFFIC CONTROL SIGNING FOR PHASE 1-2A DETOUR

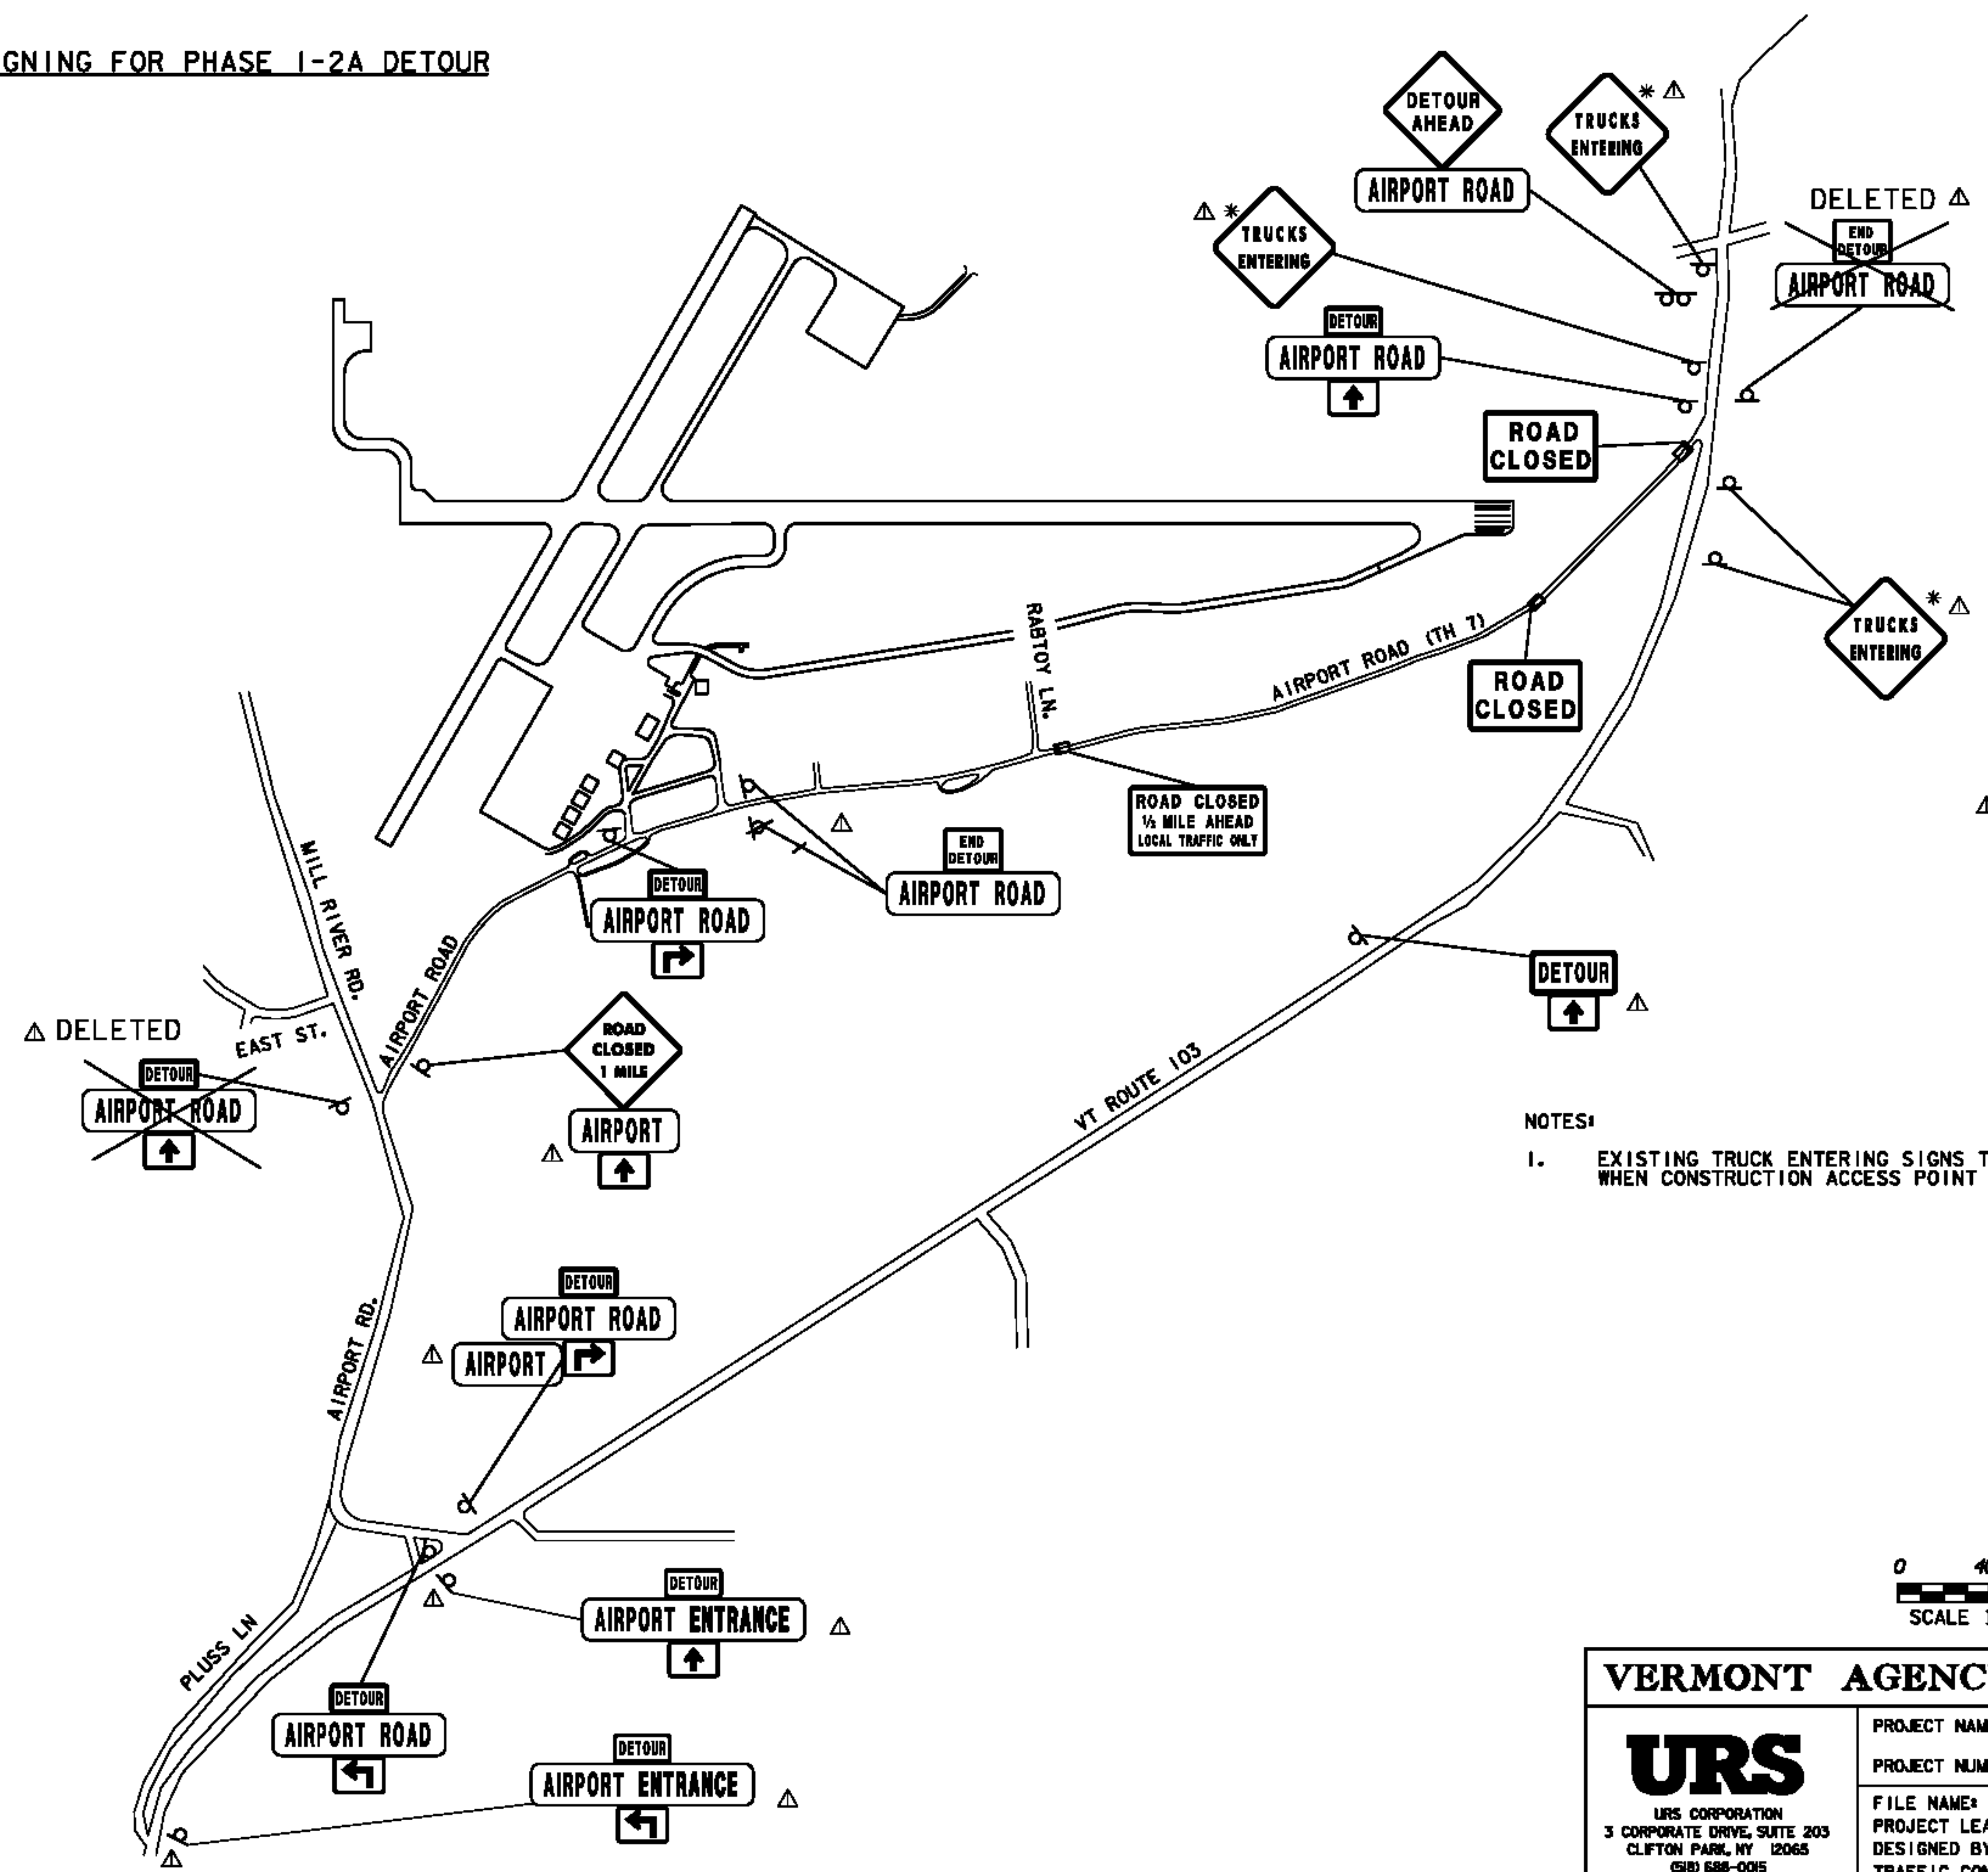

RECORD DRAWING
DECEMBER 27, 2013



△ * "TRUCKS ENTERING" SIGNS WERE UTILIZED ON A DAILY BASIS WHEN NEEDED

- NOTES:
- EXISTING TRUCK ENTERING SIGNS TO REMAIN IN PLACE WHEN CONSTRUCTION ACCESS POINT A IS IN USE.



△ RECORD DRAWING

MP 3-50-0015-34

VERMONT AGENCY OF TRANSPORTATION

URS
URS CORPORATION
3 CORPORATE DRIVE, SUITE 203
CLIFTON PARK, NY 12065
(518) 688-0015

PROJECT NAME: RUTLAND SOUTHERN VERMONT REGIONAL AIRPORT
CLARENDON, VERMONT
PROJECT NUMBER: AV14-8008-300
FILE NAME: z07h124ts_04-RD.dgn
PLOT DATE: 12/30/2013
PROJECT LEADER: F. WALSH
DESIGNED BY: R. ROSS
TRAFFIC CONTROL PLAN (4)
DRAWN BY: R. ROSS
CHECKED BY:
SHEET 20 OF 29

12/30/2013 J:\38397229 RUT RSA 19 Improvements Final Design & CIPhase 1\6.0 CADD\6.1 Plan Sheets\RECORD DRAWINGS\z07h124ts_04-RD.dgn