


**RECORD DRAWING
DECEMBER 27, 2013**

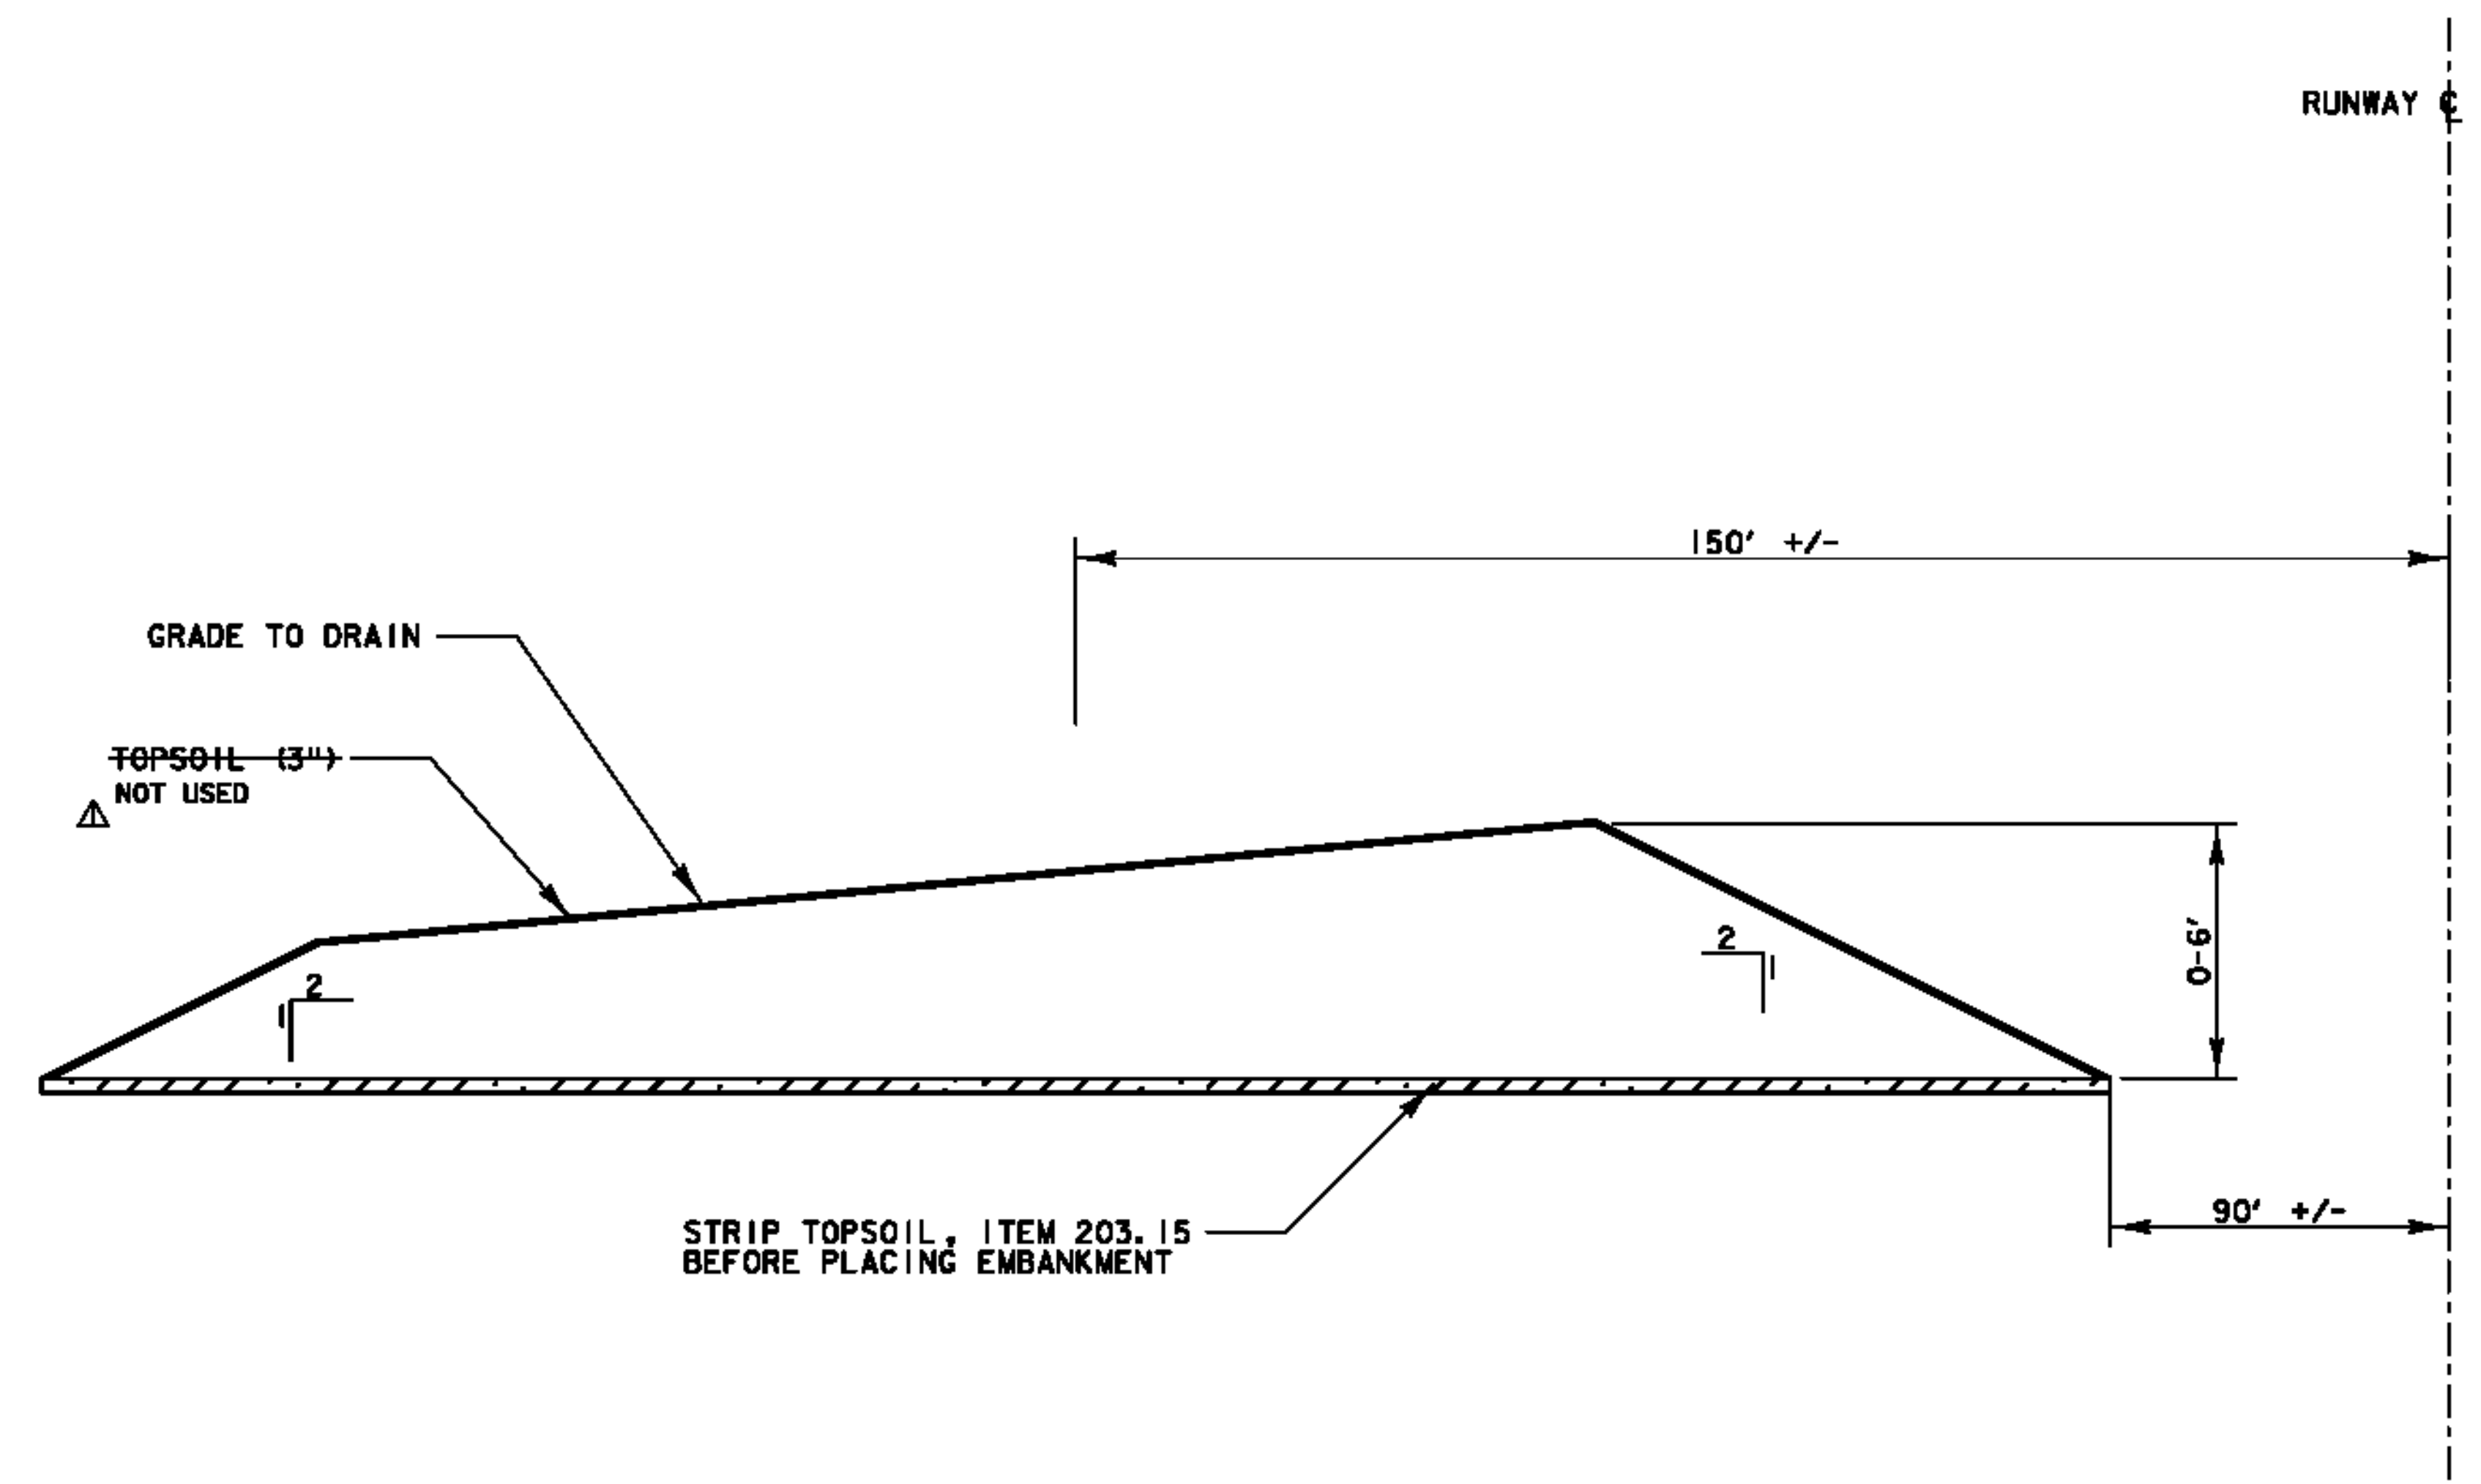

RSA EMBANKMENT (TYPICAL)
NTS


NOTES:

1. CONSTRUCT EMBANKMENT FROM WASTE MATERIAL FROM ROADWAY CONSTRUCTION
2. REFER TO TABLE I (SHEET 28) FOR MATERIAL AND COMPACTION REQUIREMENTS
3. PLACING AND COMPACTIONG EMBANKMENT IS NOT A SEPERATE PAY ITEM, LOSS IS INCIDENTAL TO ITEM 203.15
4. PLACE TOPSOIL (ITEM 651.35) SEED (ITEM 651.15) AND MULCH (ITEM 651.20) ON TOP AND EDGES OF EMBANKMENT TOP & EDGES OF EMBANKMENT WERE HEAVILY MULCHED. NO TOPSOIL OR SEED. Δ
5. CONSTRUCT TEMPORARY EROSION CONTROL MEASURES AS DIRECTED BY THE ENGINEER

Δ RECORD DRAWING

AMP 3-50-0015-34

VERMONT AGENCY OF TRANSPORTATION

 URS CORPORATION 3 CORPORATE DRIVE, SUITE 203 CLIFTON PARK, NY 12065 (518) 688-0015	PROJECT NAME: RUTLAND SOUTHERN VERMONT REGIONAL AIRPORT CLARENDON, VERMONT PROJECT NUMBER: AV14-8008-300
	FILE NAME: z07h124typ_emb_RD.dgn PROJECT LEADER: F. WALSH DESIGNED BY: G. D'AMICO TYPICAL SECTIONS - EMBANKMENT

12/30/2013 J:\38397229 RUT RSA 19 Improvements Final Design & CIPhase \6.0 CADD\6.1 Plan Sheets\RECORD DRAWINGS\z07h124typ_emb_RD.dgn