


12/30/2013 J:\38397229 RUT RSA 19 Improvements Final Design & CIPhase 1\6.0 CADD\6.1 Plan Sheets\RECORD DRAWINGS\z07h124ero_eorss-RD.dgn

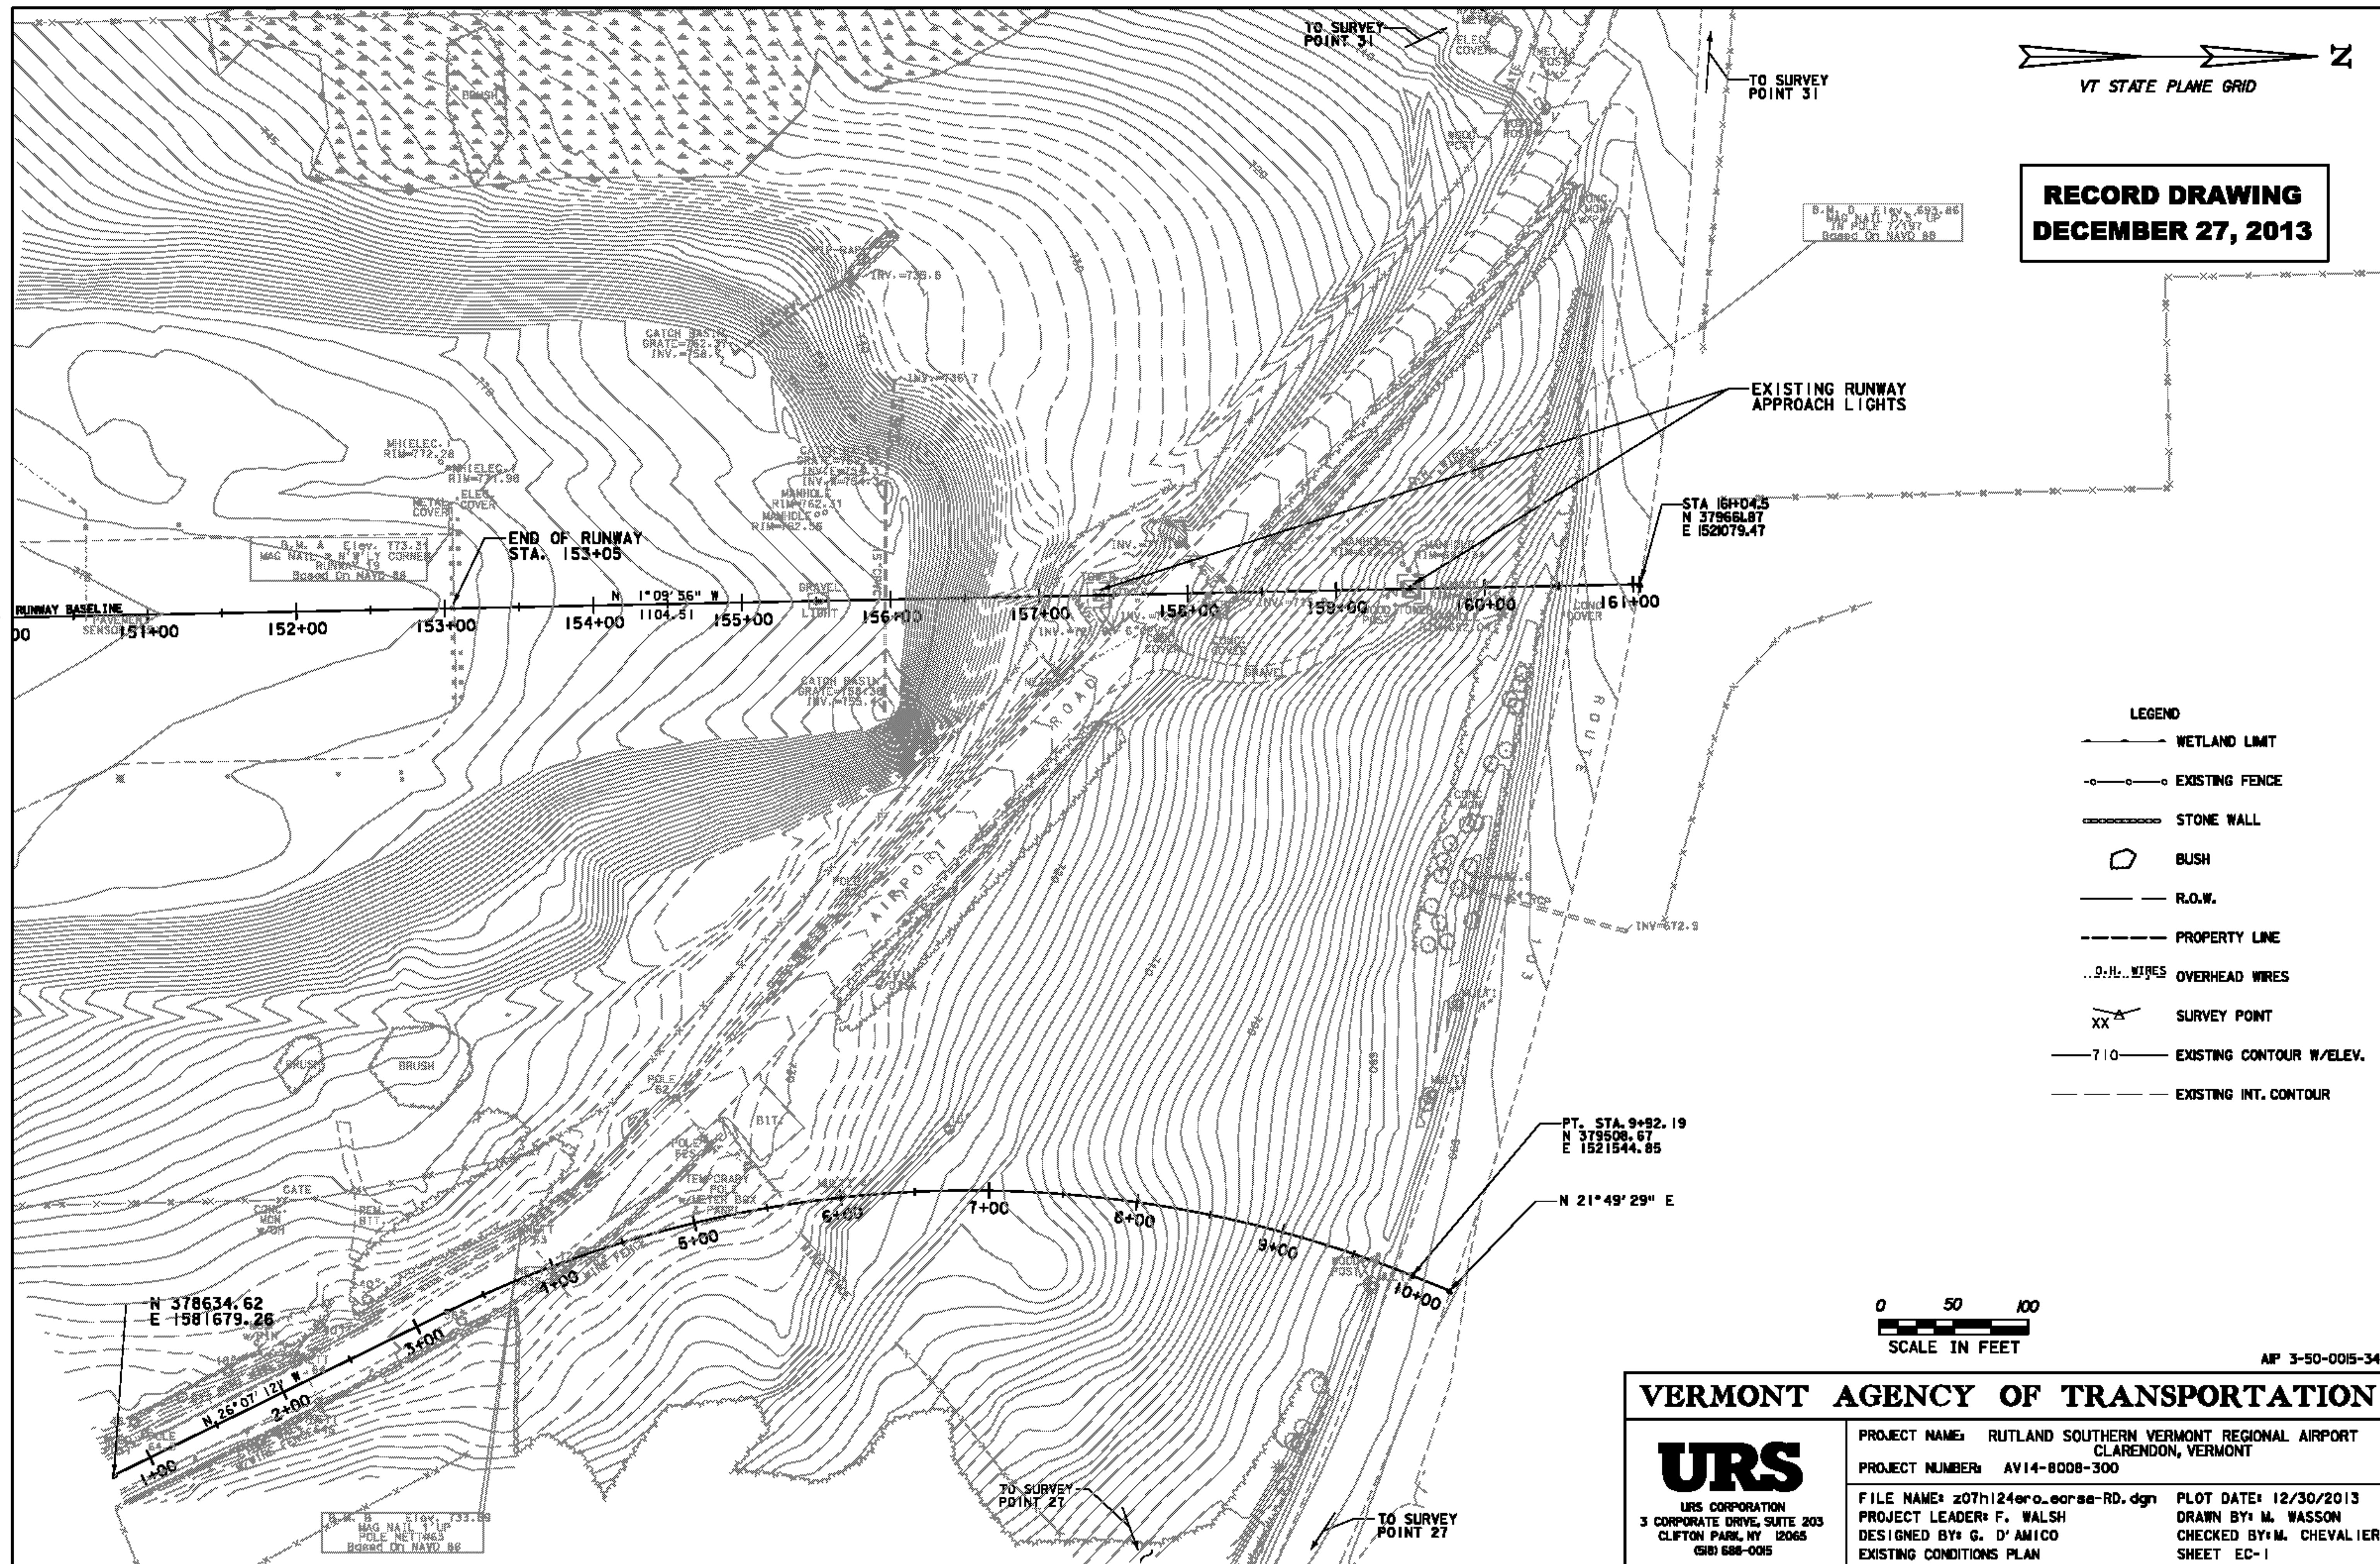

**RECORD DRAWING
DECEMBER 27, 2013**

- LEGEND**
- WETLAND LIMIT
 - - - EXISTING FENCE
 - STONE WALL
 - BUSH
 - R.O.W.
 - - - PROPERTY LINE
 - ... OVERHEAD WIRES
 - XX SURVEY POINT
 - 7-10 — EXISTING CONTOUR W/ELEV.
 - - - EXISTING INT. CONTOUR

VERMONT AGENCY OF TRANSPORTATION

URS
URS CORPORATION
3 CORPORATE DRIVE, SUITE 203
CLIFTON PARK, NY 12065
GRI 688-0015

PROJECT NAME: RUTLAND SOUTHERN VERMONT REGIONAL AIRPORT
CLARENDON, VERMONT
PROJECT NUMBER: AV14-8008-300
FILE NAME: z07h124ero_eorss-RD.dgn
DESIGNED BY: G. D'AMICO
EXISTING CONDITIONS PLAN

PLOT DATE: 12/30/2013
DRAWN BY: M. WASSON
CHECKED BY: M. CHEVALIER
SHEET EC-1

AP 3-50-0015-34