 



ENVIRONMENTAL RESOURCE	LEVEL	LINestyle NAME	CHECKED BY	DATE
WETLANDS	EWS	WETLANDS-LT	FHA	05-22-07
HISTORIC/HISTORIC DISTRICT	MHBC	PHANTOM	HAA	10-17-06
ARCHEAOLOGICAL SITE	NONE	NONE	HAA	10-17-06
4F PROPERTY	NONE	NONE	HTA	09-16-06
6F PROPERTY	NONE	NONE	HTA	09-16-06
AGRICULTURAL LAND	EDEFAULT	AGRICULT. LAND	HTA	09-16-06
FISH & WILDLIFE HABITAT	NONE	NONE	FHI	05-22-07
FLOOD PLAINS	DELB-P	FLD. PLAINS	HTA	03-05-07
ENDANGERED SPECIES	NONE	NONE	FHI	05-22-07
HAZARDOUS WASTE	NONE	NONE	HTA	11-30-06
STORMWATER	NONE	NONE	HTA	08-02-07
GREEN MOUNTAIN NATIONAL FOREST LAND	NONE	NONE	HTA	10-16-06



CONTRACTOR SHALL PROVIDE FREE ACCESS FOR OWNER TO MOW GRASSED AREA PRIOR TO APRIL 15 AND KEEP GRASS AT 4" HIGH MAXIMUM UNTIL AUGUST 1ST EACH YEAR

NOTE:
1. See EPSC plans for erosion control measures and protection of resources

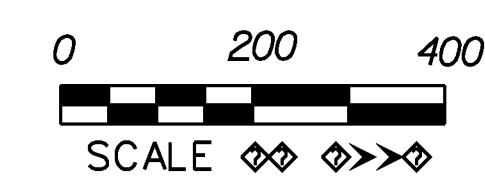

RESOURCE SHEET

Hoyle, Tanner & Associates, Inc.
 150 Dow Street
 Manchester, NH 03101-1227
 Tel 603-669-5555
 Fax 603-669-4168
 Web Page: www.hoyletanner.com
Hoyle, Tanner & Associates © 2008

PROJECT NAME: E.F. KNAPP STATE AIRPORT
 A.I.P. 3-50-0001-011-2009
 PROJECT NUMBER: BERLIN AIR 04-3216
 FILE NAME: 302803_sht_res.dgn
 PROJECT LEADER: S. FORTNEY
 DESIGNED BY: S. BOUCHARD
 RESOURCE SHEET
 PLOT DATE: 11/22/2011
 DRAWN BY: D. STANDISH
 CHECKED BY: J. DOWNAR
 SHEET 7 OF 173