
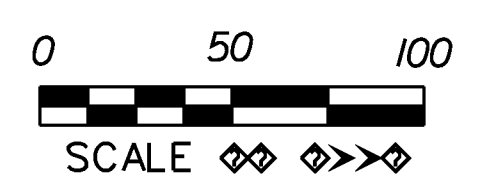


**LEGEND**

- WORK AREA
- PROPOSED PAVEMENT
- EXISTING WETLANDS
- SYMBOL
- EXISTING DRAIN PIPE
- EXISTING UNDERDRAIN
- EXISTING CB
- STABILIZED CONSTRUCTION ENTRANCE
- PROPOSED CB
- PROPOSED DRAIN PIPE
- PROPOSED UNDERDRAIN CLEANOUT
- PROPOSED UNDERDRAIN
- SLOPE LIMITS
- LIGHTED BARRICADE
- RIP RAP

NOTE:  
 PROPOSED ALIGNMENTS  
 SHOWN FOR GUIDANCE ONLY.  
 SEE GEOMETRY SHEETS 1-7.

WORK AREA 2A SAFETY PLAN  
 SHEETS 1, 2, 6 AND 7 NOT USED

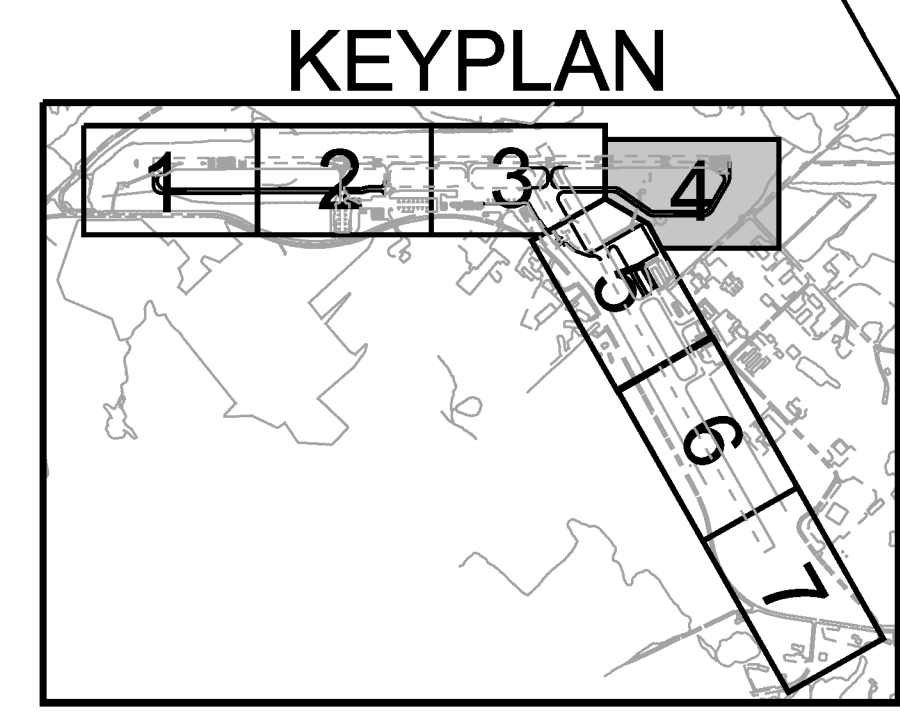

**WORK AREA 2A**

**Hoyle, Tanner & Associates, Inc.**  
 150 Dow Street  
 Manchester, NH 03101-1227  
 Tel 603-669-5555  
 Fax 603-669-4168  
 Web Page: [www.hoyletanner.com](http://www.hoyletanner.com)  
Hoyle Tanner & Associates © 2008

PROJECT NAME: E. F. KNAPP STATE AIRPORT	PLOT DATE: 11/22/2011
A.I.P. 3-50-0001-011-2009	DRAWN BY: D. STANDISH
PROJECT NUMBER: BERLIN AIR 04-3216	CHECKED BY: J. DOWNAR
FILE NAME: z05h378sht.ph.dgn	WORK AREA 2A SHT 4
	SHEET 15 OF 173