
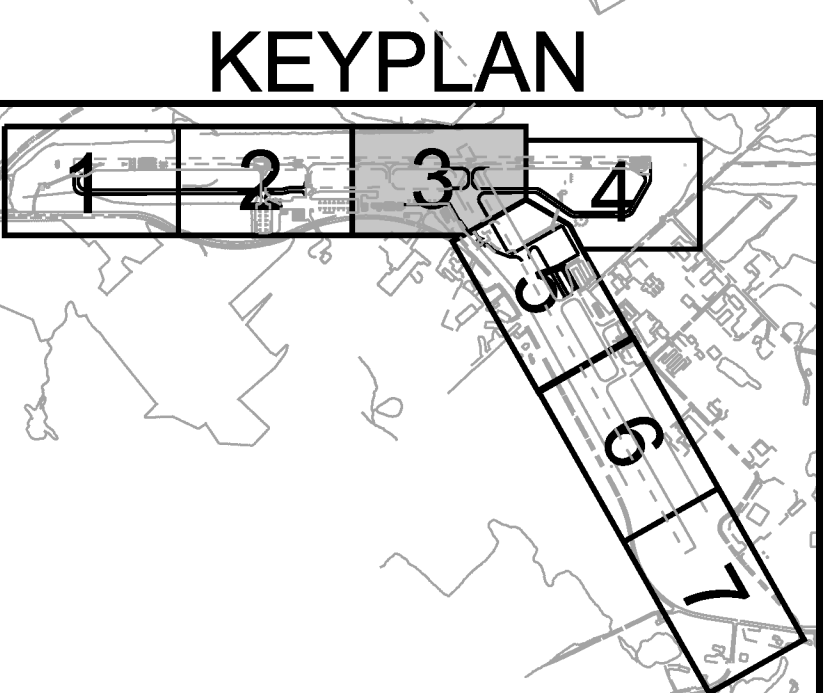


LEGEND

- | | | | |
|--|----------------------------------|--|------------------------------|
| | WORK AREA | | PROPOSED CB |
| | PROPOSED PAVEMENT | | PROPOSED DRAIN PIPE |
| | EXISTING WETLANDS | | PROPOSED UNDERDRAIN CLEANOUT |
| | EXISTING DRAIN PIPE | | PROPOSED UNDERDRAIN |
| | EXISTING UNDERDRAIN | | SLOPE LIMITS |
| | EXISTING CB | | LIGHTED BARRICADE |
| | STABILIZED CONSTRUCTION ENTRANCE | | RIP RAP |

NOTE:

PROPOSED ALIGNMENTS SHOWN FOR GUIDANCE ONLY. SEE GEOMETRY SHEETS 1-7.
 WORK AREA 2E SAFETY PLAN SHEETS 1, 2, 4, 6 AND 7 NOT USED

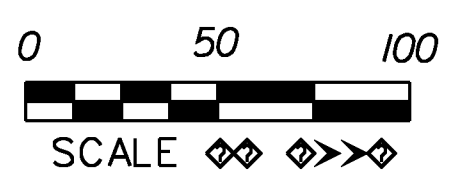

Hoyle, Tanner & Associates, Inc.
 150 Dow Street
 Manchester, NH 03101-1227
 Tel 603-669-5555
 Fax 603-669-4168
 Web Page: www.hoyletanner.com
Hoyle, Tanner & Associates © 2008

WORK AREA 2E	
PROJECT NAME: E. F. KNAPP STATE AIRPORT	
A.I.P. 3-50-0001-011-2009	
PROJECT NUMBER: BERLIN AIR 04-3216	
FILE NAME: z05h378shf.ph.dgn	PLOT DATE: 11/22/2011
PROJECT LEADER: S. FORTNEY	DRAWN BY: D. STANDISH
DESIGNED BY: S. BOUCHARD	CHECKED BY: J. DOWNAR
WORK AREA 2E SHT 3	SHEET 21 OF 173