


CONSTRUCT SUPPLEMENTAL WIND CONE
 STA. 115+00.0
 RT. 250.0'
 REFER TO ELECTRICAL
 DETAIL SHEET 4

\$(PHASING3_5)

\$(PHASING3_7)

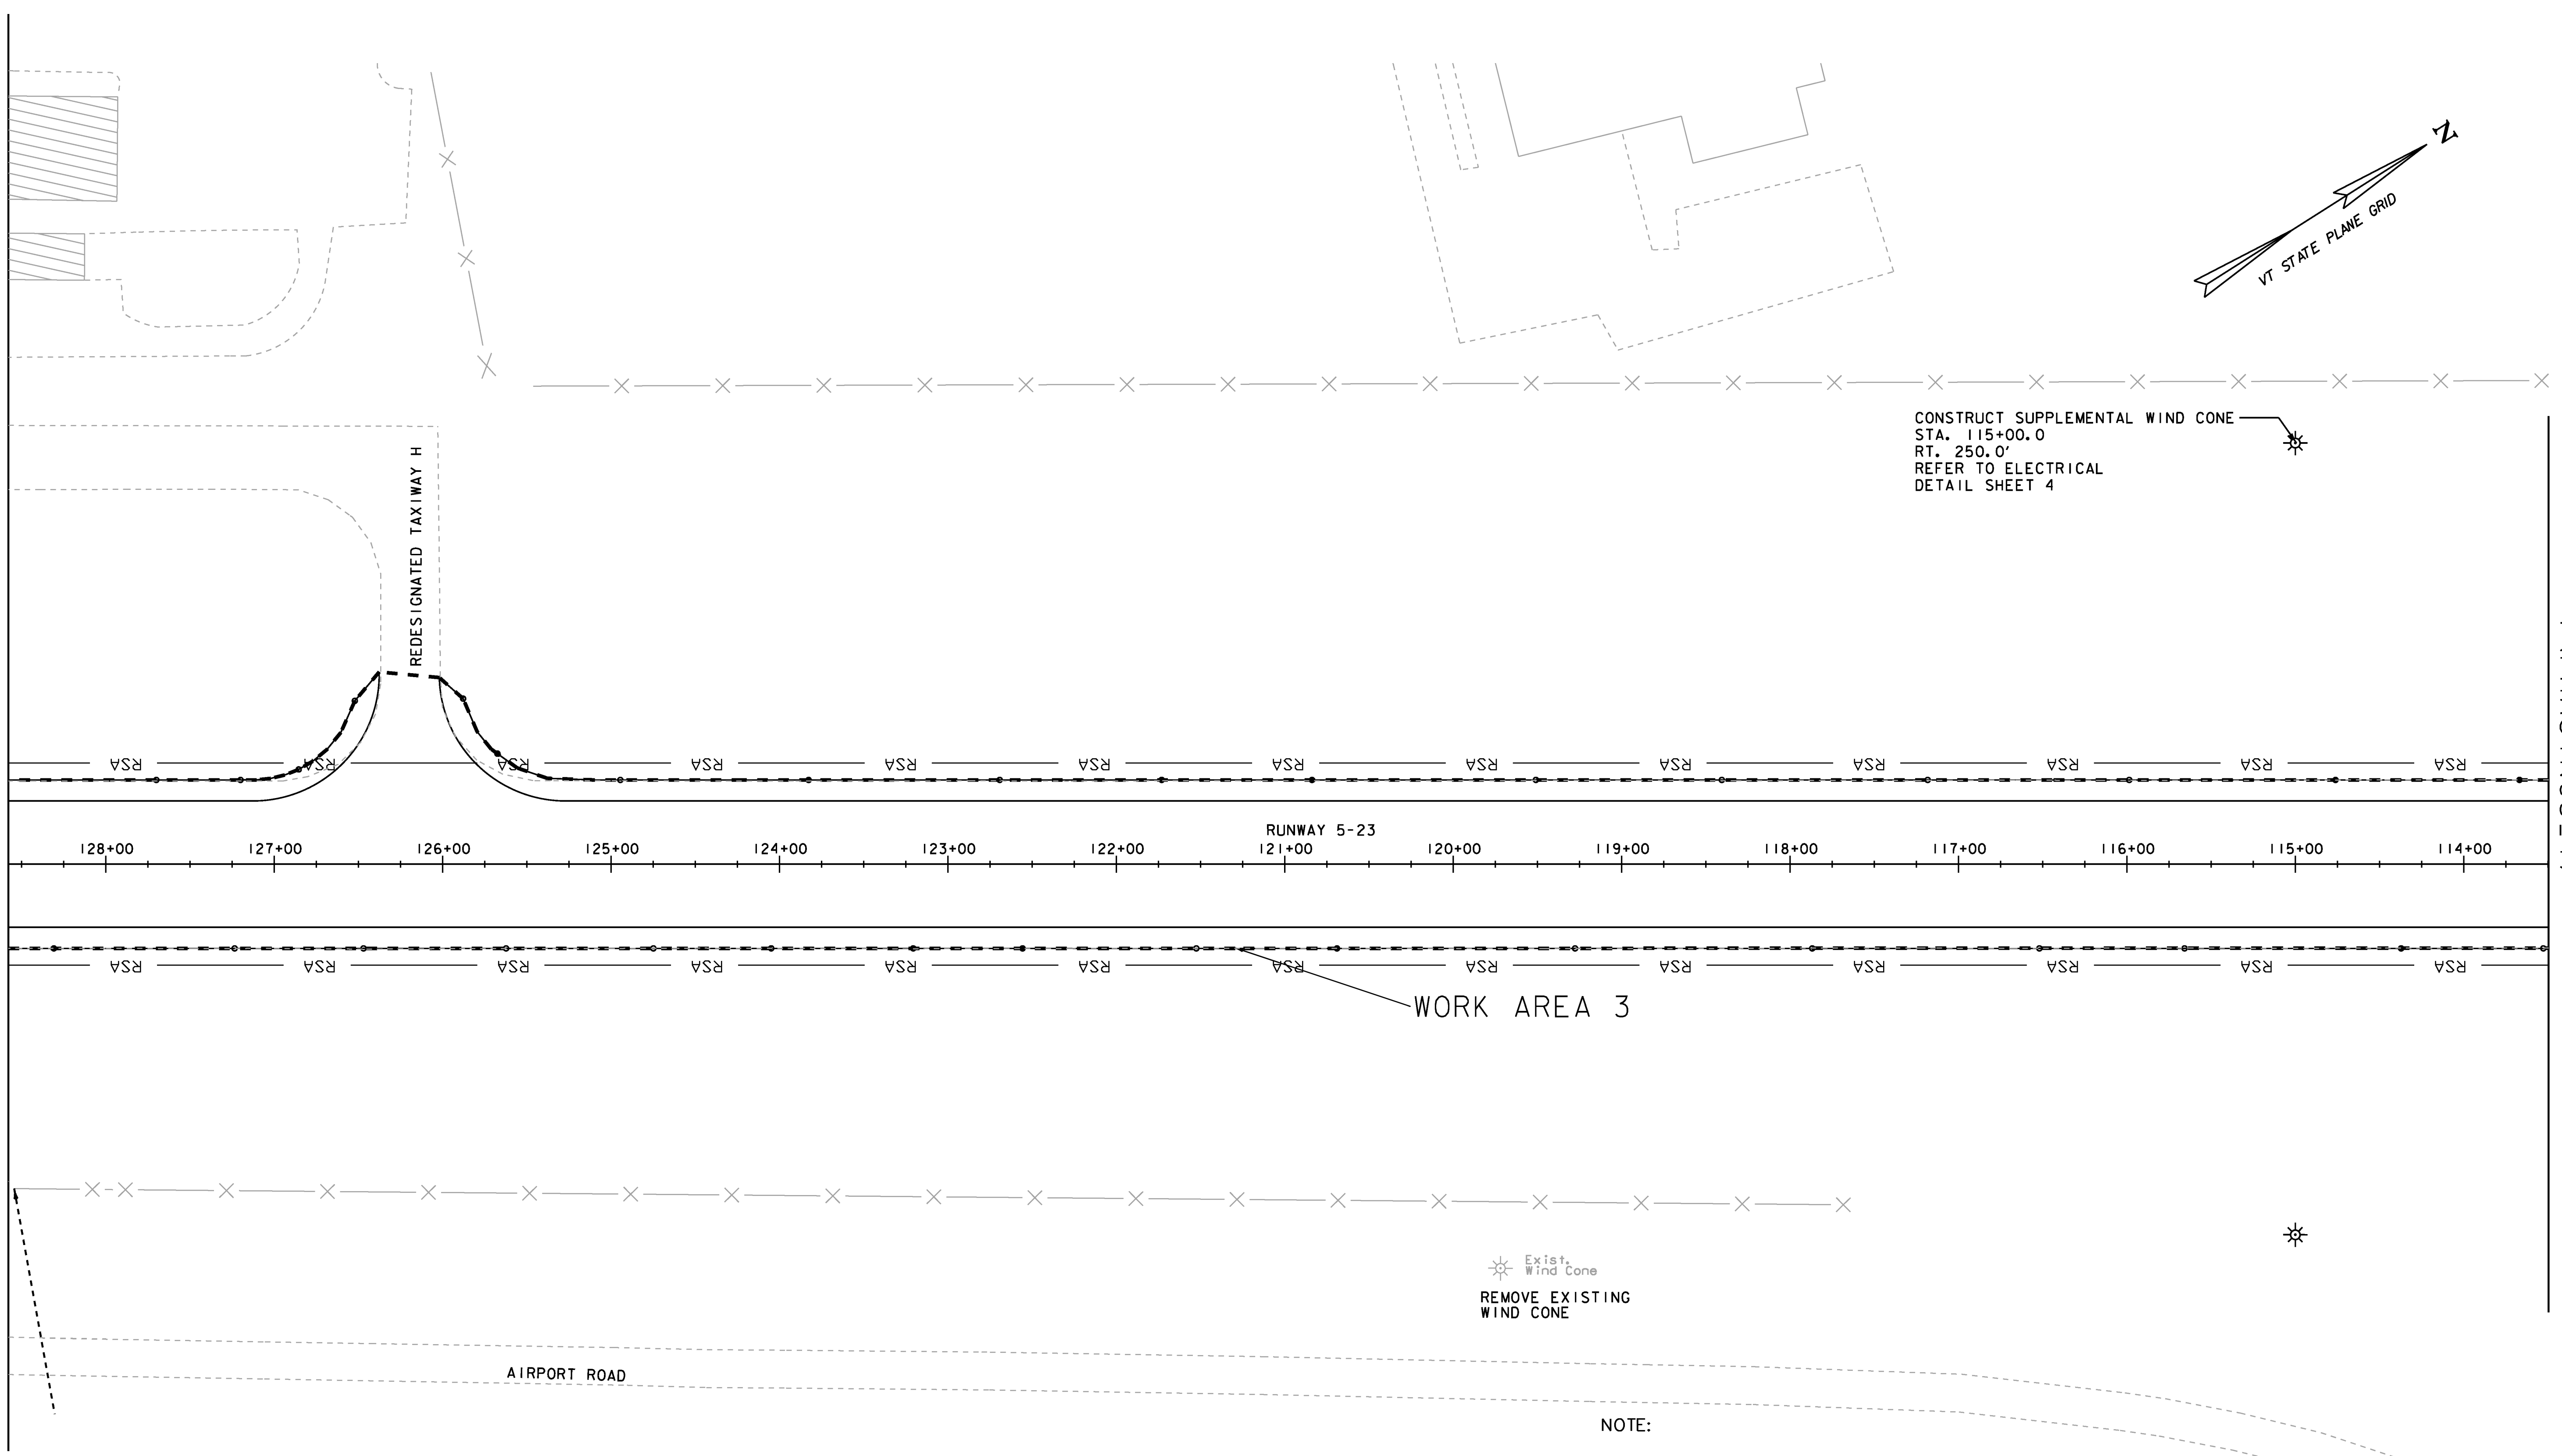


Exist. Wind Cone
 REMOVE EXISTING WIND CONE

NOTE:
 PROPOSED ALIGNMENTS
 SHOWN FOR GUIDANCE ONLY.
 SEE GEOMETRY SHEETS 1-7.
 WORK AREA 3 SAFETY PLAN
 SHEETS 1, 2, 3 AND 4 NOT USED


WORK AREA 3

LEGEND

- | | | | |
|--|----------------------------------|--|------------------------------|
| | WORK AREA | | PROPOSED CB |
| | PROPOSED PAVEMENT | | PROPOSED DRAIN PIPE |
| | EXISTING WETLANDS SYMBOL | | PROPOSED UNDERDRAIN CLEANOUT |
| | EXISTING DRAIN PIPE | | PROPOSED UNDERDRAIN |
| | EXISTING UNDERDRAIN | | SLOPE LIMITS |
| | EXISTING CB | | LIGHTED BARRICADE |
| | STABILIZED CONSTRUCTION ENTRANCE | | RIP RAP |

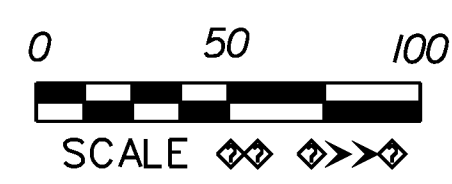

KEYPLAN

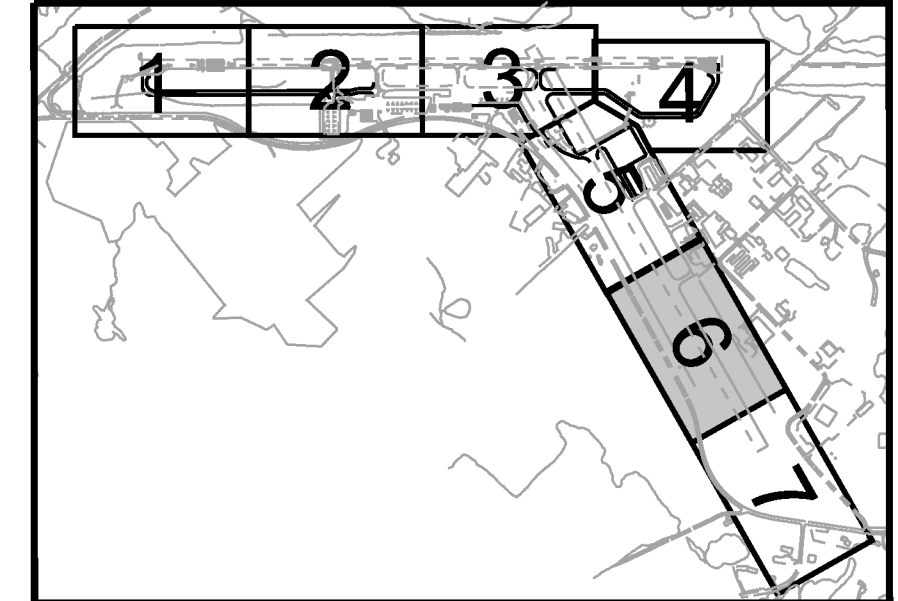

Hoyle, Tanner & Associates, Inc.
 150 Dow Street
 Manchester, NH 03101-1227
 Tel 603-669-5555
 Fax 603-669-4168
 Web Page: www.hoyletanner.com
Hoyle Tanner & Associates © 2008

PROJECT NAME: E. F. KNAPP STATE AIRPORT	
A.I.P. 3-50-0001-011-2009	
PROJECT NUMBER: BERLIN AIR 04-3216	
FILE NAME: z05h378shf.ph.dgn	PLOT DATE: 11/22/2011
PROJECT LEADER: S. FORTNEY	DRAWN BY: D. STANDISH
DESIGNED BY: S. BOUCHARD	CHECKED BY: J. DOWNAR
WORK AREA 3 SHT 6	SHEET 27 OF 173