

**CONSTRUCTION SIGN SUMMARY**


LOCATION	ERW	SRWA	SRW500	TV300
<b>AIRPORT ROAD</b>				
NORTH OF ACCESS RD	1	2	2	1
SOUTH OF ACCESS RD	0	0	2	1
<b>COMSTOCK ROAD</b>				
EAST OF ACCESS RD	1	0	2	1
WEST OF ACCESS RD	1	0	2	1
<b>GRANGER ROAD</b>				
NORTH OF ACCESS RD	1	0	2	0
SHEET TOTAL	4	2	10	4
PROJECT TOTAL	6	2	16	6

**LEGEND**

- ERW = END ROAD WORK
- SRWA = SIDE ROAD WORK AHEAD
- SRW500 = SIDE ROAD WORK 500 FT
- TV300 = TURNING VEHICLES 300 FEET

**NOTES:**

1. SEE VTRANS STANDARDS E-100A, E-102A FOR SIGN PLACEMENT.
2. ALL DIAMOND SHAPED SIGNS SHALL BE 48" AND INSTALLED ON TWO POSTS EACH.
3. ALL CONSTRUCTION SIGNS SHALL BE NEW OR LIKE-NEW CONDITION.
4. SEE VTRANS STANDARDS FOR SIGN SHEETING REQUIREMENTS.
5. WORK ZONE SIGNS SHALL NOT OBSCURE EXISTING TRAFFIC CONTROL DEVICES.
6. CONSTRUCTION SIGNING WILL BE INCIDENTAL TO THE PROJECT.

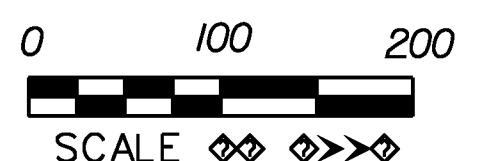

**Hoyle, Tanner & Associates, Inc.**  
 150 Dow Street  
 Manchester, NH 03101-1227  
 Tel 603-669-5555  
 Fax 603-669-4168  
 Web Page: [www.hoyletanner.com](http://www.hoyletanner.com)  
Hoyle Tanner & Associates © 2008

PROJECT NAME: E. F. KNAPP STATE AIRPORT  
 A.I.P. 3-50-0001-011-2009  
 PROJECT NUMBER: BERLIN AIR 04-3216

FILE NAME: z05h378sh.t. ts. dgn  
 PROJECT LEADER: S. FORTNEY  
 DESIGNED BY: S. BOUCHARD  
 CONSTRUCTION APPROACH SIGNING SHT 2

PLOT DATE: 11/22/2011  
 DRAWN BY: D. STANDISH  
 CHECKED BY: J. DOWNAR  
 SHEET 30 OF 173