
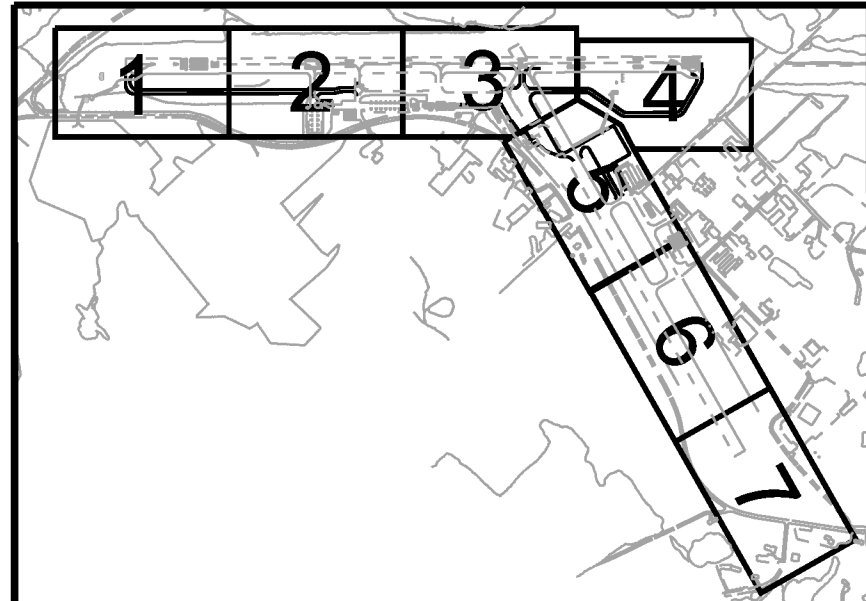


\$ (EPSC-EX2)

NOTE:
 PROPOSED ALIGNMENTS
 SHOWN FOR GUIDANCE ONLY.
 SEE GEOMETRY SHEETS 1-7.

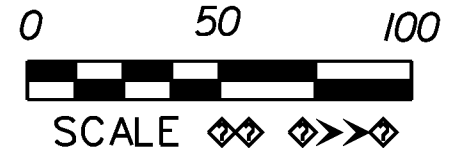

EPSC EXISTING CONDITIONS SITE PLAN

PROJECT NAME: E.F. KNAPP STATE AIRPORT
 A.I.P. 3-50-0001-011-2009
 PROJECT NUMBER: BERLIN AIR 04-3216
 FILE NAME: z05h378sh.t.EPSCex.dgn
 PROJECT LEADER: S. FORTNEY
 DESIGNED BY: S. BOUCHARD
 EPSC EXISTING CONDITIONS SITE PLAN

PLOT DATE: 11/22/2011
 DRAWN BY: D. STANDISH
 CHECKED BY: J. DOWNAR
 SHEET 34 OF 173

Hoyle, Tanner & Associates, Inc.
 150 Dow Street
 Manchester, NH 03101-1227
 Tel 603-669-5555
 Fax 603-669-4168
 Web Page: www.hoyletanner.com
Hoyle Tanner & Associates © 2008