


NOTE:  
 PROPOSED ALIGNMENTS  
 SHOWN FOR GUIDANCE ONLY.  
 SEE GEOMETRY SHEETS 1-7.

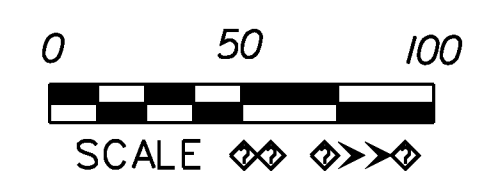

**Hoyle, Tanner & Associates, Inc.**  
 150 Dow Street  
 Manchester, NH 03101-1227  
 Tel 603-669-5555  
 Fax 603-669-4168  
 Web Page: [www.hoyletanner.com](http://www.hoyletanner.com)  
Hoyle, Tanner & Associates © 2008

**EPSC EXISTING CONDITIONS SITE PLAN**

PROJECT NAME: E.F. KNAPP STATE AIRPORT  
 A.I.P. 3-50-0001-011-2009  
 PROJECT NUMBER: BERLIN AIR 04-3216  
 FILE NAME: z05h378shf.EPSCex.dgn  
 PROJECT LEADER: S. FORTNEY  
 DESIGNED BY: S. BOUCHARD  
 EPSC EXISTING CONDITIONS SITE PLAN

PLOT DATE: 11/22/2011  
 DRAWN BY: D. STANDISH  
 CHECKED BY: J. DOWNAR  
 SHEET 37 OF 173