
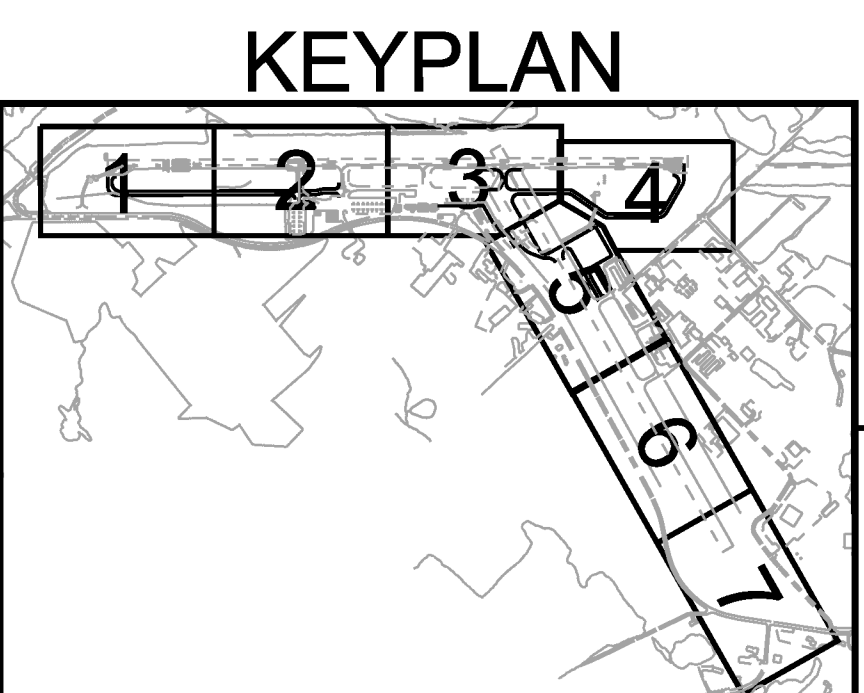


NOTE:
PROPOSED ALIGNMENTS
SHOWN FOR GUIDANCE ONLY.
SEE GEOMETRY SHEETS 1-7.

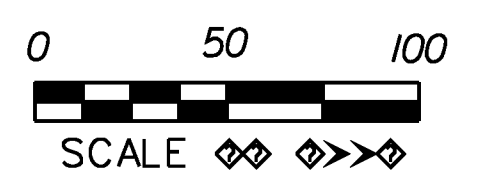

Hoyle, Tanner & Associates, Inc.

150 Dow Street
Manchester, NH 03101-1227
Tel 603-669-5555
Fax 603-669-4168
Web Page: www.hoyletanner.com
Hoyle, Tanner & Associates © 2008

EPSC EXISTING CONDITIONS SITE PLAN

PROJECT NAME: E. F. KNAPP STATE AIRPORT	
A.I.P. 3-50-0001-011-2009	
PROJECT NUMBER: BERLIN AIR 04-3216	
FILE NAME: z05h378shf.EPSCex.dgn	PLOT DATE: 11/22/2011
PROJECT LEADER: S. FORTNEY	DRAWN BY: D. STANDISH
DESIGNED BY: S. BOUCHARD	CHECKED BY: J. DOWNAR
EPSC EXISTING CONDITIONS SITE PLAN	SHEET 39 OF 173